


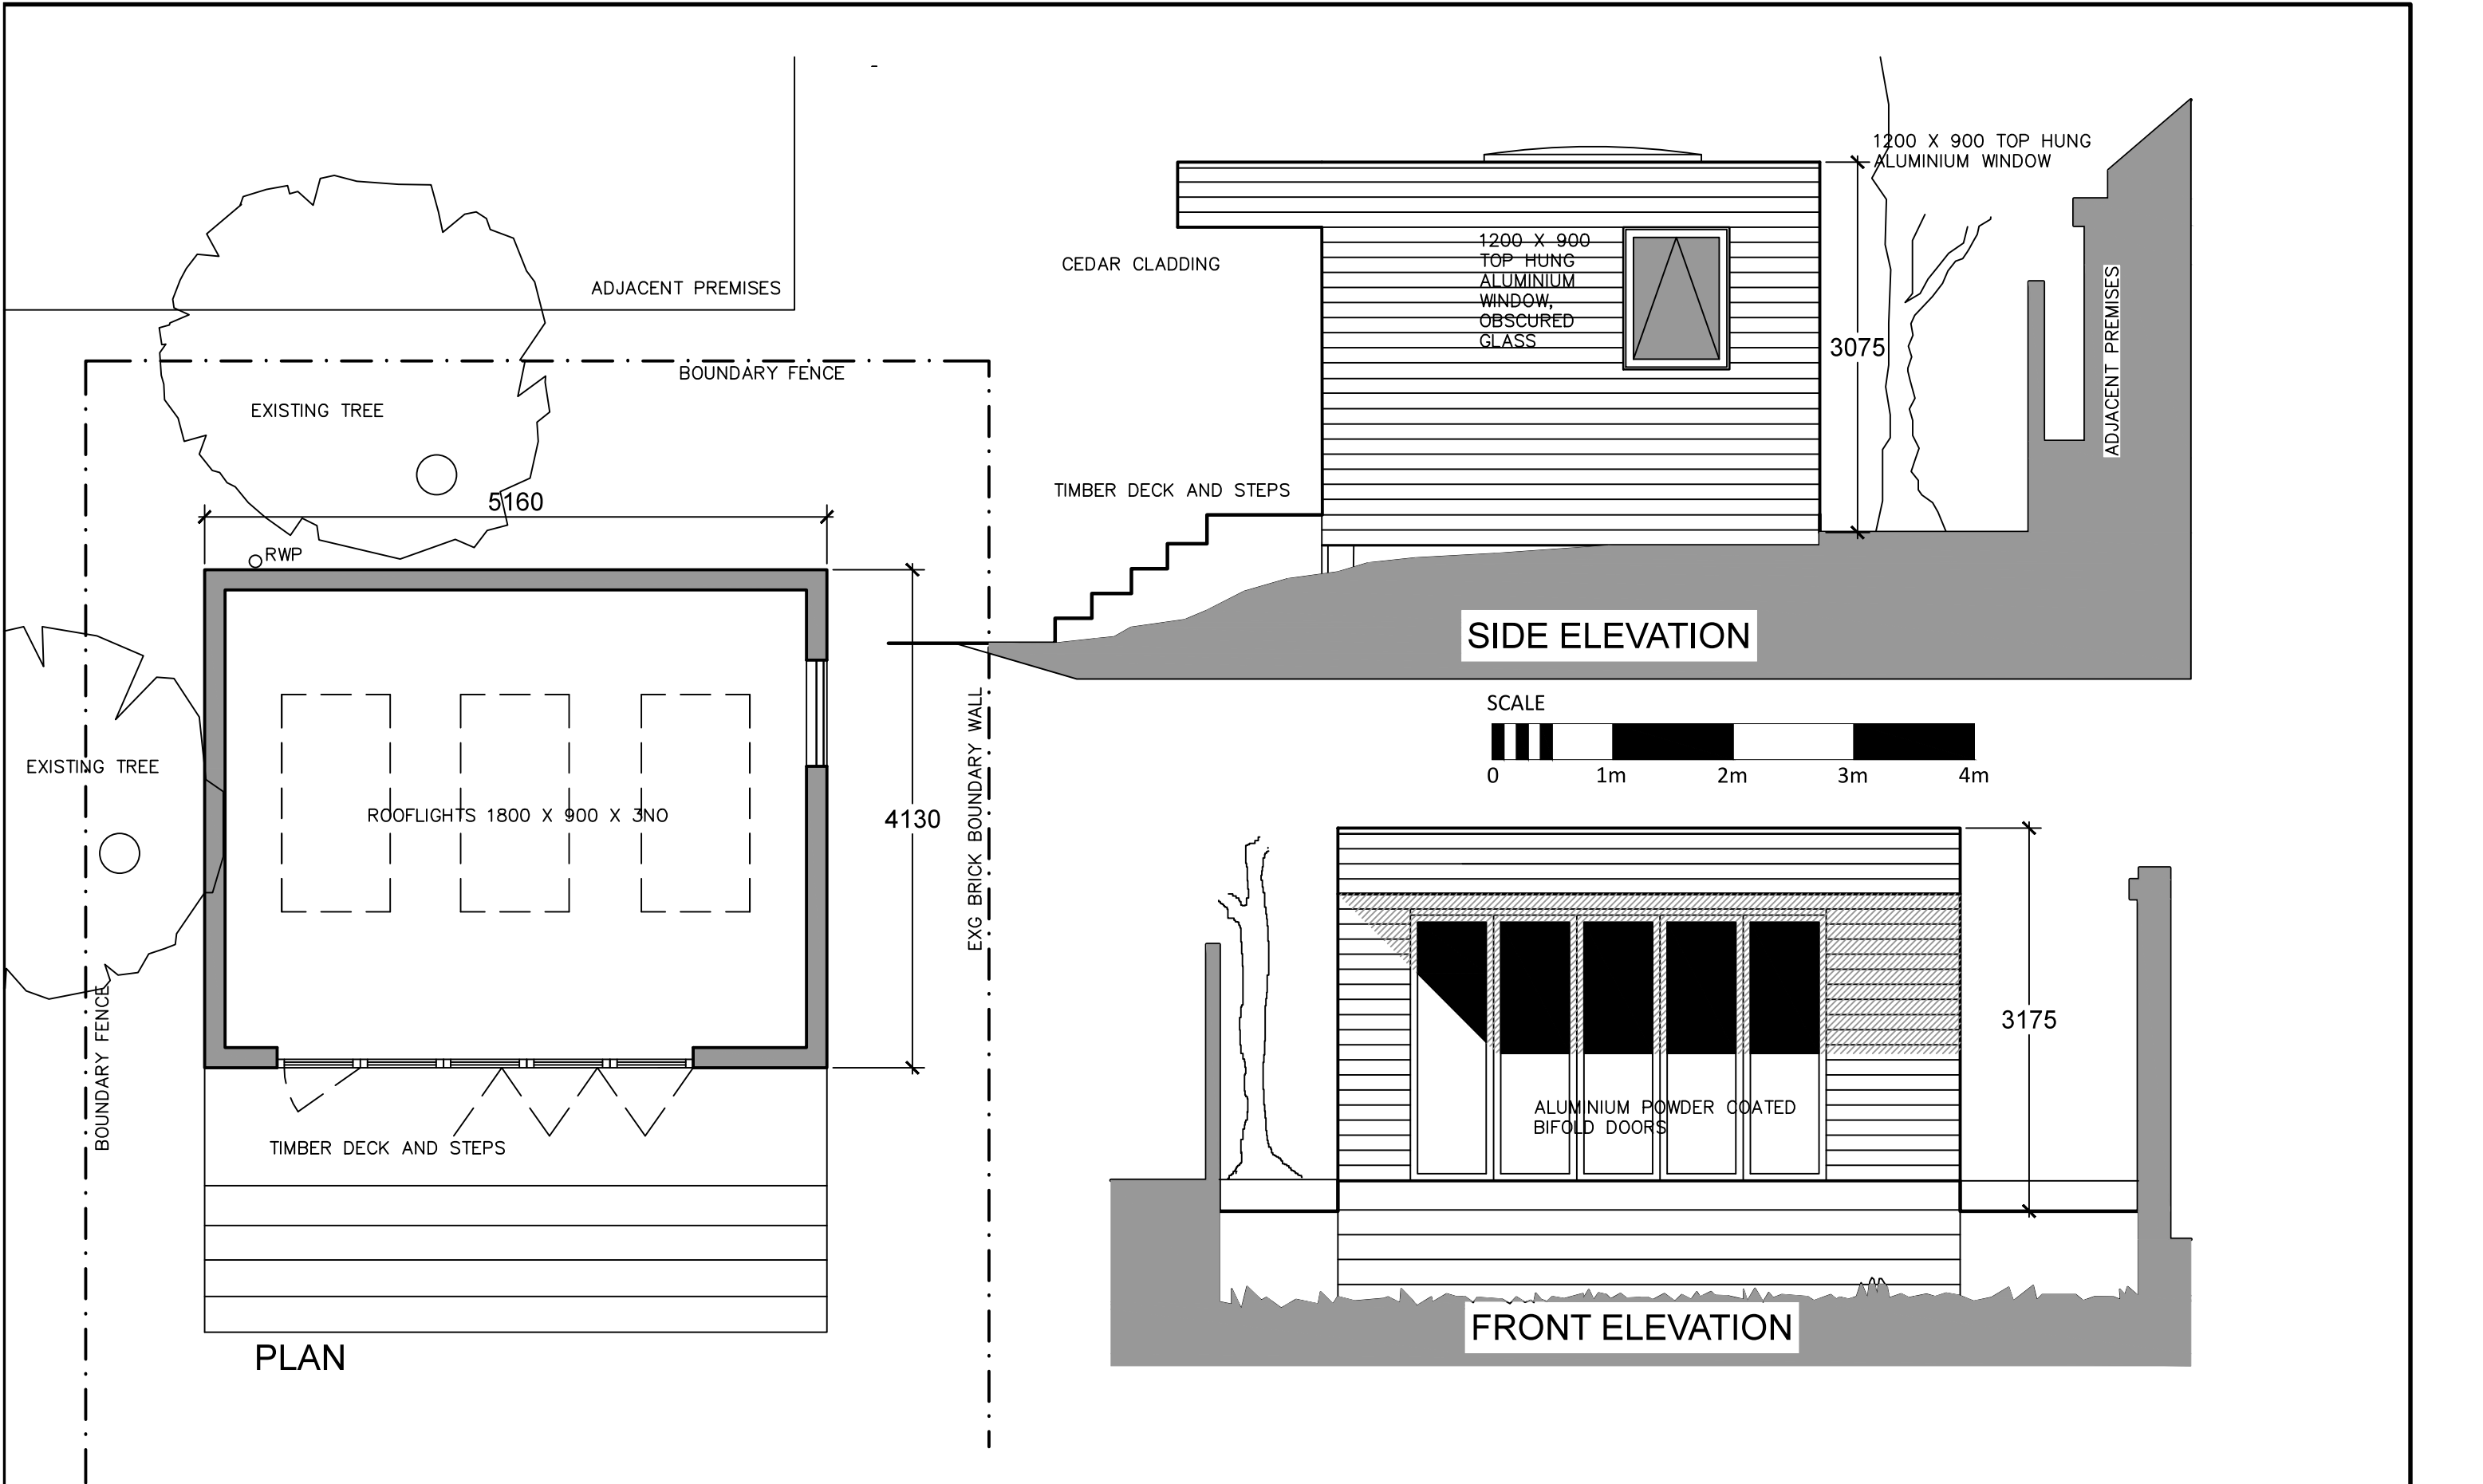

Revision notes:			Client		Job No	Drawing No	Revision	Status	RICHARD WALLIS ASSOCIATES RIBA CHARTERED ARCHITECTS AND PROJECT MANAGERS Unit 5b, 20-30 Wild's Rents, London SE1 4QG E: mail@rwallis.com T: +44 (0)20 7403 8869 Richard Wallis Associates is a trading name of Richard Wallis Ltd. Company Registered in England no 6398653	
Rev:	Date:	Notes:	N FARHI		273	001	A	P		
			Project:		Title		Drawn By	Date		
			94 FROGNAL NW2 – GARDEN ROOM		PLAN & ELEVATIONS AS BUILT		RW	DEC 14		
							Approved By	Scale		
							RJW	1:50@A3		