


WG 3  
 BEFORE  
 PENDING FIRE ESCAPE  
 STAIRWAY INSTALLATION

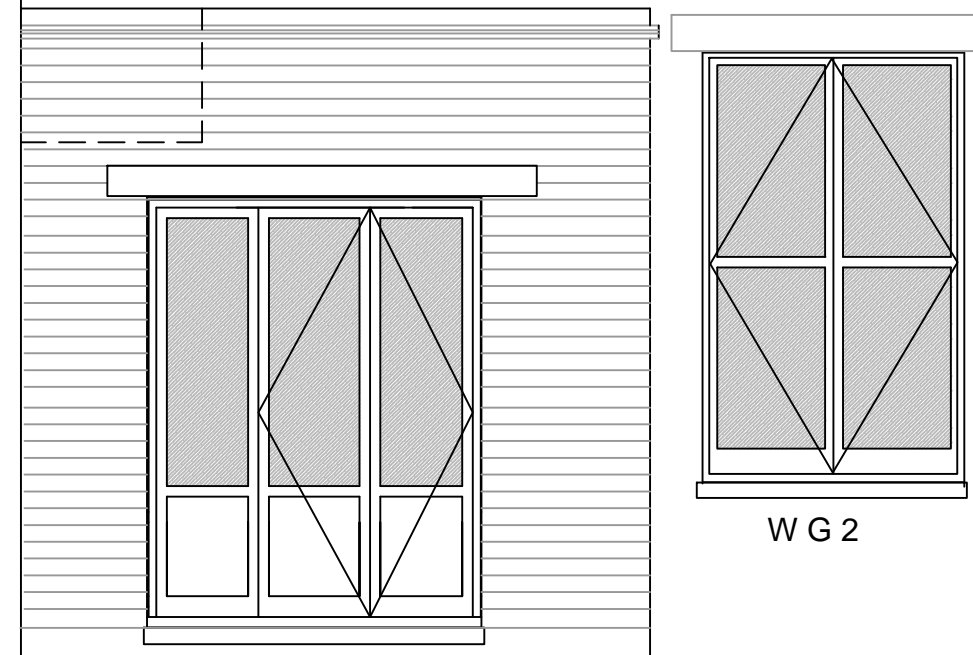

WG 3  
 AS BUILT  
 PENDING  
 STAIRWAY INSTALLATION

Notes

Project  
 4 ST GEORGES TERRACE  
 NW1 8HX

Drawing Title  
 REAR ELEVATION

Scale  
 1: 50 @ A3  
 Date  
 FEB 2015

Drawing No.  
**C/606**