


NOTES

1. Declutter and remove rubbish from unused 3rd floor.

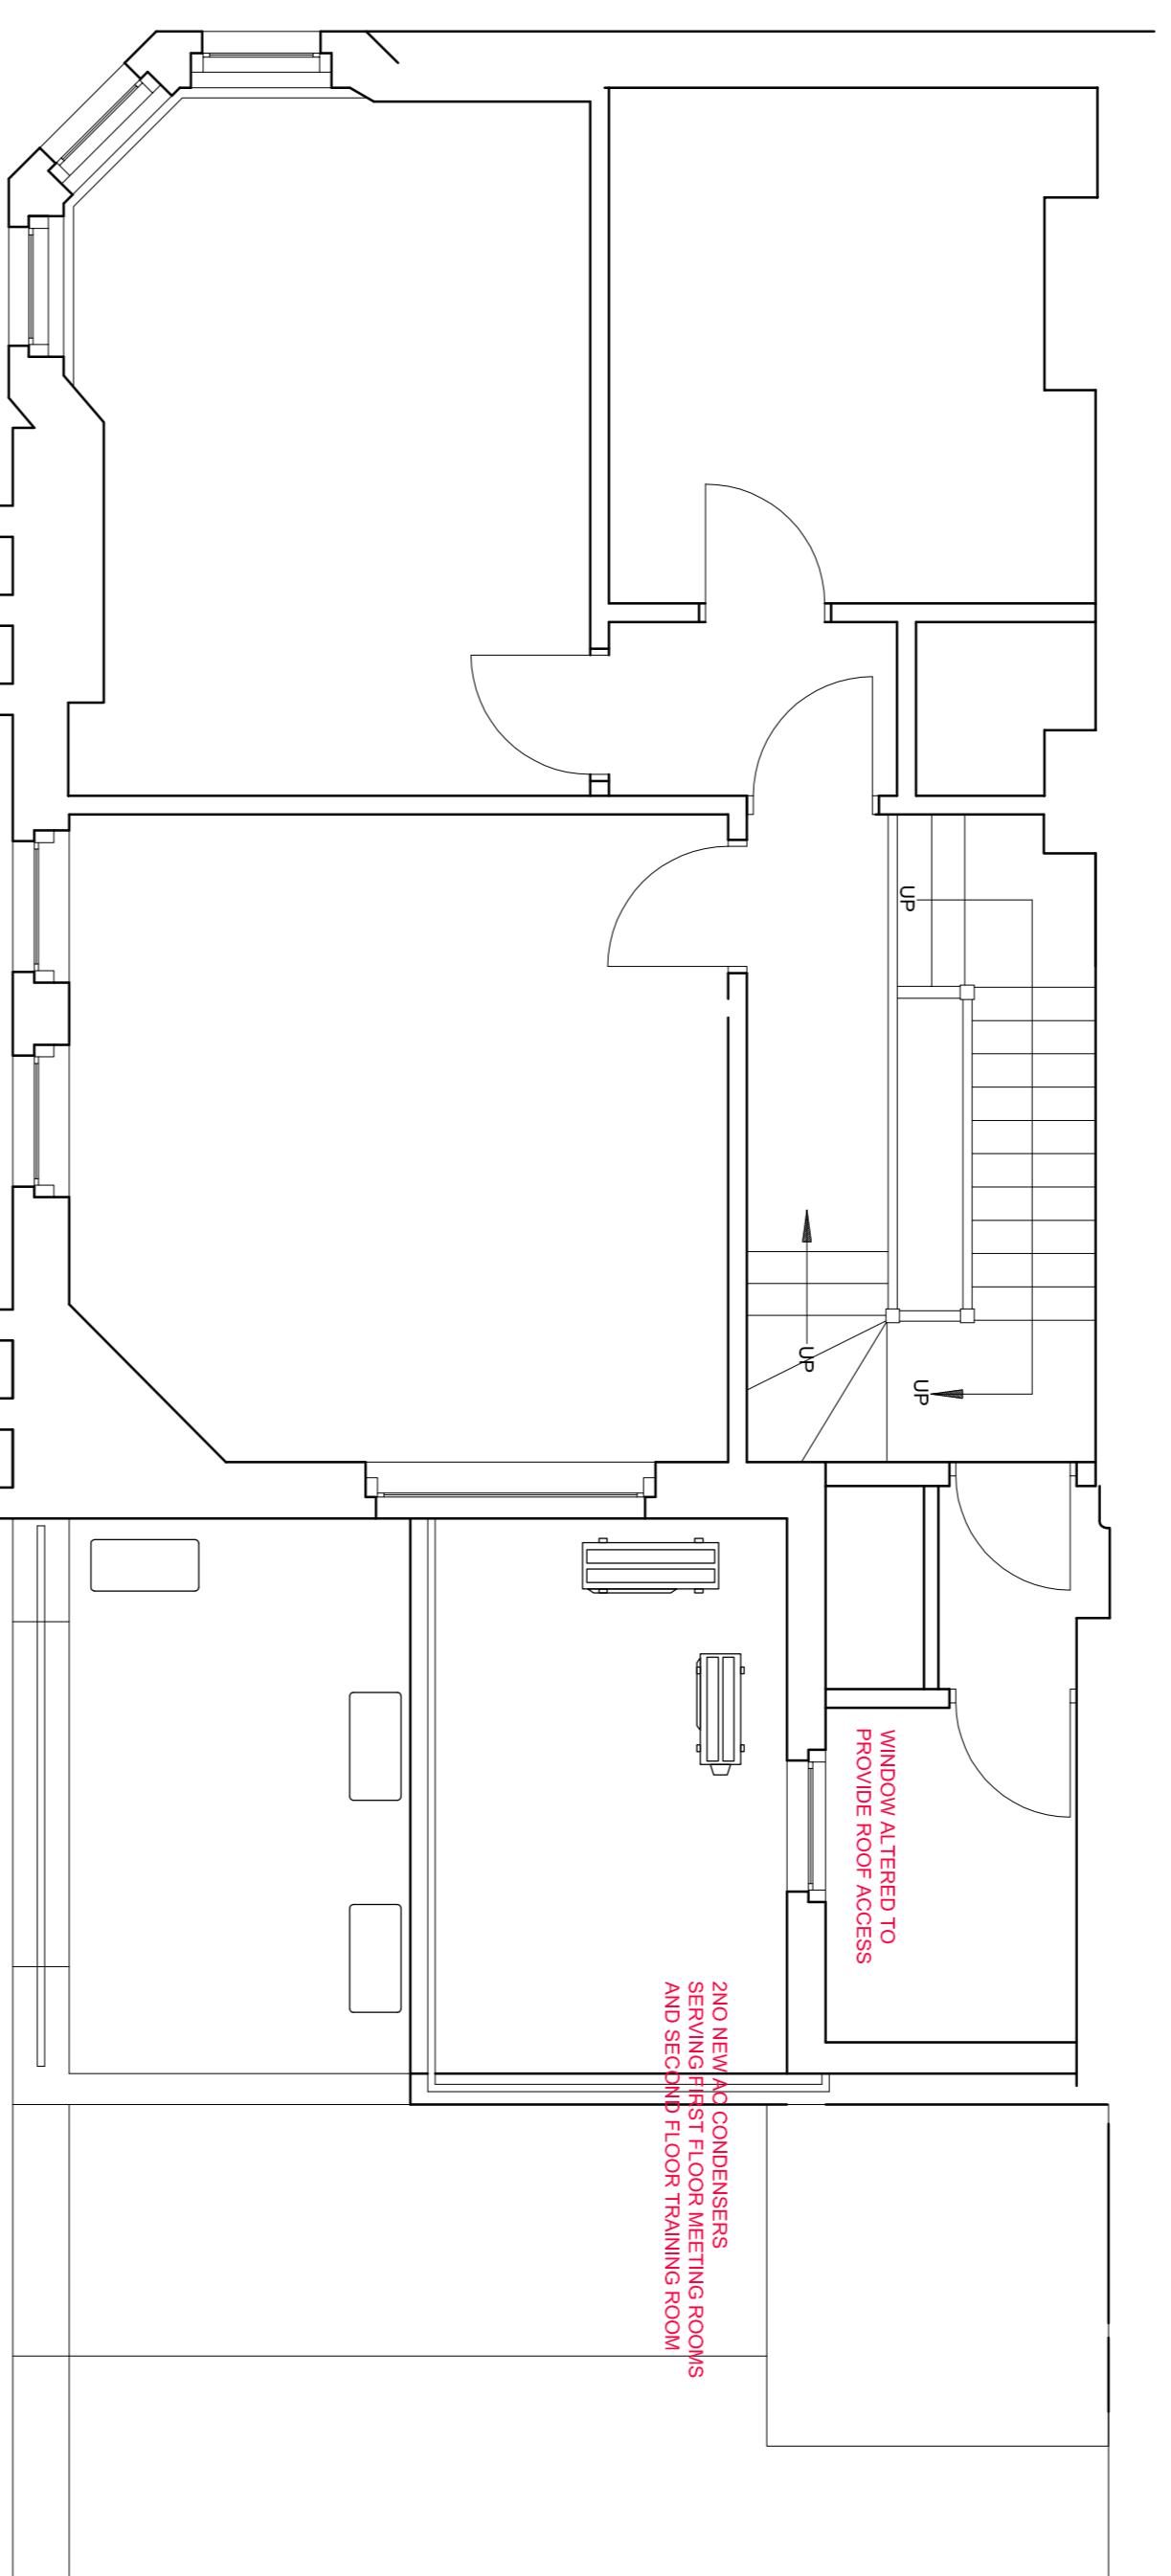

PROPOSED THIRD FLOOR PLAN

REV	DATE	REVISION	INITIALS
E	19/01/15	AC positions and window altered	MH
D	13/10/14	AS BUILT ISSUE	MH
C	06/08/14	AC units repositioned to match M&E drawings	ID
B	31/07/14	AC proposals amended on all roofs	MH
A	02/07/14	Construction Issue note added.	ID
-	23/06/14	Final Issue	MH

LLOYDS BANKING GROUP

ALL DIMENSIONS TO BE VERIFIED PRIOR TO COMMENCING WORK. DRAWING TO BE READ IN CONJUNCTION WITH PROJECT SPECIFICATIONS.
 THIS DRAWING IS THE PROPERTY OF LLOYDS BANKING GROUP AND COPYRIGHT IS RESERVED. THE DESIGN AND ANY BUILDING REGULATIONS WITHIN IT ARE THE PROPERTY OF LLOYDS BANKING GROUP. GROUP PROPERTY.
 PRIOR CONSENT IN WRITING TO LLOYDS BANKING GROUP. GROUP PROPERTY.
 ALL MODIFIED DRAWINGS SHOULD BE RETURNED TO LLOYDS BANKING GROUP.

GROUP PROPERTY

BRITTON, 20 Bank 1/2, Cannon Row, Cannon Wharf, BRISTOL, BS29 7JD
 BRISTOL, 20 Bank 1/2, Cannon Row, Cannon Wharf, BRISTOL, BS29 7JD
 ENGLAND
 HULL/FAX: +44 (0)1482 422222
 HULL/FAX: +44 (0)1482 422222

SCALE
 A1 - 1:50
 A3 - 1:100

PROJECT ADDRESS
 Brand - Lloyds Bank
 106 Kilburn High Road
 LONDON NW6 4HT

DRAWING DESCRIPTION
 Third Floor
 Proposed Plan

DRAWN BY
 MH

REVISION
 E

DRAWING NUMBER
 504505681-AR01-03-1004

CONSTRUCTION

Prepared by Murray Halsey, Plot Code: 19.01.2015