



FIRST FLOOR

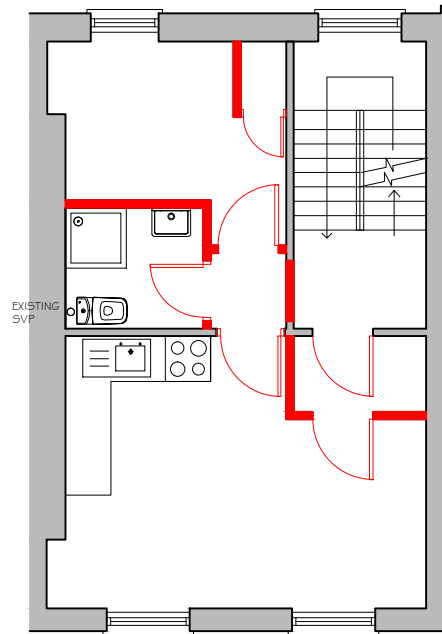


No. 8

SECOND FLOOR

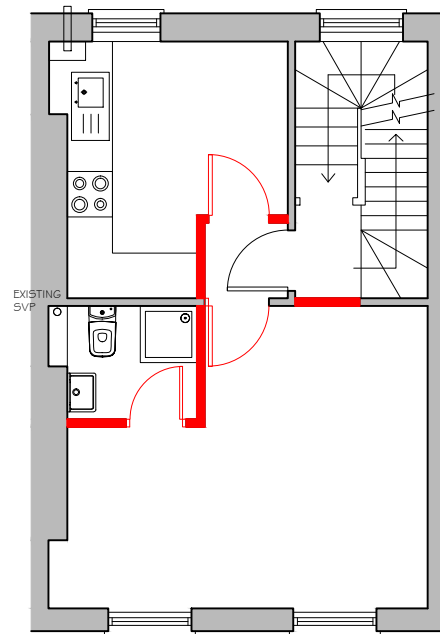


No. 8

THIRD FLOOR

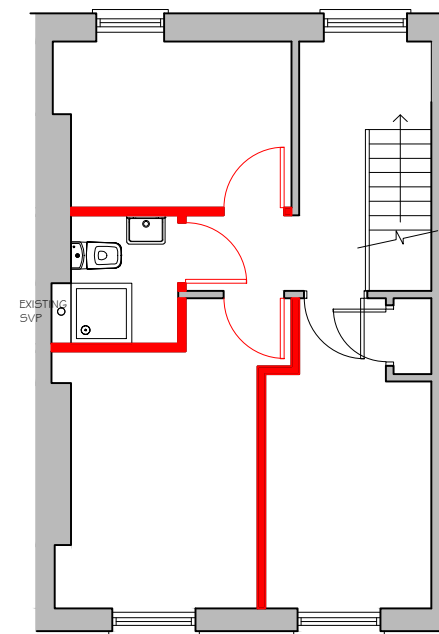


No. 8

LOWER GROUND FLOOR

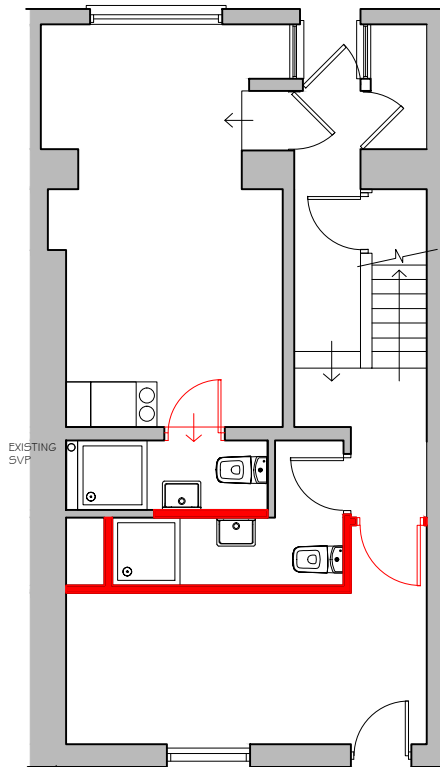



No. 8

GROUND FLOOR

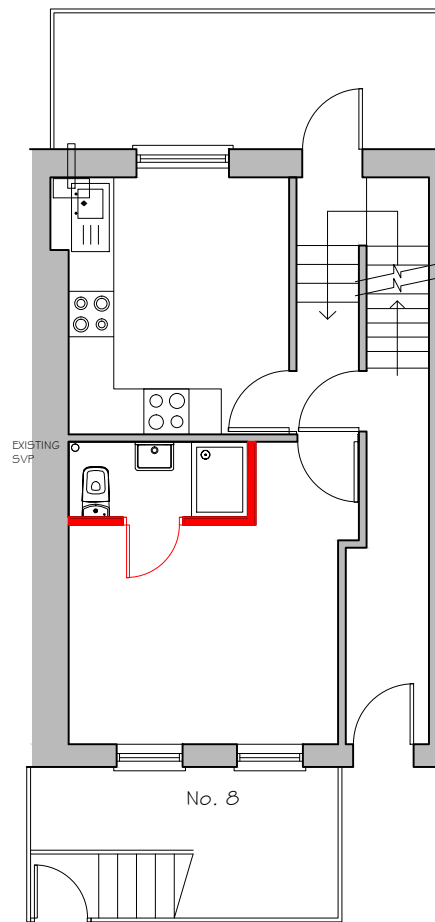

No. 8

Demolition Shown in RED

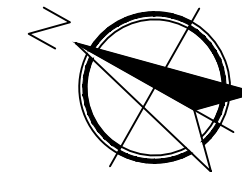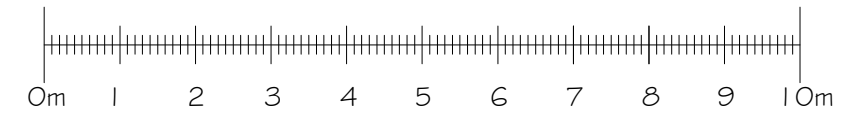

Existing Plans
Scale 1:100 @ A-3

Ref:1279/8/01

Rev:A

8 Sandwich Street
Russell Square
London

Client: Amadeus Leisure Ltd

Drawn by: SF
Date: 31st March 2015

pod LLP
Unit 313
Metal Box Factory
30 Great Guildford Street
London SE1 0HS

Tel: 020 3176 5590
Mob: 07808 037 998
Email: simon@podpartnership.com
Web: www.podpartnership.com

