



Notes:

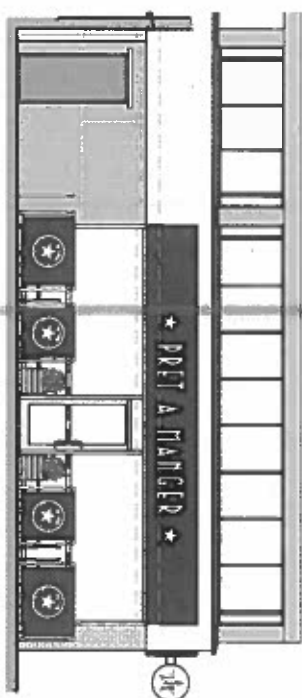

Proposed External Elevation - Herbrand Street

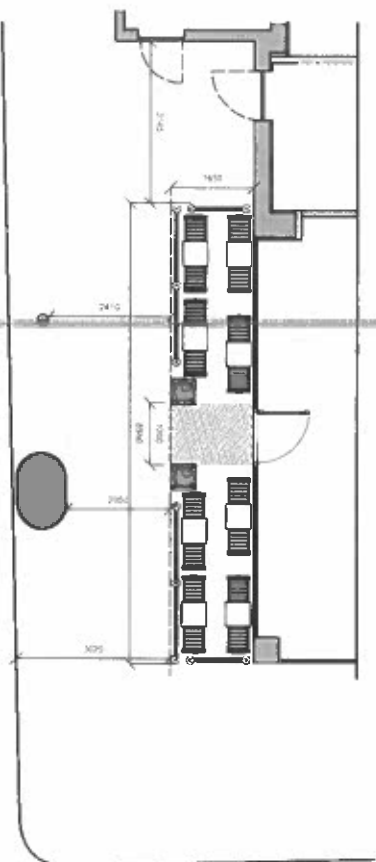

Proposed Part Plan - Herbrand Street

As Built

★ PRET A MANGER ★

1 Hudson Place, London, SW1V 1PZ

Site: 48-49 Bedford Street, Russell Square, London, WC1H 1LJ

Title: External Sealing Layout

Rev: Date: Drawn By:

Dwg No. RUSO-Pret-01

Date: 16.04.15 Revision: N/A

Scale: 1:100@ A3 Drawn By: RAJ

This drawing is the property of Pret A Manger Ltd. It is to be used for the purpose specified and is not to be reproduced, stored in a retrieval system or transmitted in any form or by any means, electronic, mechanical, photocopying, recording, or by any information storage and retrieval system, without the prior written permission of Pret A Manger Ltd.