



Copyright © the contents of this drawing may not be reproduced in whole or in part without the written permission of multifacet.  
 Local revisions of drawings are 'tagged' with this indicator.

**NOTES**

1. See Access Statement for information relating to access to Restaurant.
2. See drawing nr. 101 for Elevation details.

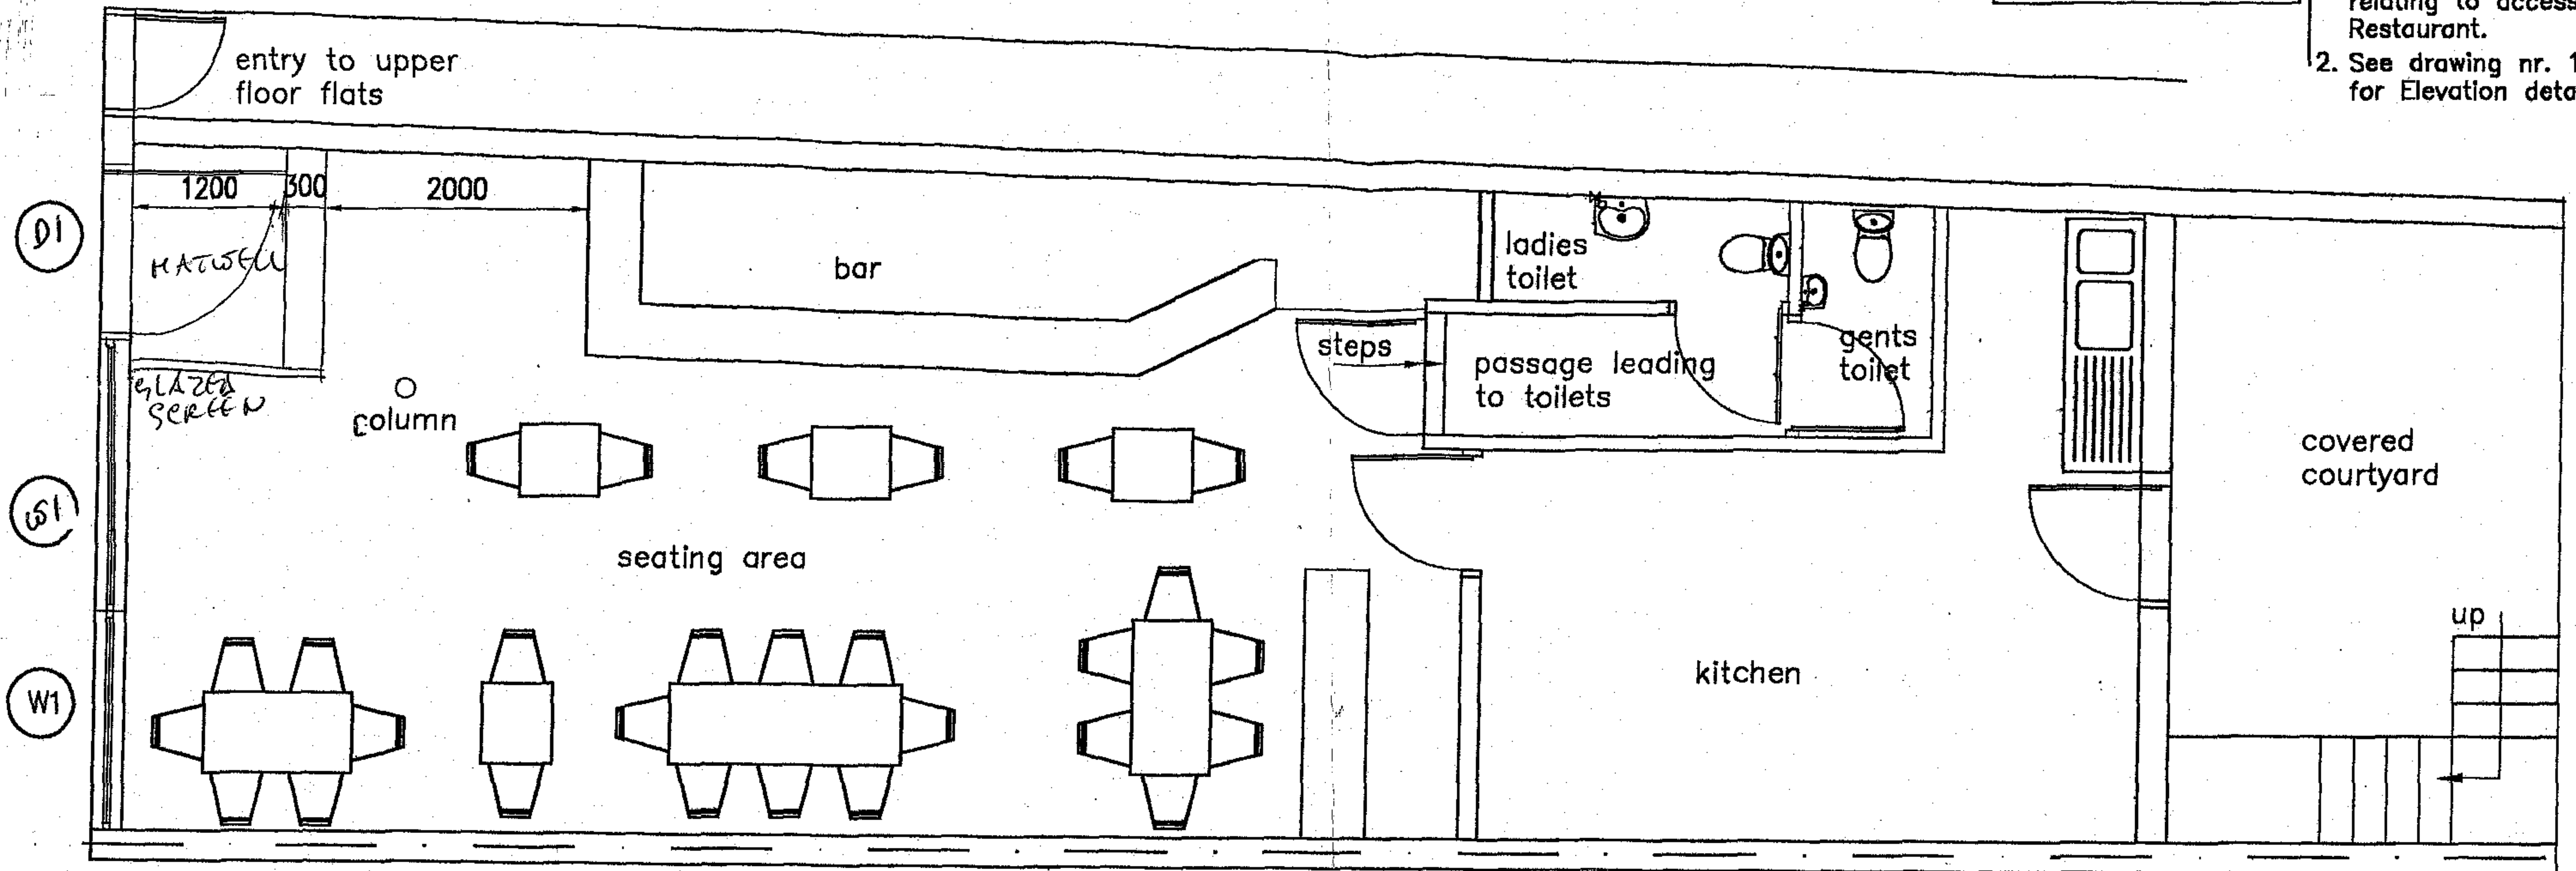

As Built Ground Floor Plan

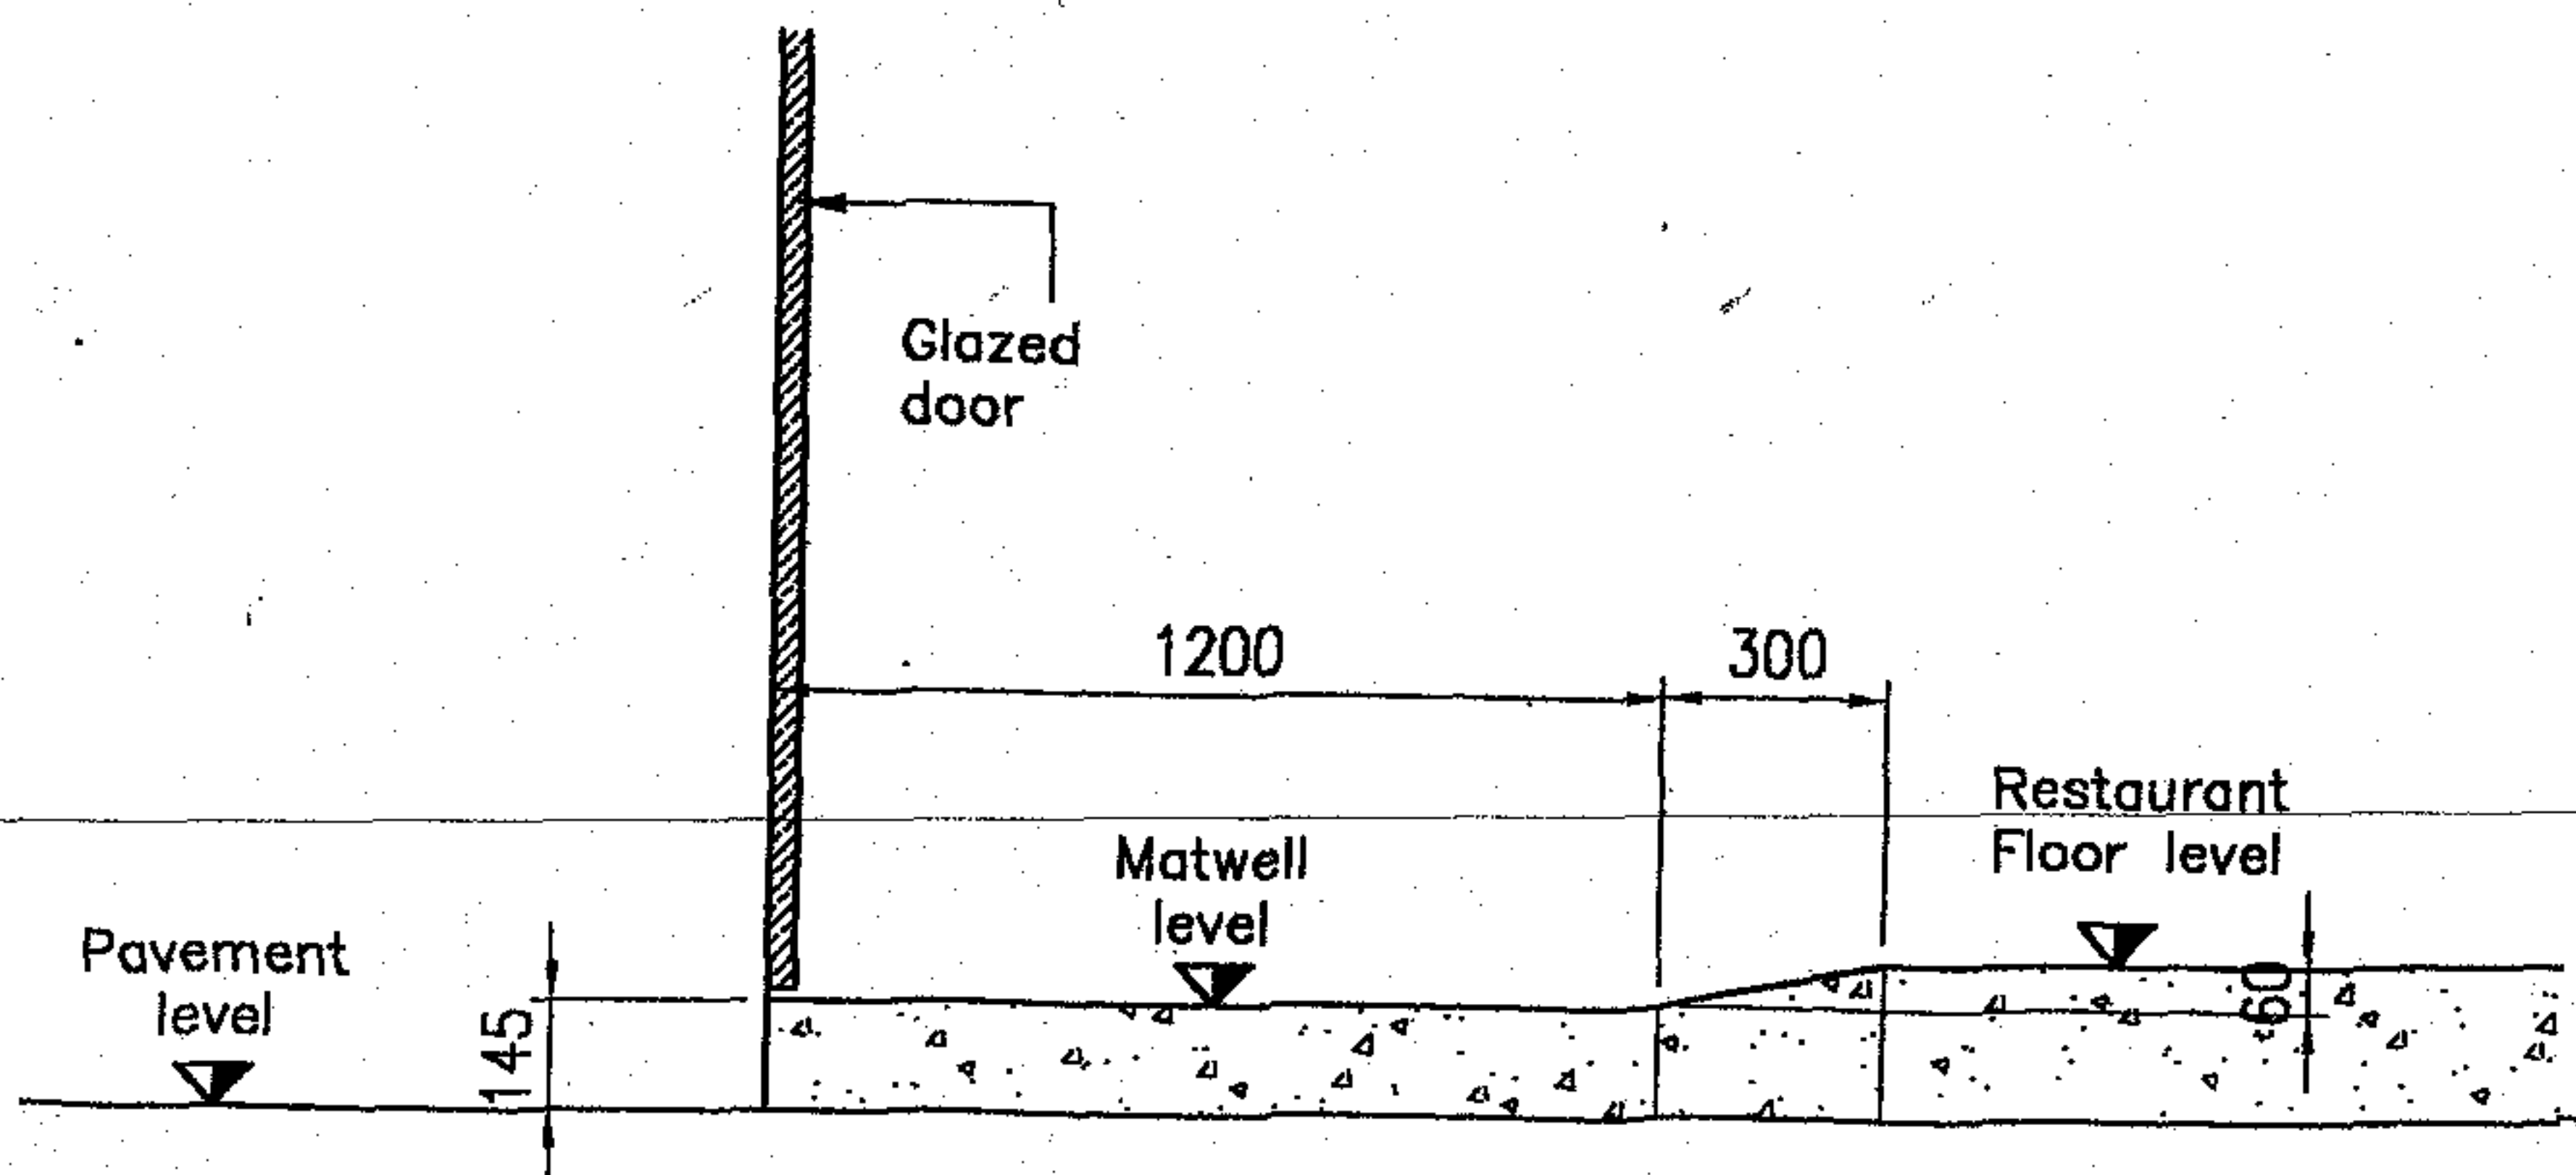

AND PROPOSED  
 As Built Section across Door Entrance

Scale: 1:20

**REVISED**

**2004/4725/PR1**

rev.	date	description	chd
T1	27.10.04	Building Reg. Issue	

**multifacet**  
 13 northumberland gardens  
 Mitcham, Surrey, CR4 1H  
 t:020 8879 0583  
 f:020 8879 0527  
 e:multifacet@btinternet.com



client:  
**PANE VINO Ltd**

project:  
**323 Kentish Town R  
 London  
 NW5 2TJ**

title:  
**As Built Ground  
 Floor Plan**

issue status:  
**For B.R. Approval**

scale	drawn by	checked by
1:20, 1:50	TT	
date	drawing nr.	rev.
Oct. 2004	1128/105	T1