


THIS DRAWING IS UNDER COPYRIGHT AND NO PORTION SHOULD BE USED WITHOUT PRIOR CONSENT. USE FIGURED DIMENSIONS ONLY. ALL FIGURED DIMENSIONS SHOWN ARE TAKEN FROM FINISHED SURFACES. ALL DIMENSIONS AND LEVELS MUST BE CHECKED ON SITE AND ANY INCONSISTENCIES REPORTED IMMEDIATELY TO B3 PRIOR TO PUTTING WORKS IN HAND.

REVISIONS:

CODE:	DATE:	DESCRIPTION:
-		

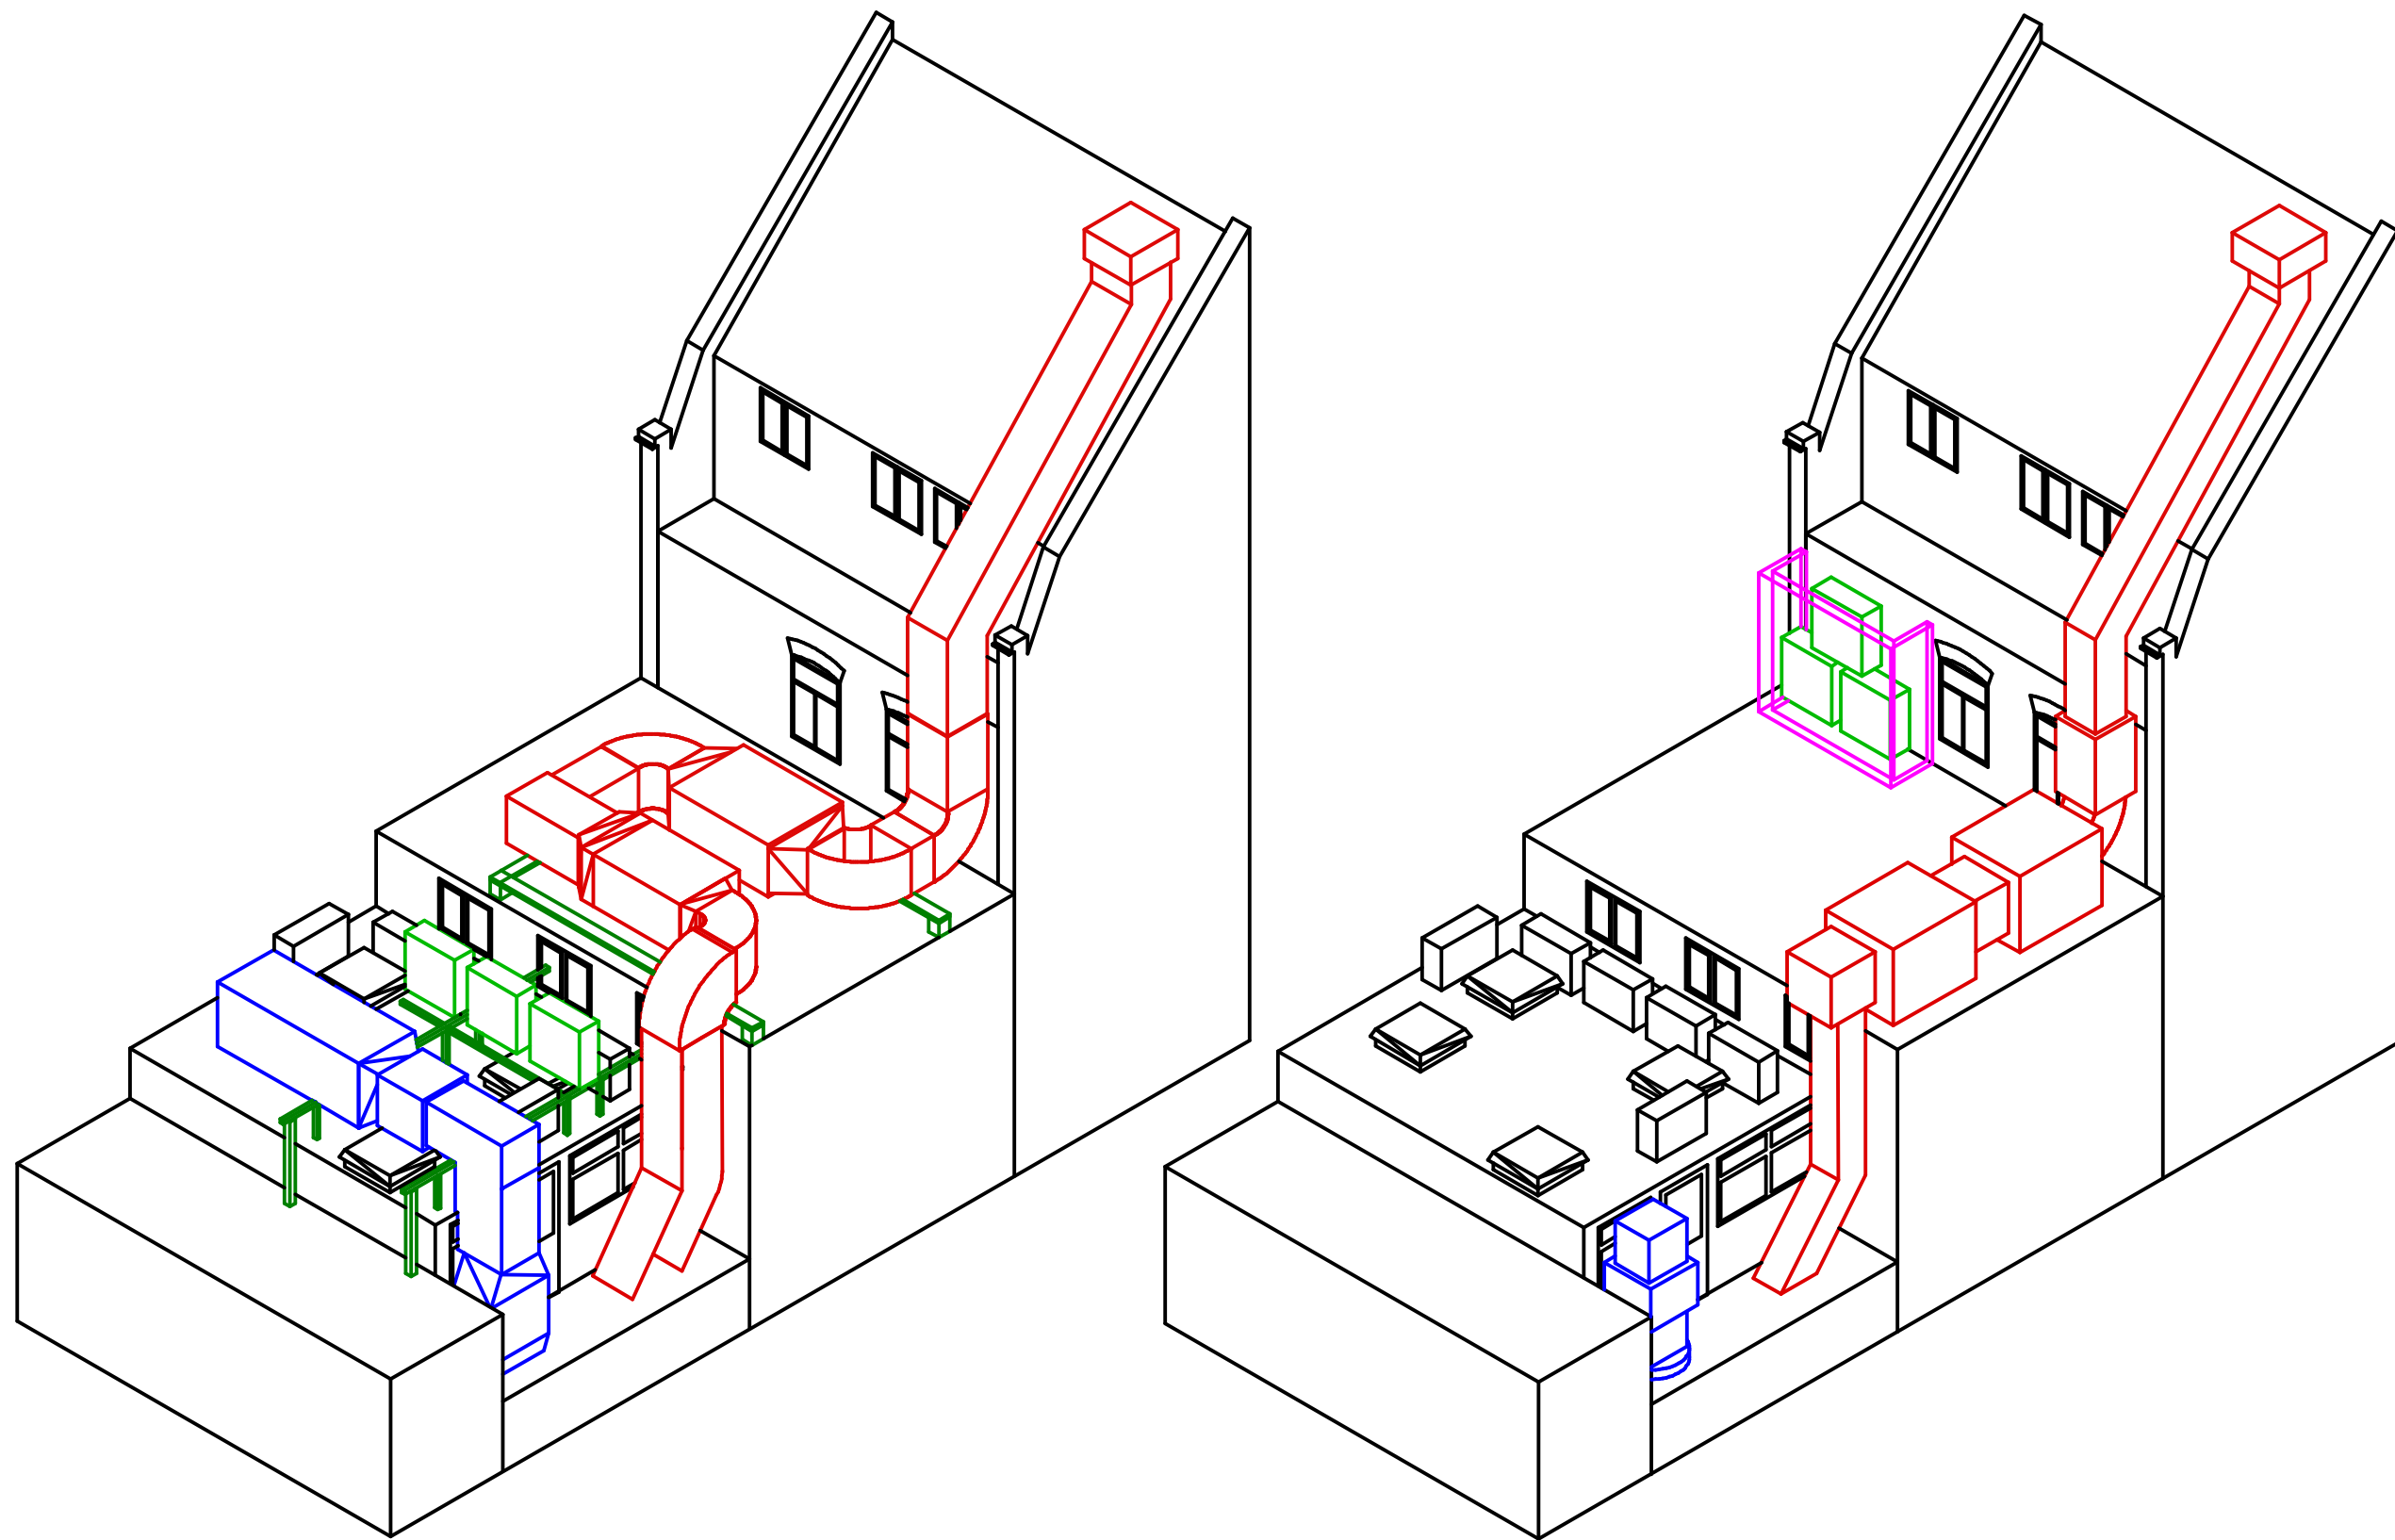

B3 DESIGN JERS		B3 Designers Ltd Unit 3, 51 Derbyshire Street, London, E2 6HQ. Tel: +44 (0)20 7729 8111 Fax: +44 (0)20 7729 8124	
PROJECT NO:	CLIENT/PROJECT:	789 BUBBLEDOGS	
DATE:	DRAWN:	CHECKED:	SCALE:
28.04.15	KJM	MB	1:25@ A1 1:50 @ A3
TITLE:			
AXONOMETRIC VIEW AS BUILT & PROPOSED			
DWG. NO:		REV:	
789-B3-16PRP-04		-	