


MALET STREET

WALLS TO BE REMOVED HIGHLIGHTED RED
(THOSE THAT DON'T APPEAR ON THE AS-BUILT DWGS. ARE MARKED WITH *)

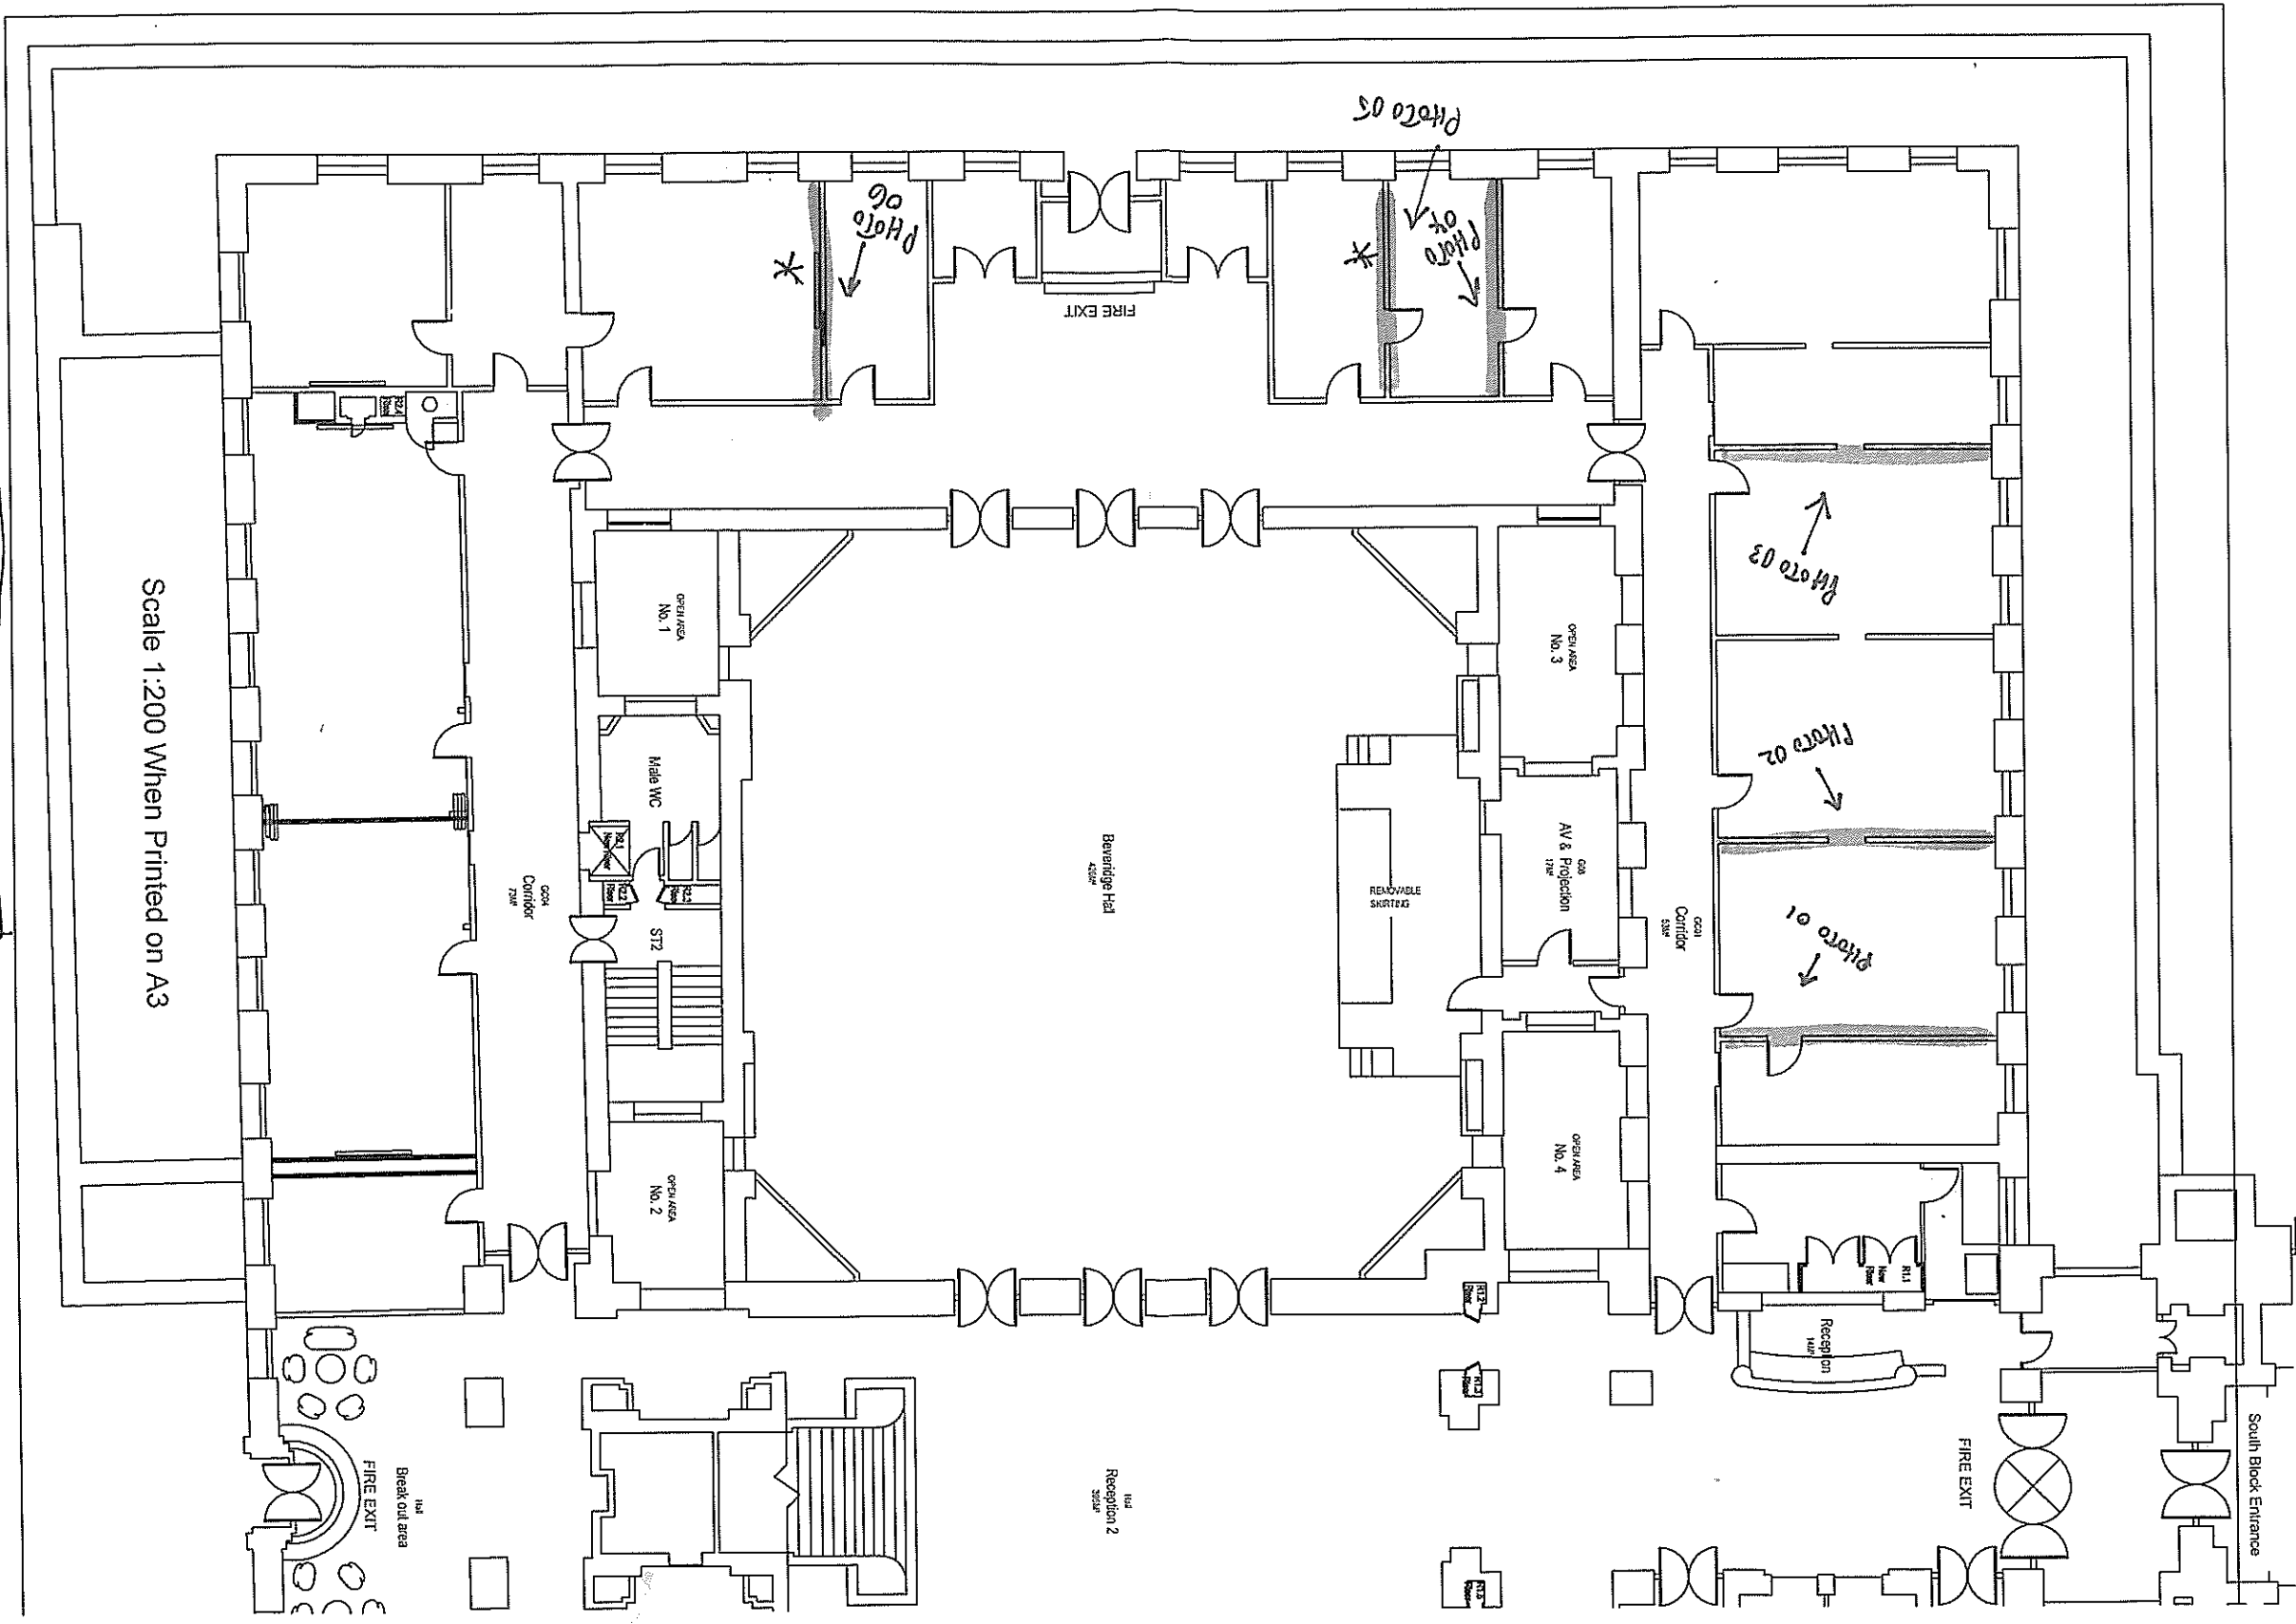

Scale 1:200 When Printed on A3

AT EXISTING LAYOUT
DWG. No. SHSR/02

MONTRAGUE PLACE