


PRIVATE ROAD PARALLEL WITH MALET STREET

UNIVERSITY OF LONDON : CONTRACT NO 2 : SENATE HOUSE

DWG. NO. 548B/03 AS-BUILT LAYOUT (BASED ON 1930s DRAWINGS)

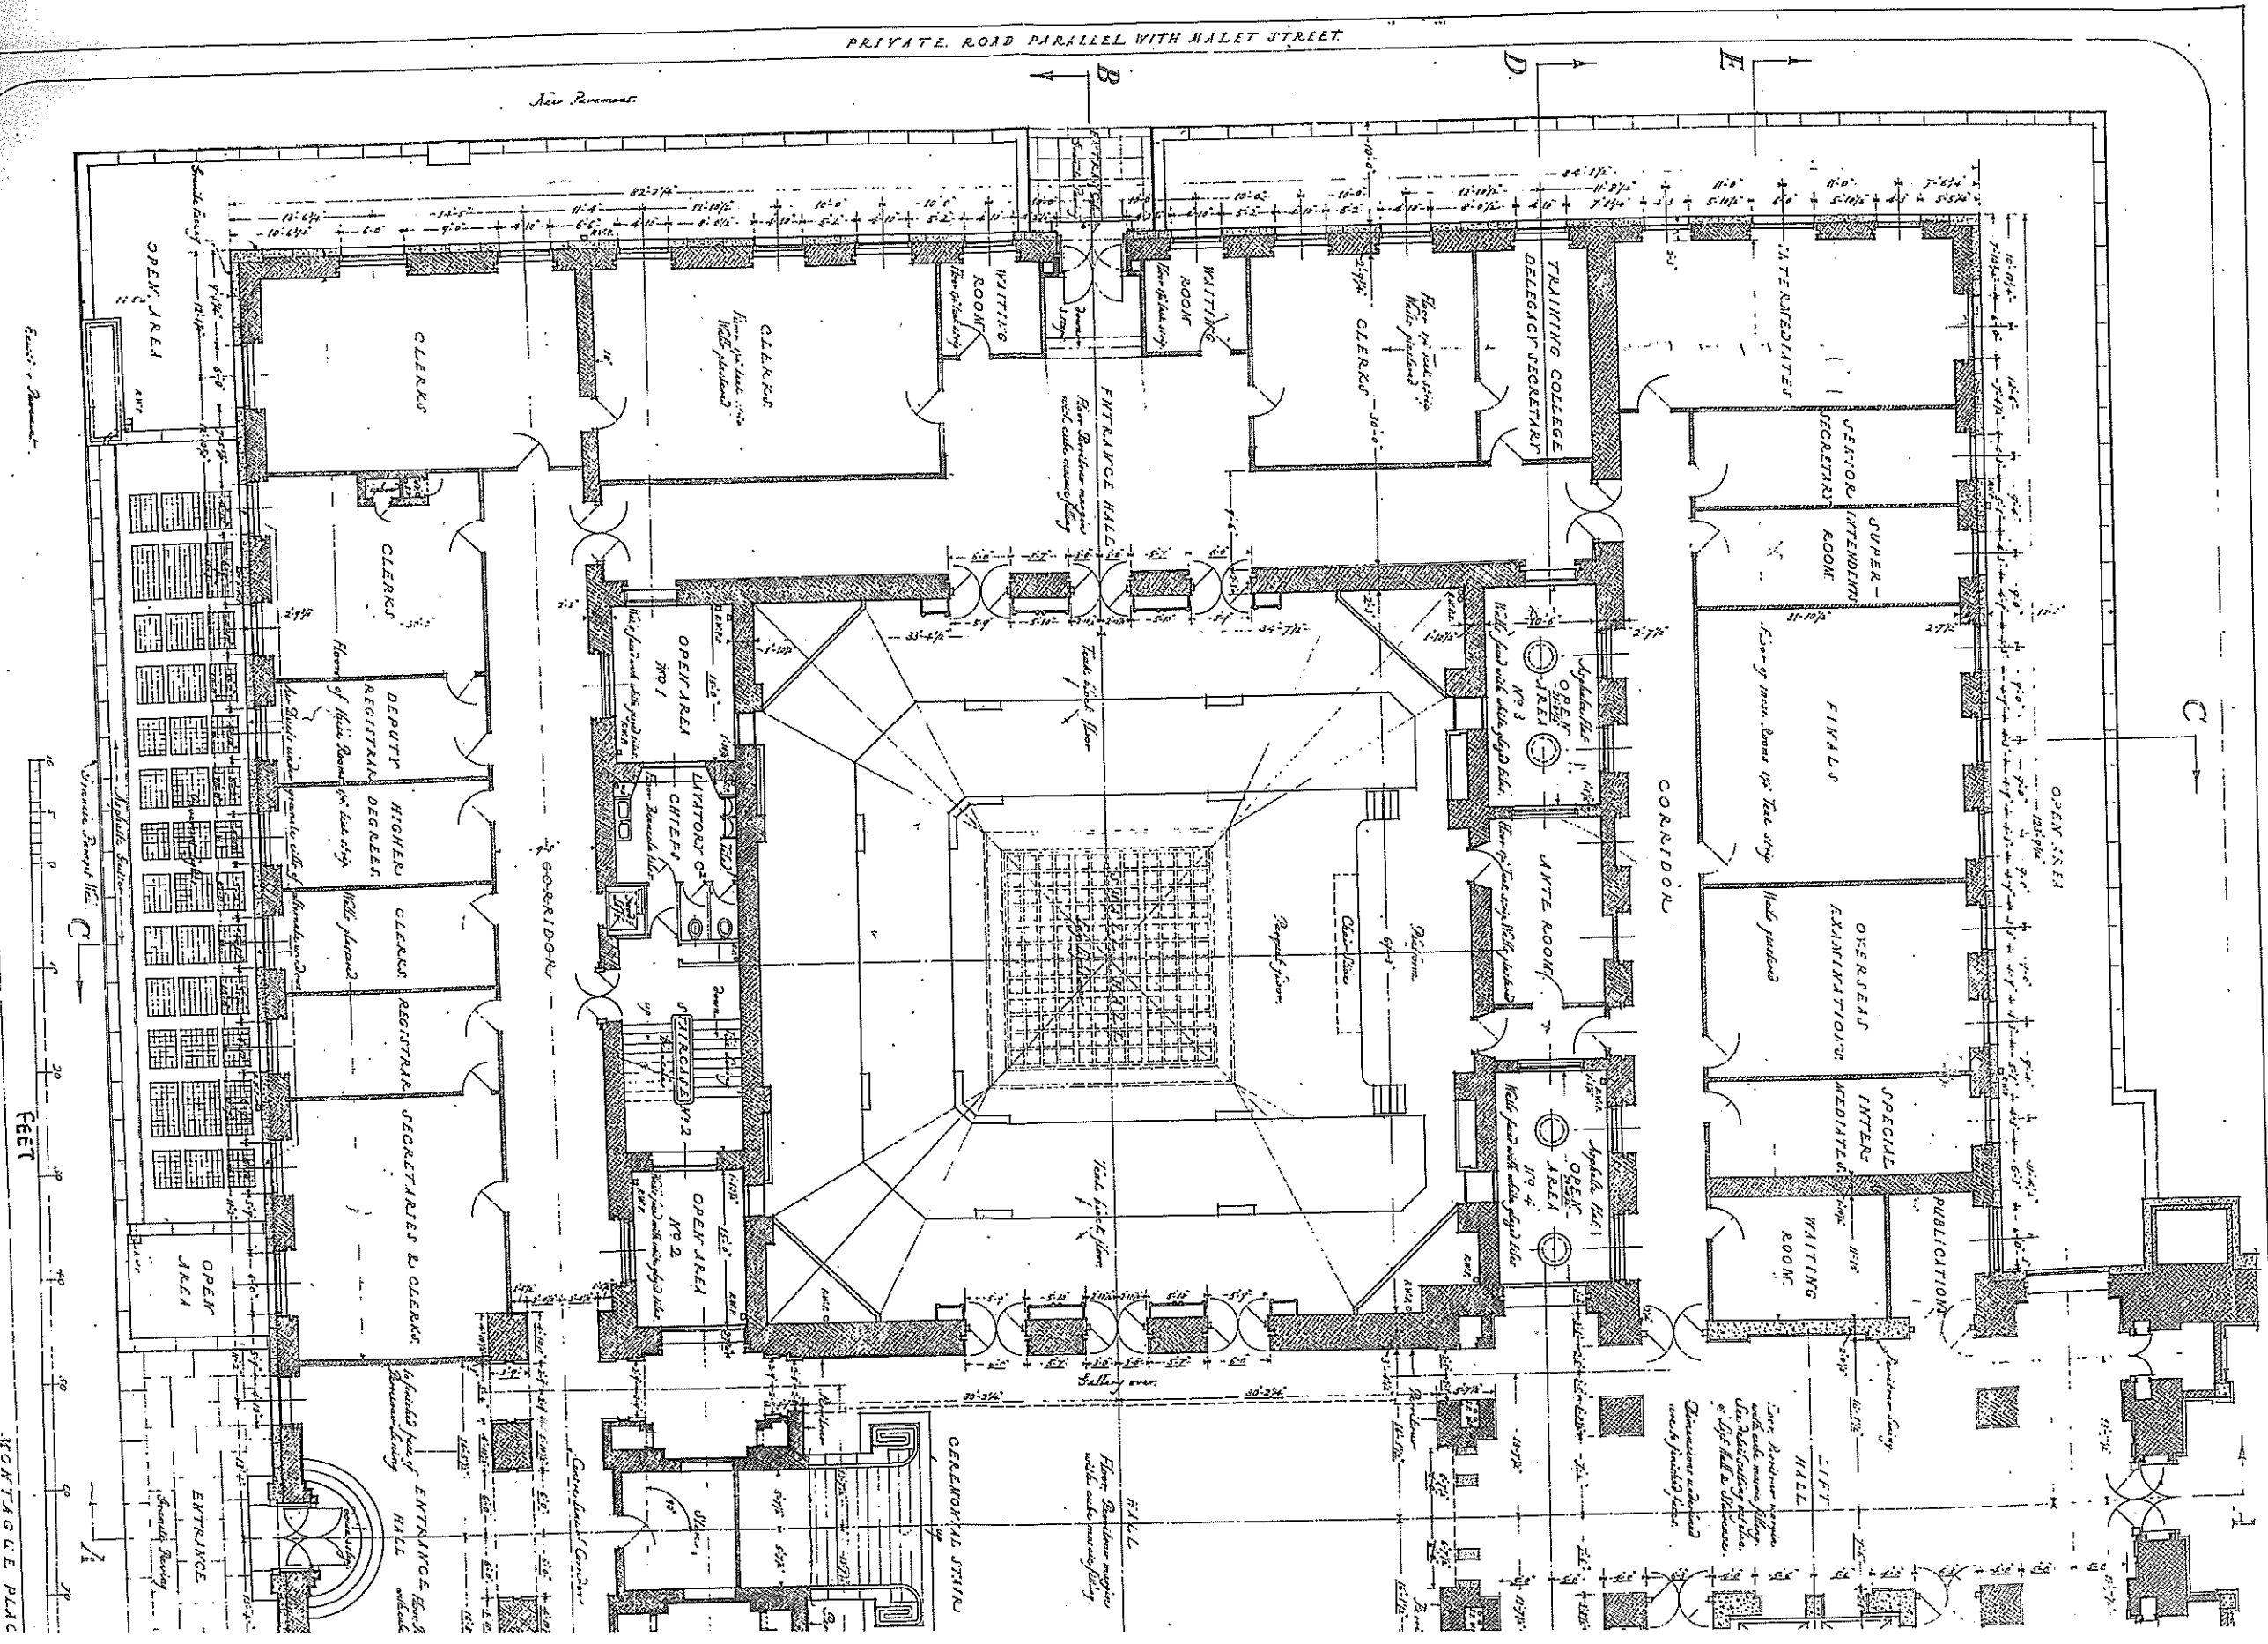

FEET

WENTWORTH PLACE