



REAR ELEVATION

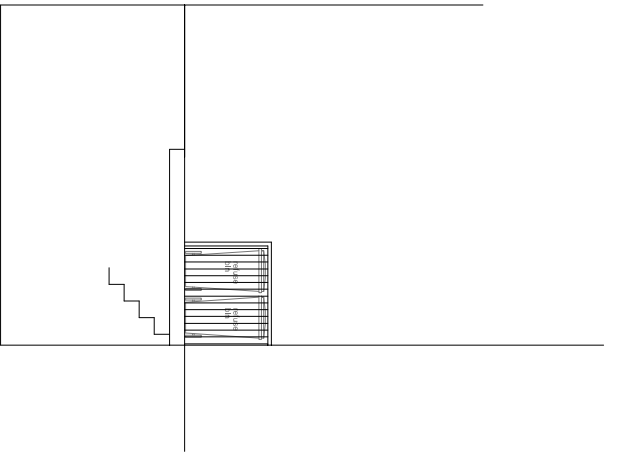

ELEVATION 2

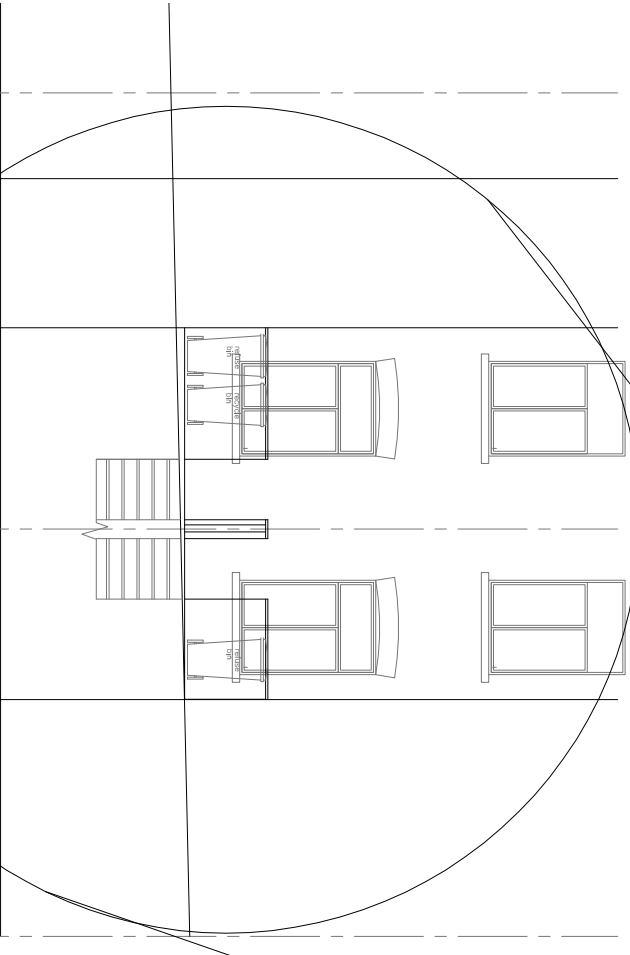

REAR ELEVATION

ELEVATION 1

TITLE **ELEVATIONS AS BUILT**

CLIENT **RAINBOW PROPERTIES LTD.**


ADDRESS **LINBURN HOUSE, 340-354 KILBURN HIGH ROAD,  
LONDON, NW6 2QJ**

SCALE **1:200 & 1:100 @ A3**

DRAWING NO. **condition 2**

DATE **AUG 2014**

REV. **D**

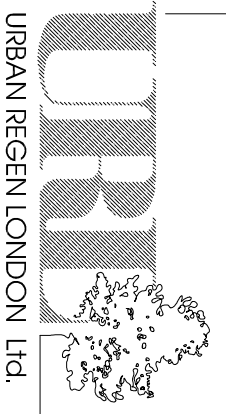

URBAN REGEN LONDON Ltd.

Tel: 07970 647 449 Fax: 020 8963 9991 Email: [urrlondon@aol.com](mailto:urrlondon@aol.com)