




FIRST FLOOR

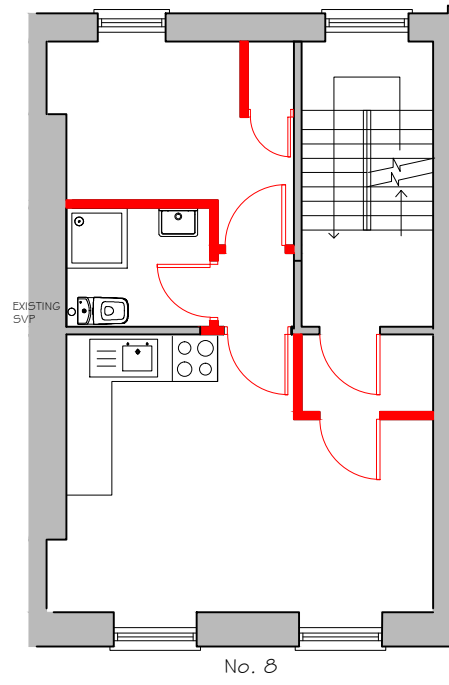


SECOND FLOOR

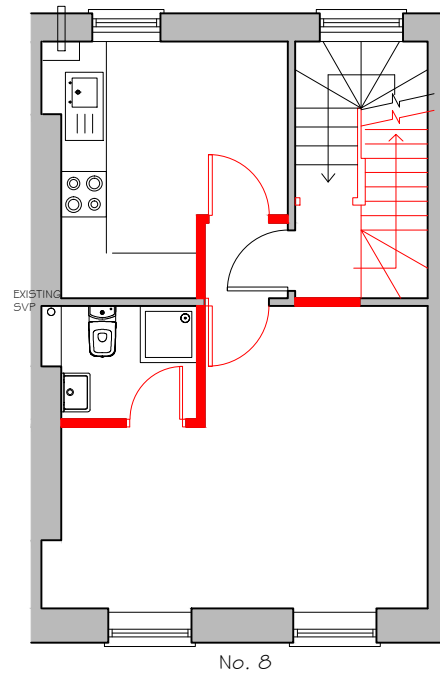


THIRD FLOOR

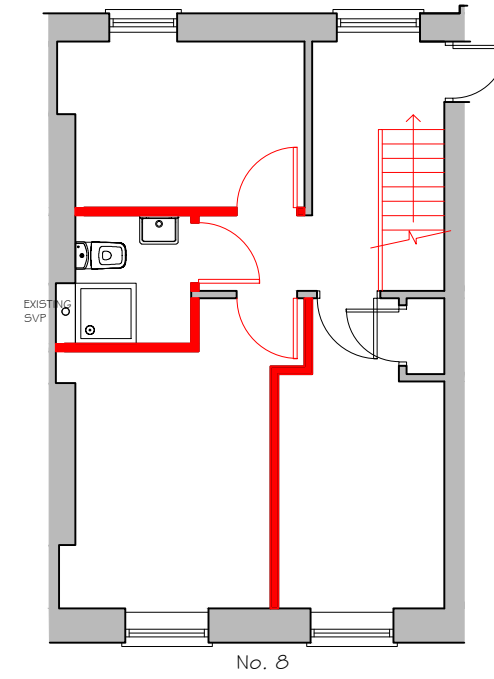


LOWER GROUND FLOOR

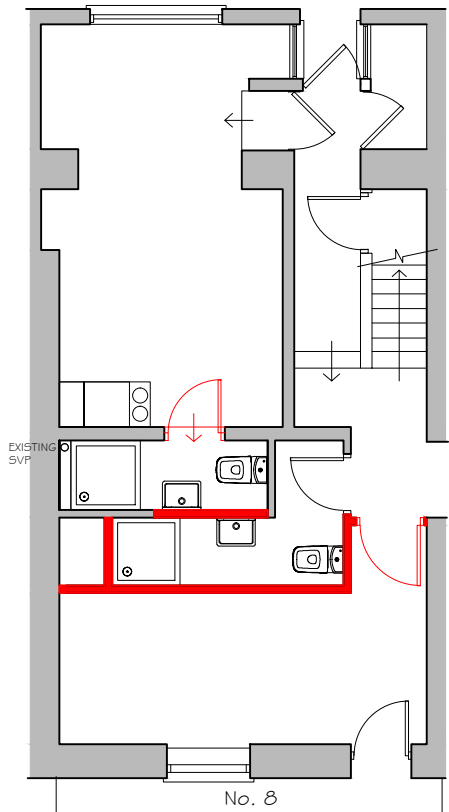

GROUND FLOOR

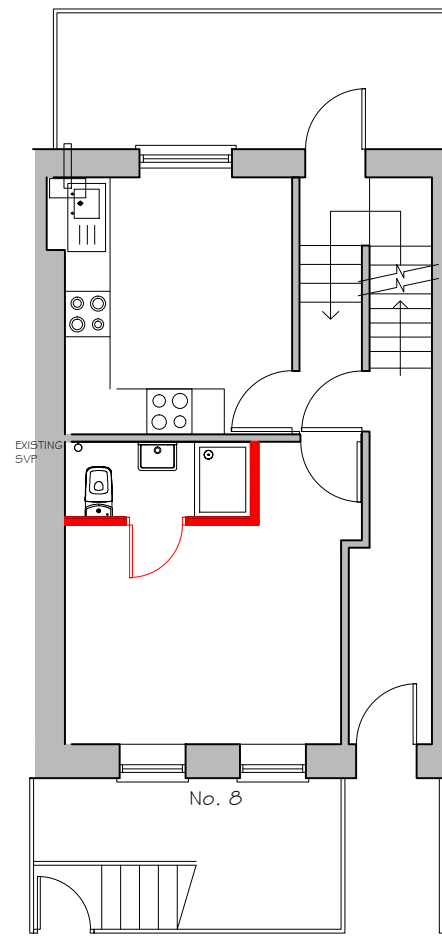

Demolition Shown in RED

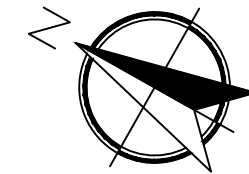

Existing Plans
Scale 1:100 @ A-3

Ref:1279/8/01

Rev:B

8 Sandwich Street
Russell Square
London

Client: Amadeus Leisure Ltd

Drawn by: SF
Date: 2nd July 2015

pod LLP
Unit 313
Metal Box Factory
30 Great Guildford Street
London SE1 0HS

Tel: 020 3176 5590
Mob: 07808 037 998
Email: simon@podpartnership.com
Web: www.podpartnership.com

