




FIRST FLOOR

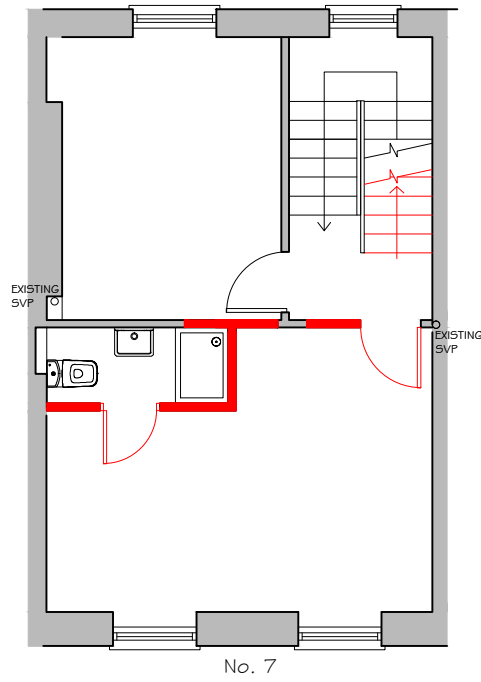


SECOND FLOOR

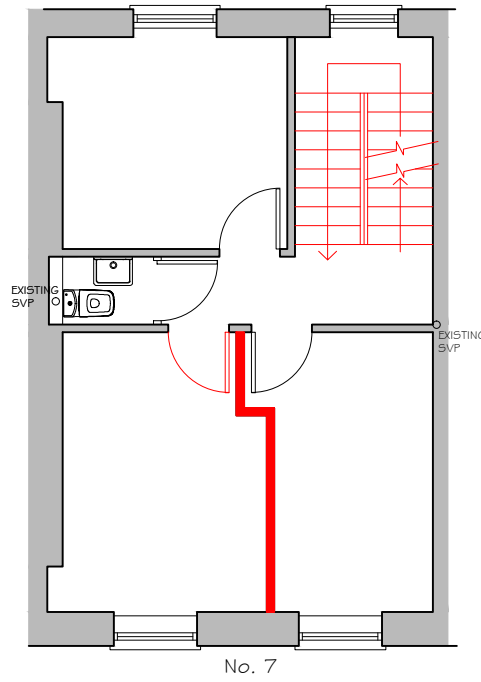


THIRD FLOOR

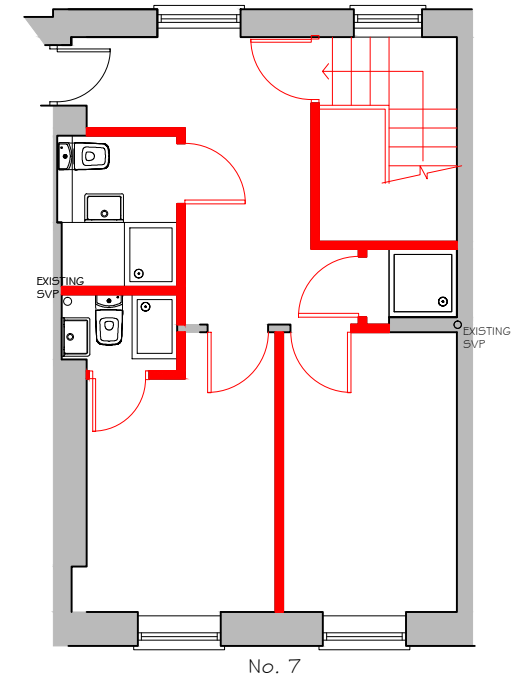



LOWER GROUND FLOOR

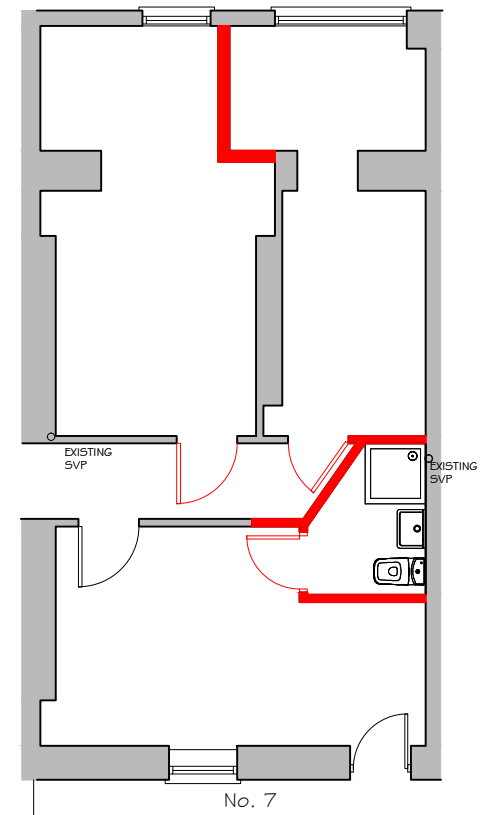

GROUND FLOOR

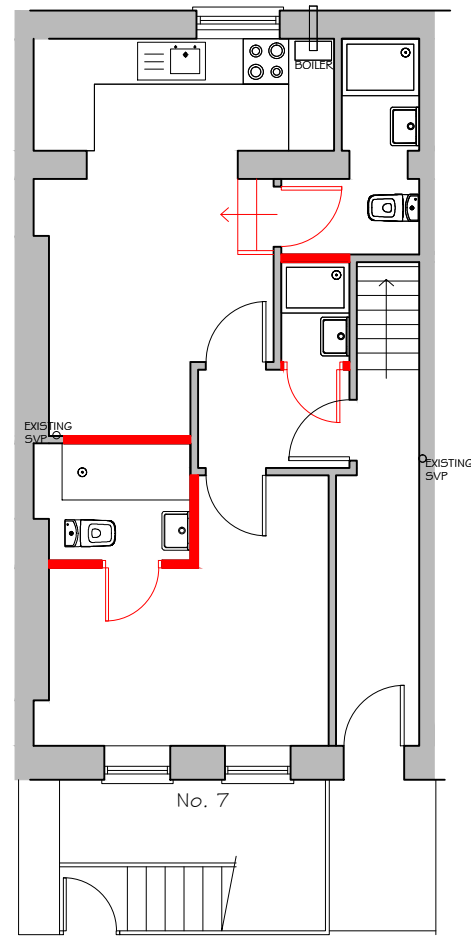

**Demolition Shown in RED**

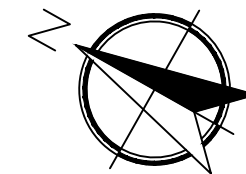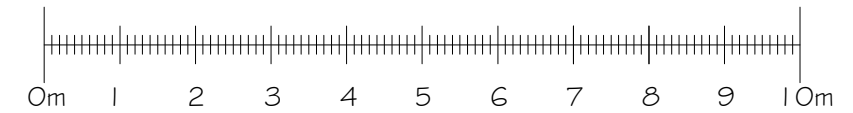

Existing Plans (with Demolition Shown)  
Scale 1:100 @ A-3

Ref:1279/7/01

Rev:B

7 Sandwich Street  
Russell Square  
London

Client: Amadeus Leisure Ltd

Drawn by: SF  
Date: 2nd July 2015

pod LLP  
Unit 313  
The Metal Box Factory  
30 Great Guildford Street  
London SE1 3ER

Tel: 020 3176 5590  
Mob: 07808 037 998  
Email: [simon@podpartnership.com](mailto:simon@podpartnership.com)  
Web: [www.podpartnership.com](http://www.podpartnership.com)

