

NOTE:
THIS DRAWING IS BASED ON A NON-INTRUSIVE SURVEY CARRIED OUT FOR STARBUCKS.
FOR VERIFICATION OF ITEMS BEHIND DRY LININGS ETC A SECOND INTRUSIVE SURVEY WILL BE REQUIRED UNDER INSTRUCTION OF THE STARBUCKS CONSTRUCTION MANAGER.

MAJOR SURVEY STAMP

EVOLVE RPS (LIMITED) SURVEY RETURN (STAMP OF APPROVAL)

SURVEYORS STATEMENT

THIS SURVEY DRAWING HAS BEEN COMPLETED BY GREG BIERNACKI, USING THE DIMENSIONS I HAVE RECORDED FROM SITE. THIS SURVEYING PROJECT HAS BEEN CLASSED AS A MAJOR TYPE SURVEY AND THEREFORE I HAVE TAKEN FULL SITE DIMENSIONS IN ORDER TO PRODUCE THE RECORD SURVEY PROVIDED. LIMITED ACCESS WAS MADE AVAILABLE TO INSPECT CONCEALED AREAS AND THEREFORE A FULLY INTRUSIVE SURVEY SHOULD BE ARRANGED IF ADDITIONAL INFORMATION IS REQUIRED.

GREG BIERNACKI - SURVEYED ON 5-11-2014

REVIT MODELLERS STATEMENT

THIS REVIT MODEL HAS BEEN COMPLETED BY GREG BIERNACKI, USING THE SURVEY INFORMATION PROVIDED BY GREG BIERNACKI. I CAN CONFIRM THAT I RECEIVED ALL INFORMATION REQUIRED IN ORDER TO PRODUCE THIS MODEL AND THAT THE MODEL I HAVE PRODUCED IS AN ACCURATE REPRESENTATION OF THE BUILDING.

GREG BIERNACKI - 10-11-2014



©2011 Starbucks Coffee Company

Starbucks Coffee Company

Building 4, Chiswick Park
566 Chiswick High Road
London, W4 5YE

These Drawings and Specifications are confidential and shall remain the sole property of Starbucks Corporation, which is the owner of the copyright in this work. They shall not be reproduced (in whole or in part), shared with third parties or used in any manner on other projects or extensions to this project without the prior written consent of Starbucks Corporation. These drawings and specifications are intended to express Design Intent for a prototypical Starbucks store (which is subject to change at anytime) and do not reflect actual site conditions. Neither party shall have any obligation nor liability to the other (except as stated above) until a written agreement is fully executed by both parties.


Architect of Record

Evolve-RPS
The Coach House
Grange Business Park
Hewish Bristol BS24 6RR




Revision Schedule


Rev	Date	By	Description

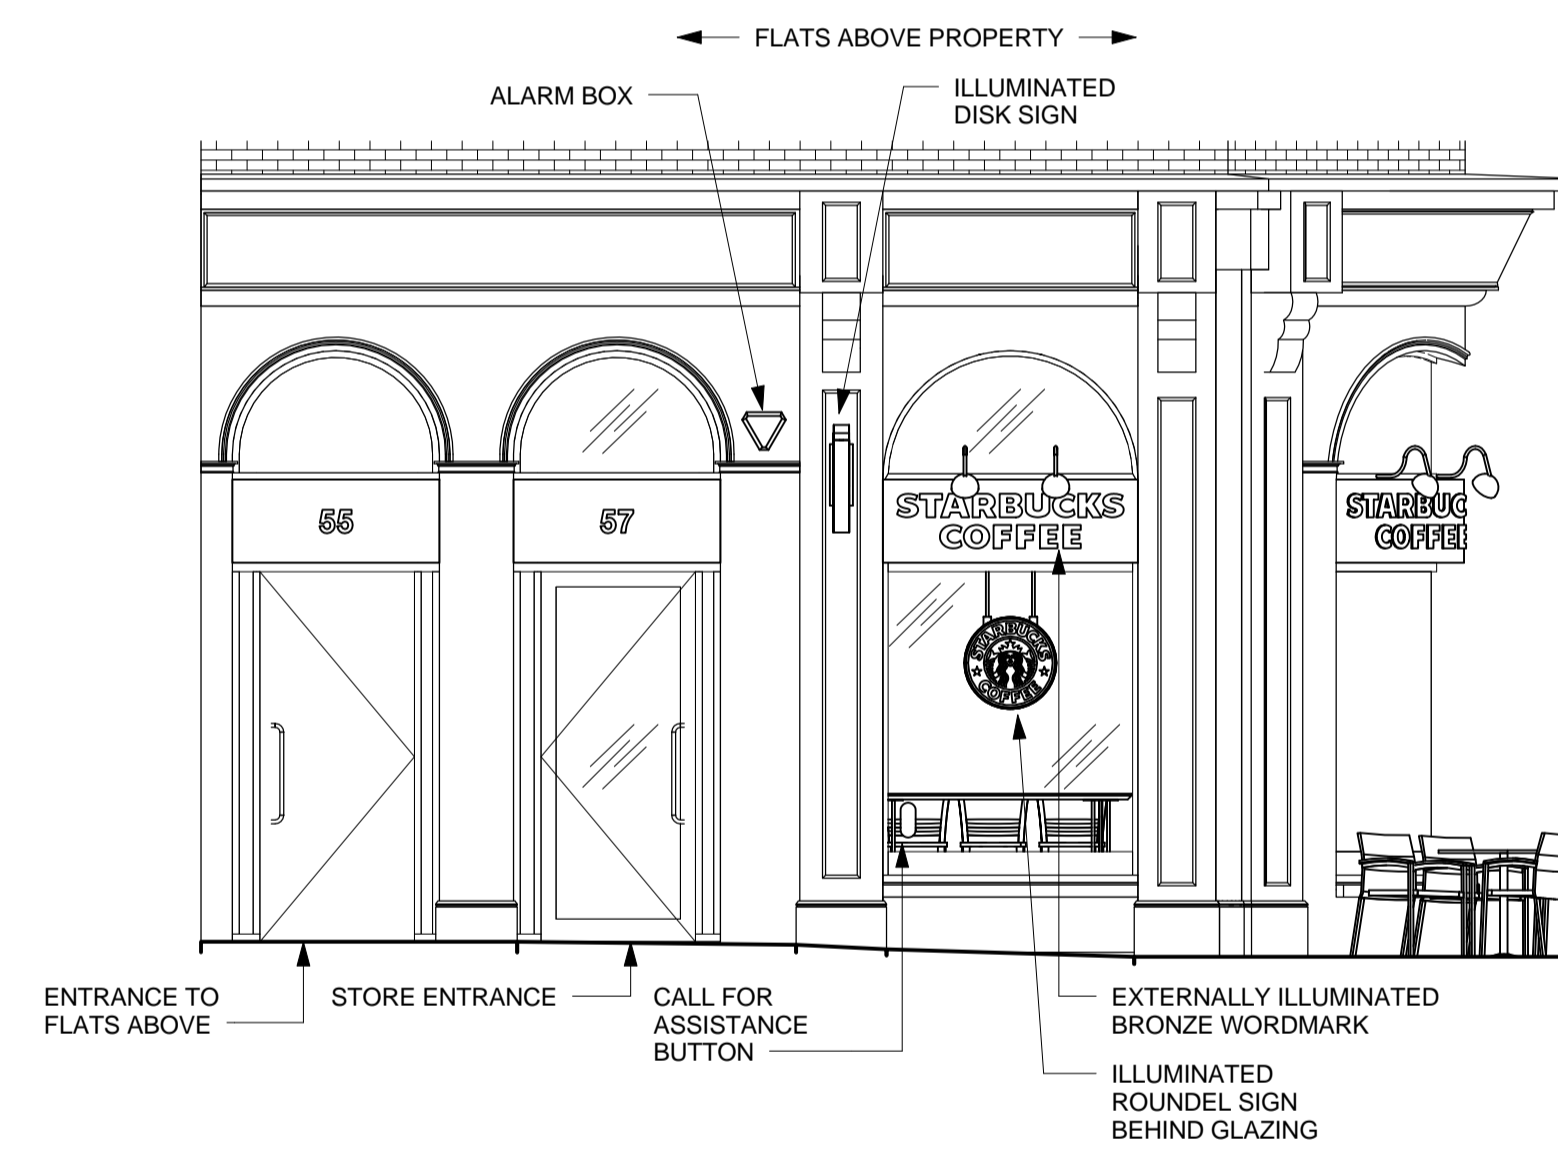

1 ELEVATION AT ENGLANDS LANE
Scale: 1 : 50

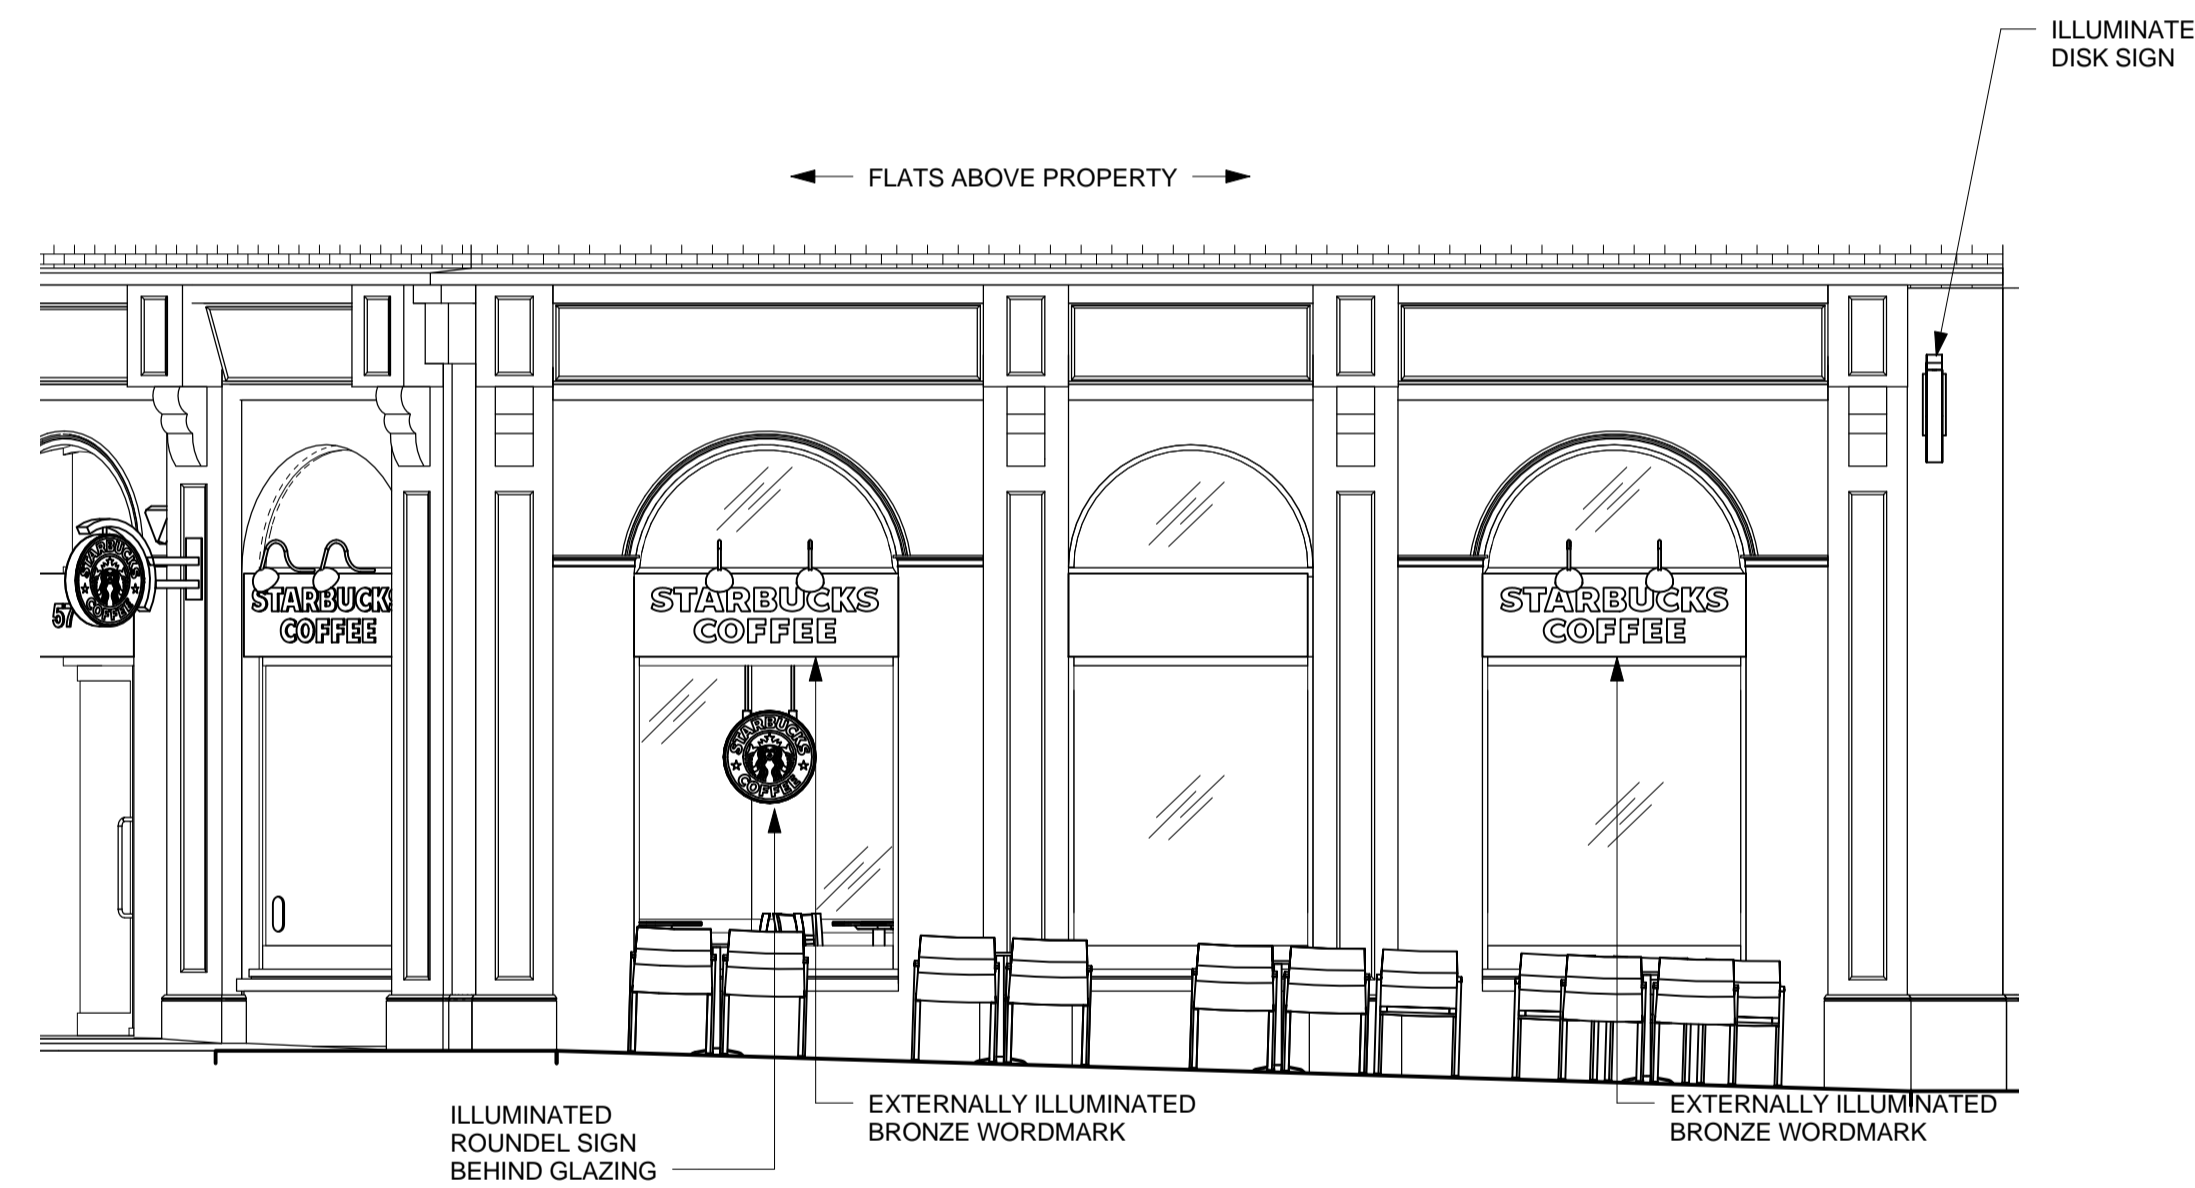

2 ELEVATION AT PRIMROSE HILL RD
Scale: 1 : 50

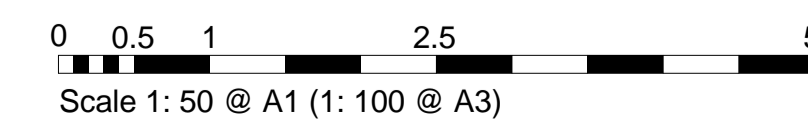

CONSTRUCTION DRAWING SET

Project Name:
57 ENGLANDS LANE
Project Address:
**57 ENGLANDS LANE
BELSIZE PARK
LONDON
NW3 4YD**

Store #: 12158
Project #:
Concept:
Palette:
Issue Date: 25-06-2015
Design Manager: AC
LEED® AP:
Production Designer: GD / EVOLVE
Checked by: AC

Sheet Title:
EXISTING EXTERIOR ELEVATIONS
Scale: 1 : 50

Sheet Number:
SU-2001