


job	BACTON LOW RISE LONDON NWS	drawn by	JPB	date:	04.15
drawing	TYPICAL JUNCTIONS - INTERNAL WALLS Detail 433 - Block A - Bin Store Cage	scale:	1:10 @ A1 1:20 @ A3	job no:	1952
drawing no.	D-J-433	rev.	as below		


revisions	date	description	issued by	checked by
	22.04.15	Issued for comment / approval	JPB	JD

Received		22 Apr 15	
	Initial		Date
RYDON	RA		27 May 15
Client			
Status A - No Comments			<input type="checkbox"/>
Status B - Comments, Revise & Resubmit			<input checked="" type="checkbox"/>
Status C - Rejected			<input type="checkbox"/>
For Information Only			

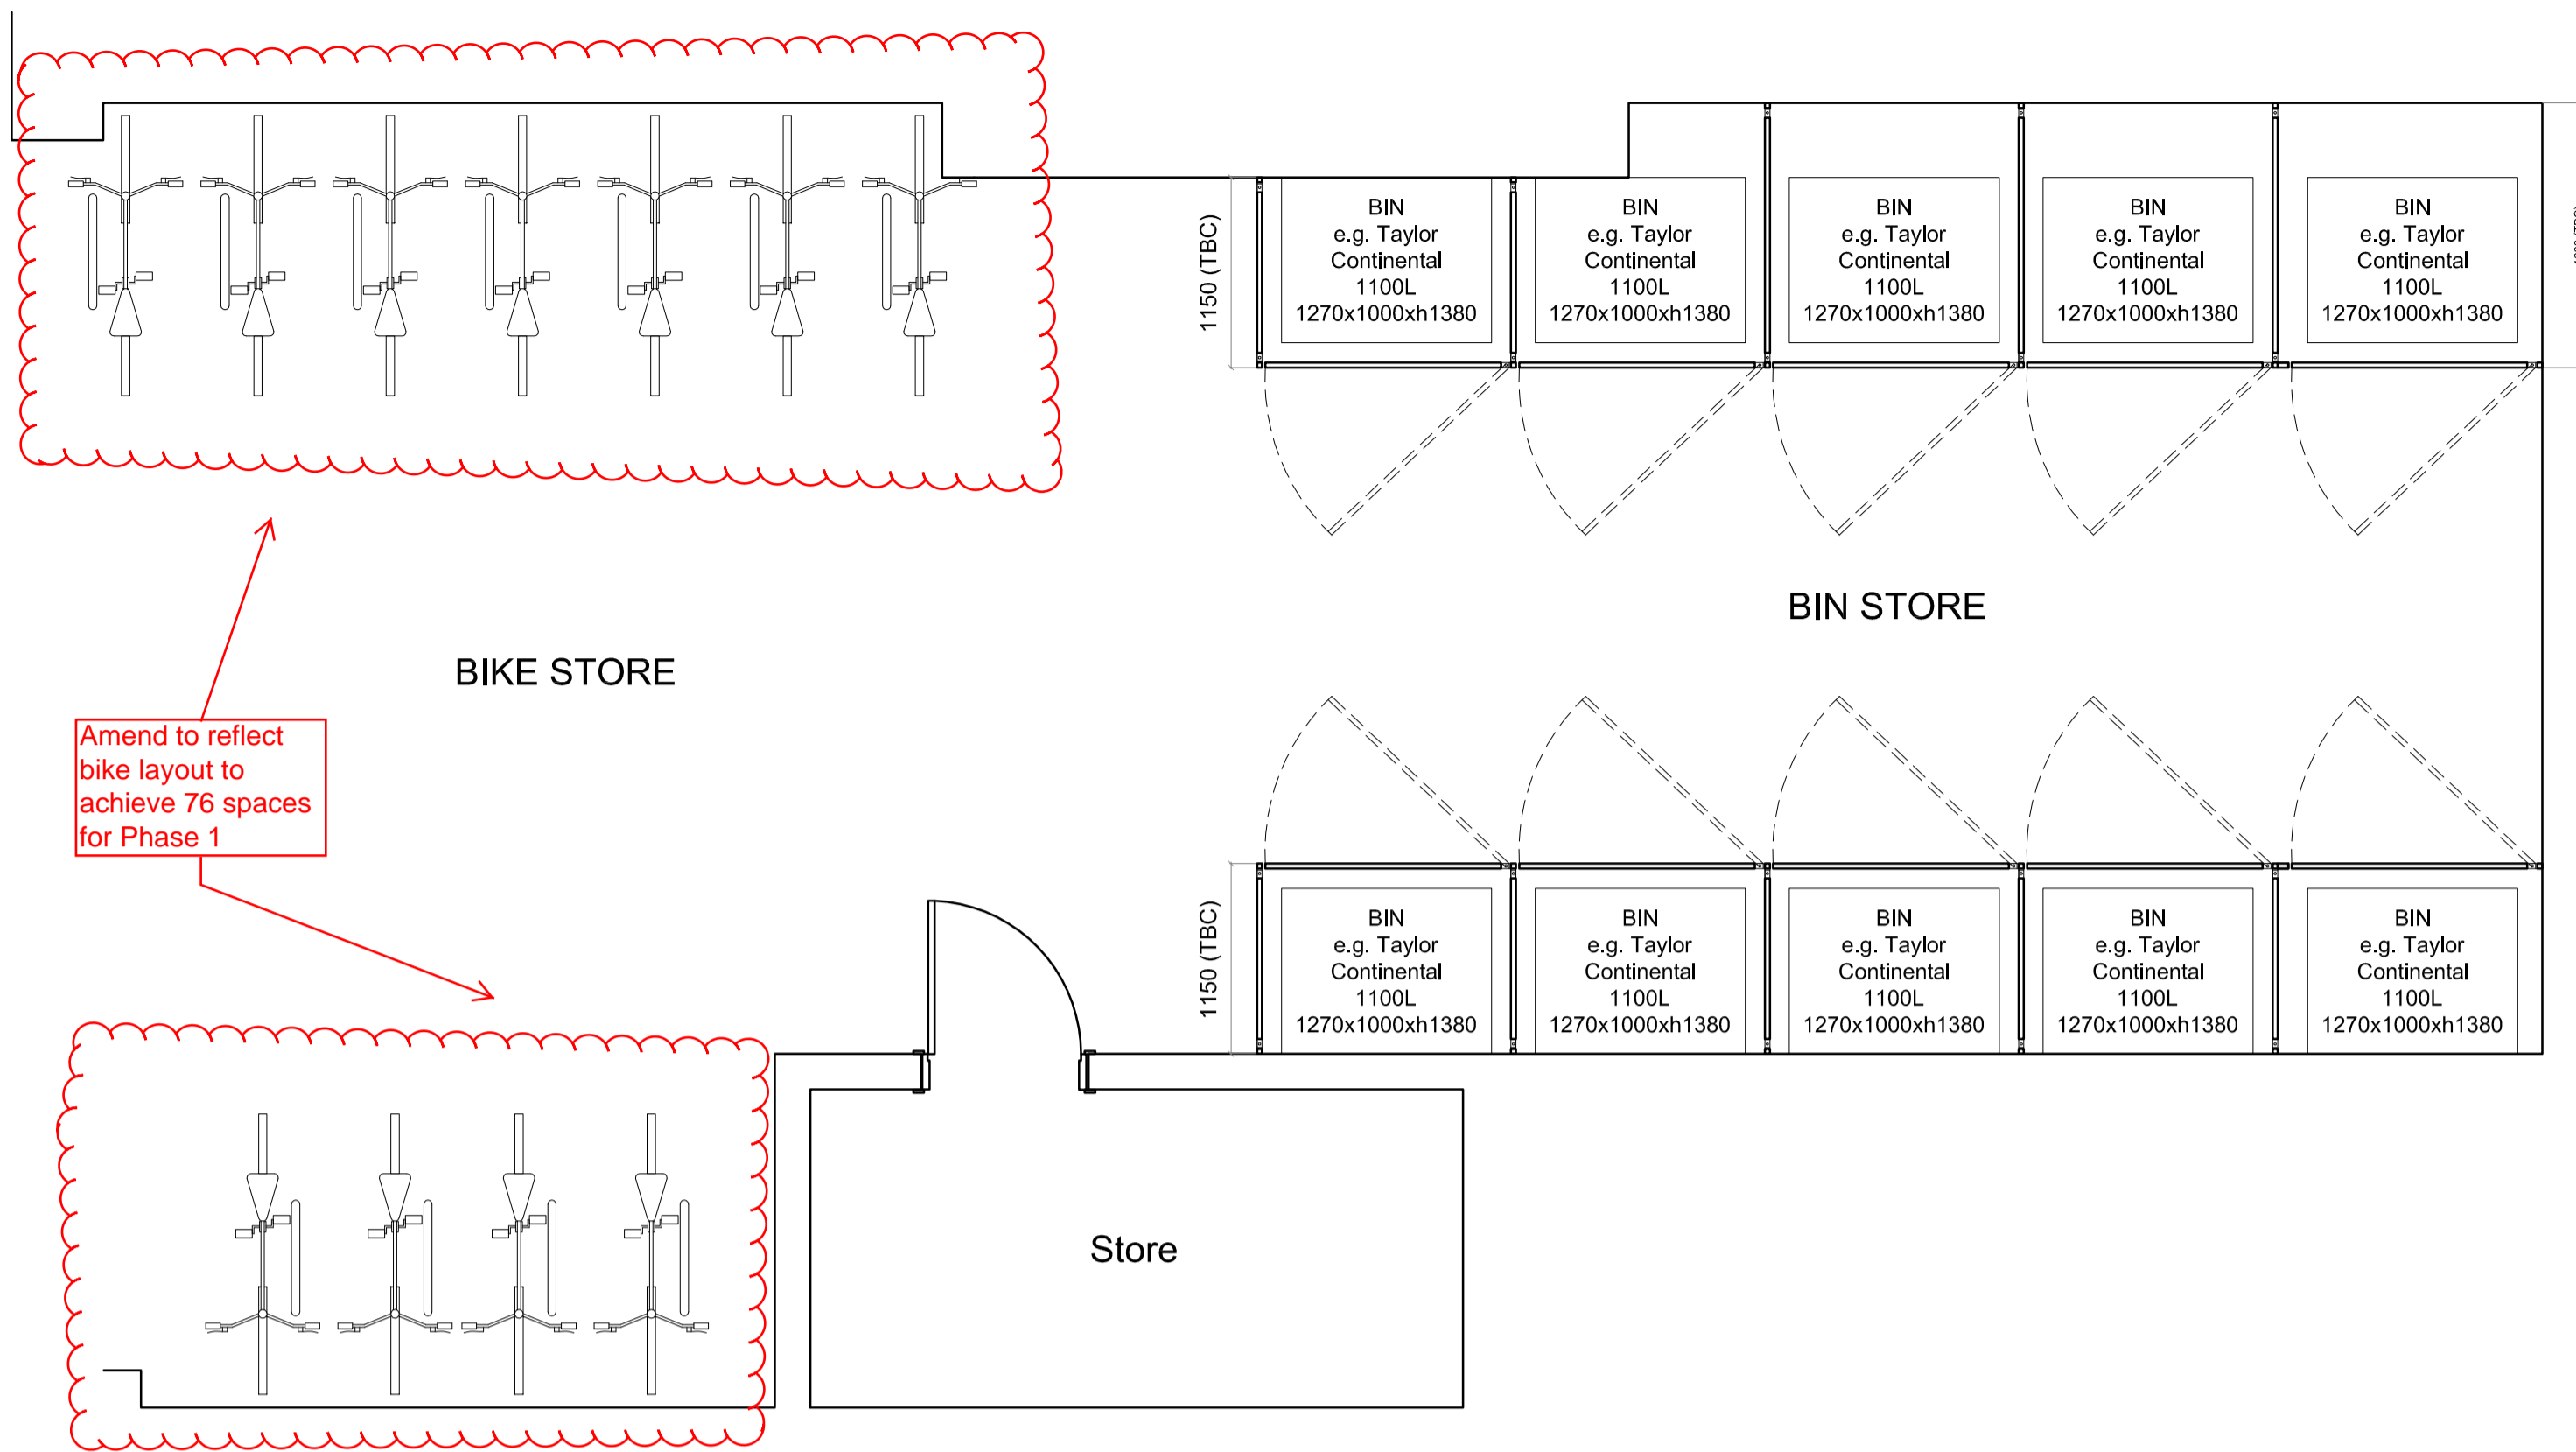


Amend to reflect bike layout to achieve 76 spaces for Phase 1

PLAN D-J-433.2 (QUARTER SCALE)

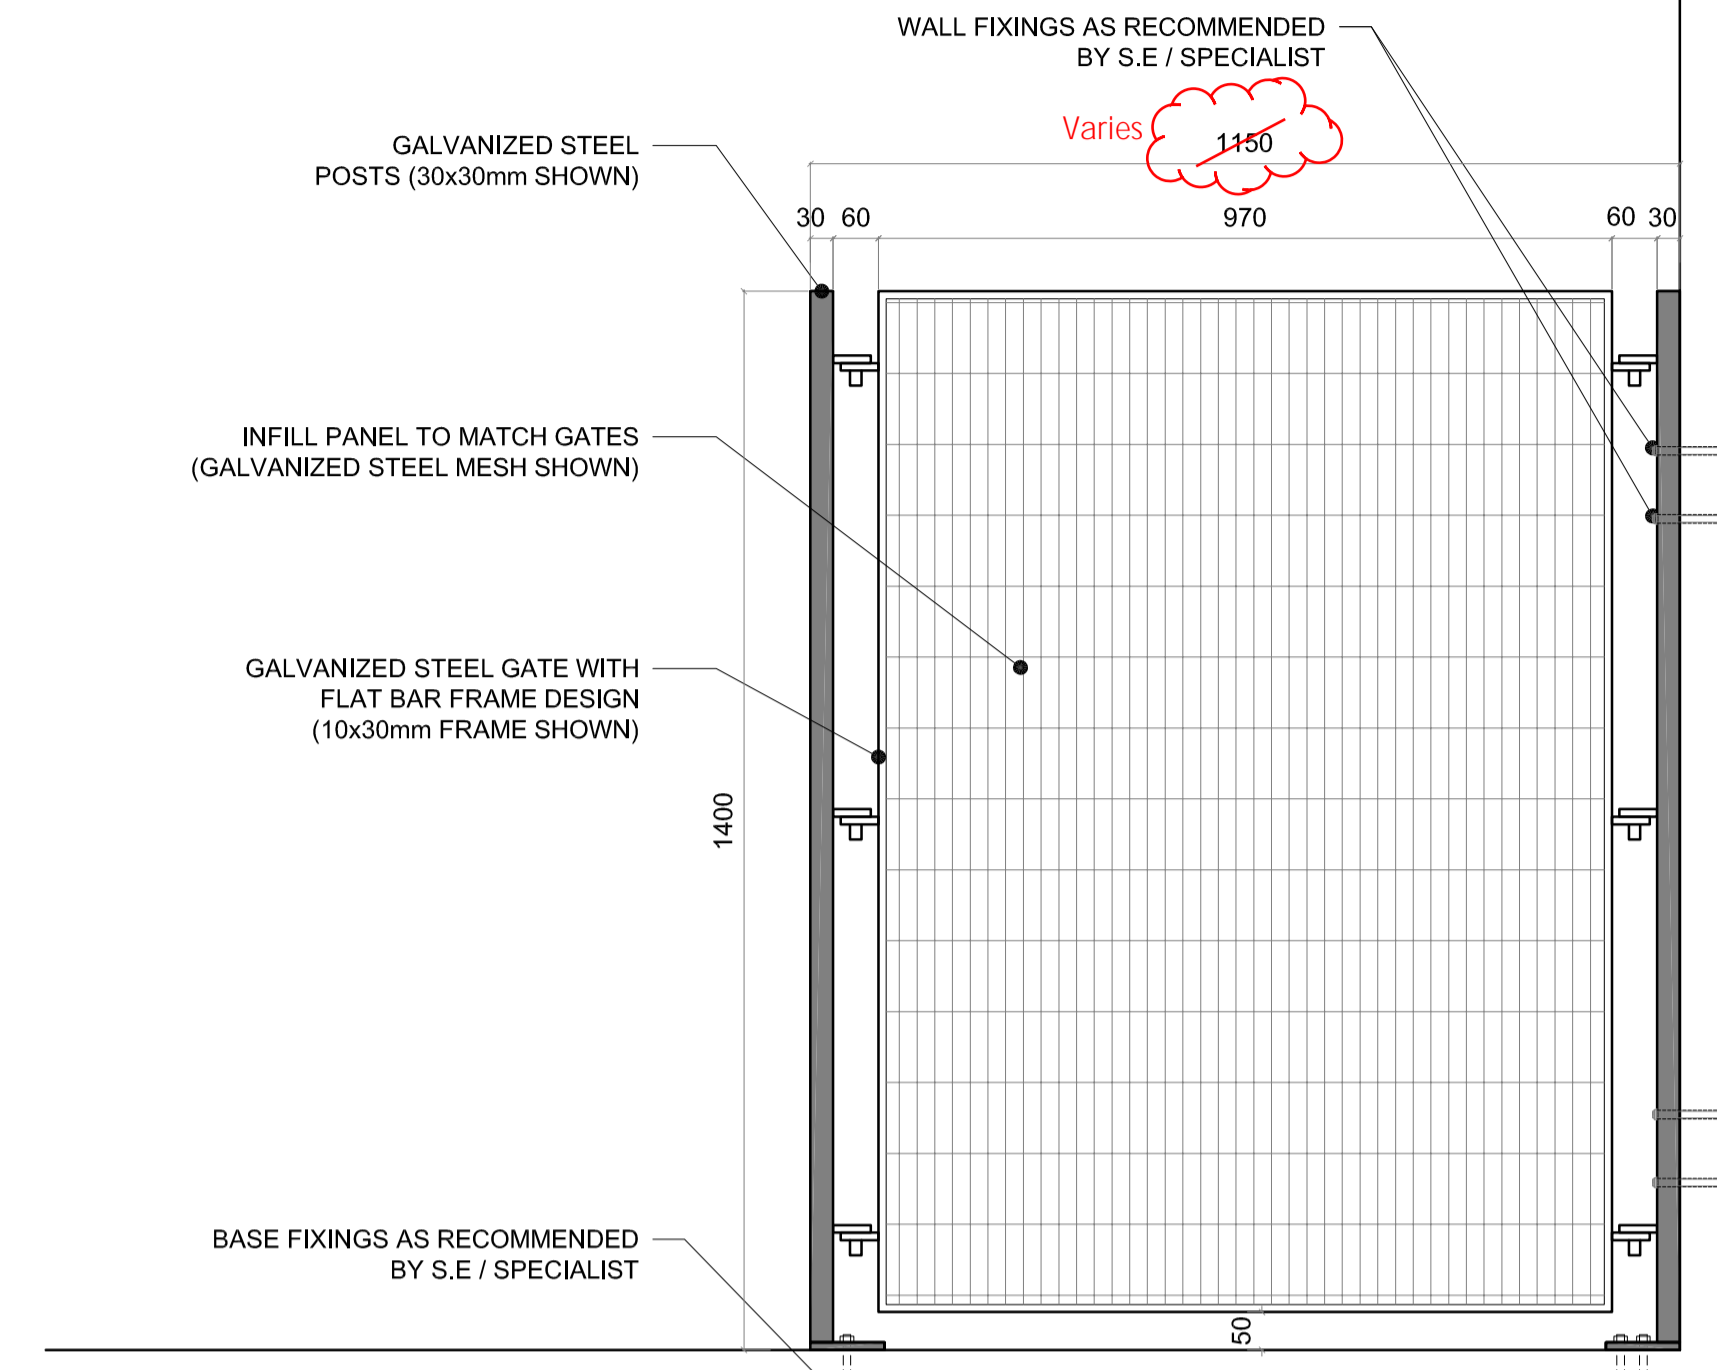

ELEVATION D-J-433.2

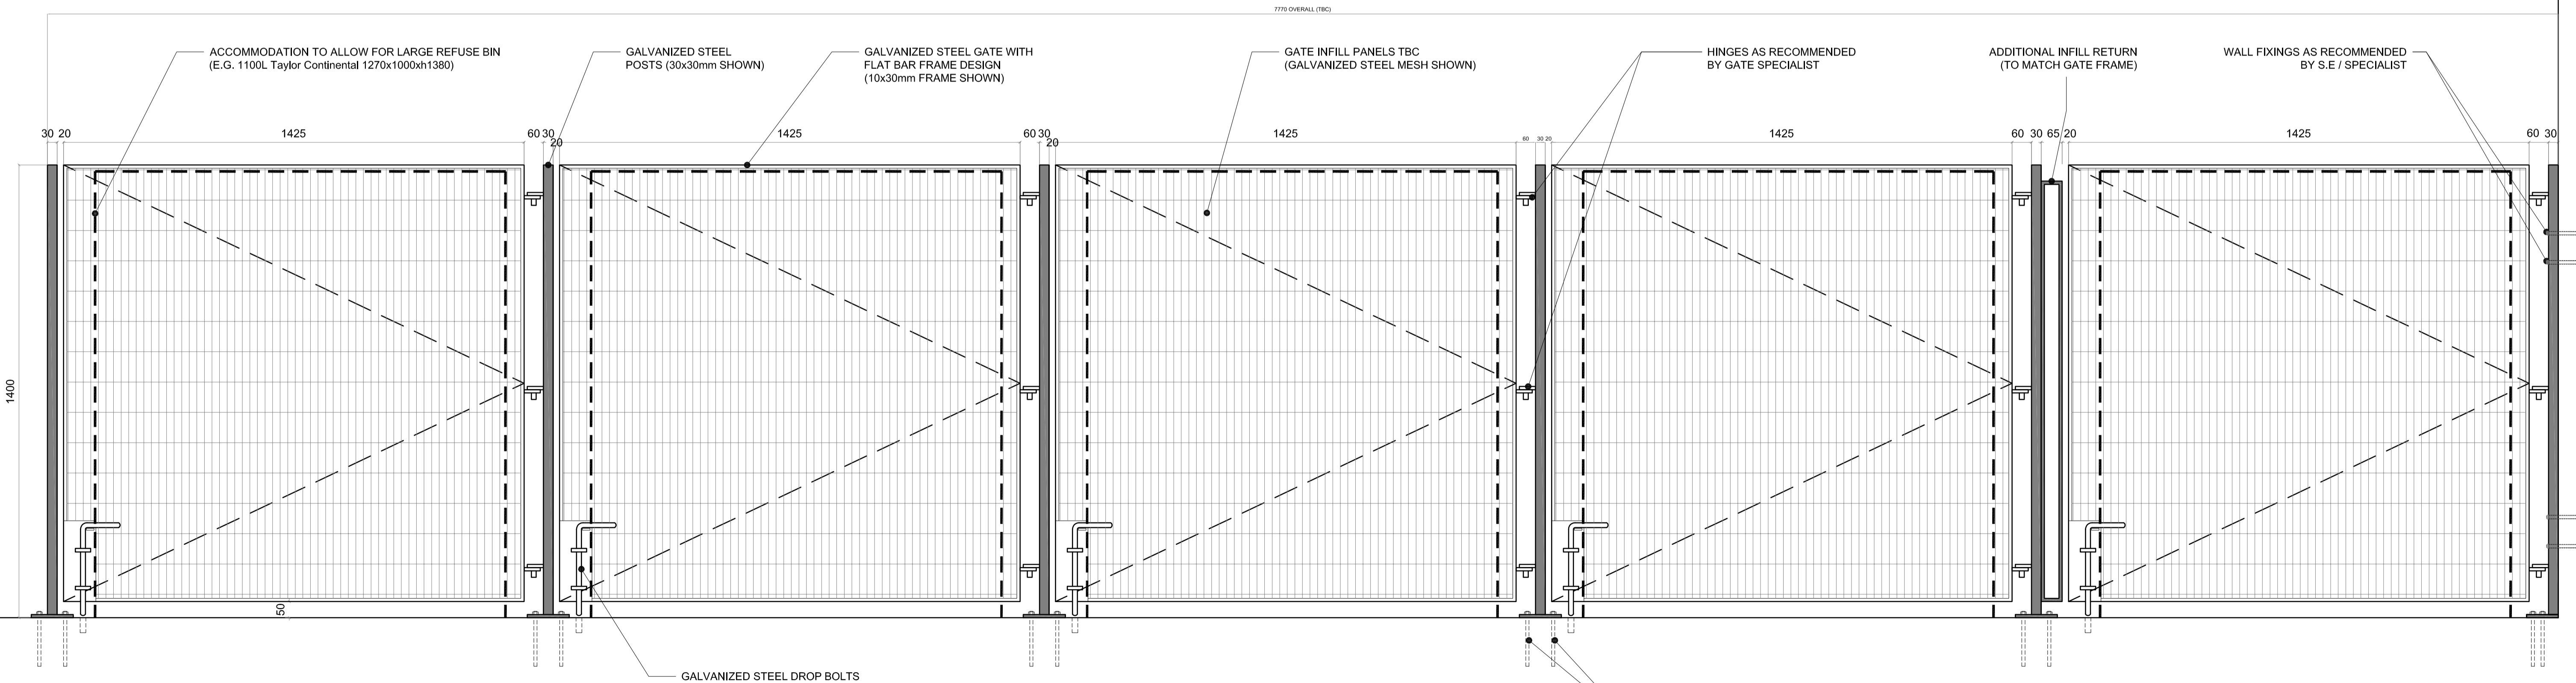

ELEVATION D-J-433.3

D-J-433 - Block A - Bin store cage