


EAST ELEVATION
AS EXISTING

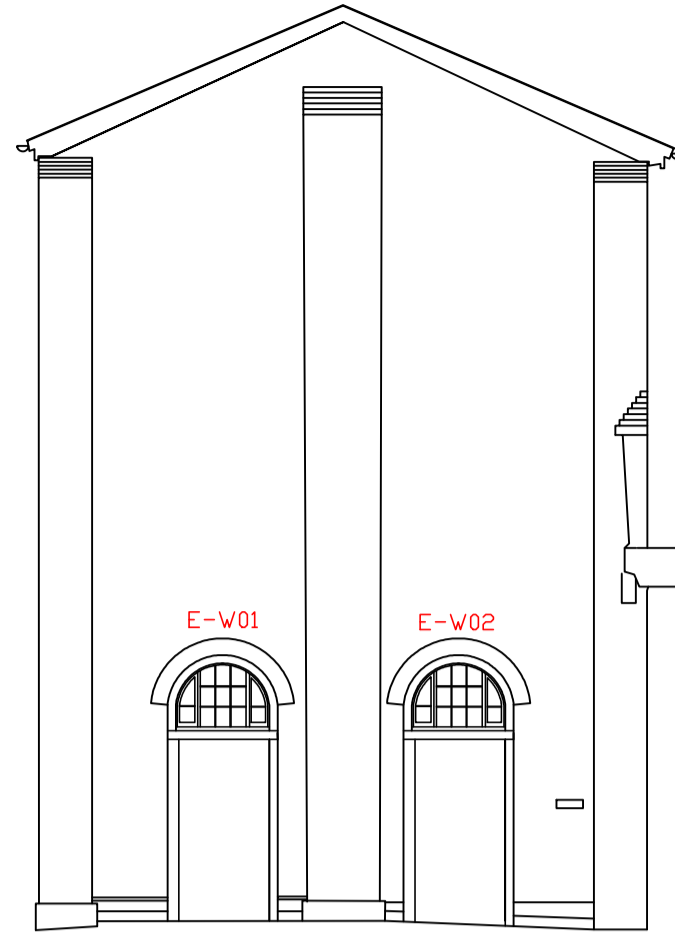


EAST ELEVATION
AS PROPOSED

Provender Stores South and East Elevations as existing and as proposed.

- Red hatching marks the window in need of replacement or repair as part of this application.



- Each window has a reference number marked in red.

- Area hatched in red on the South Elevation marks the fire damage caused in May 2014.

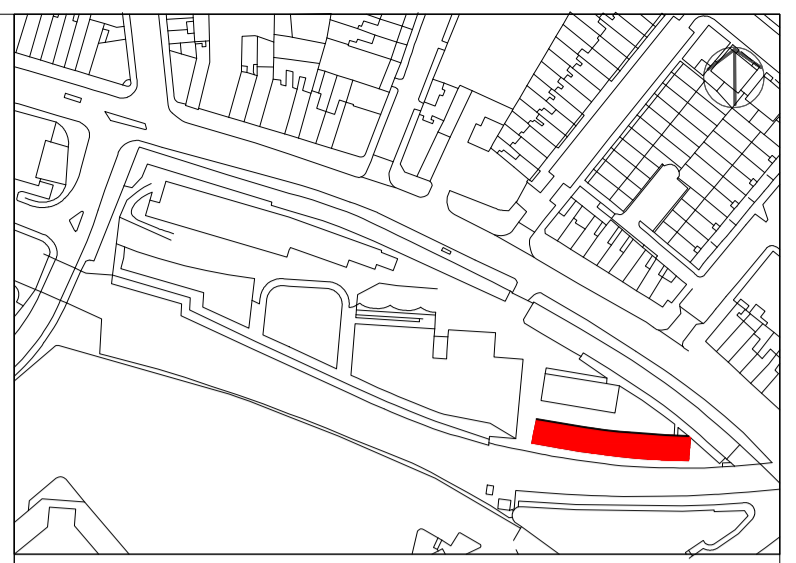


Please note that information used to produce these drawings is based on measured survey supplied by others; Heritage Architecture can not be held responsible for any inaccuracies that may exist. Please do not scale drawings. All dimensions should be verified on site.


S-W01

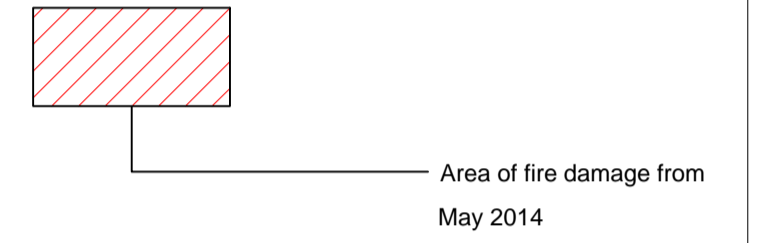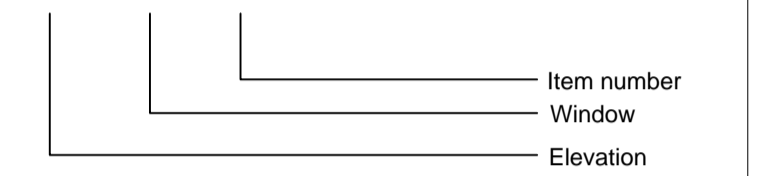

South Elevation as Existing

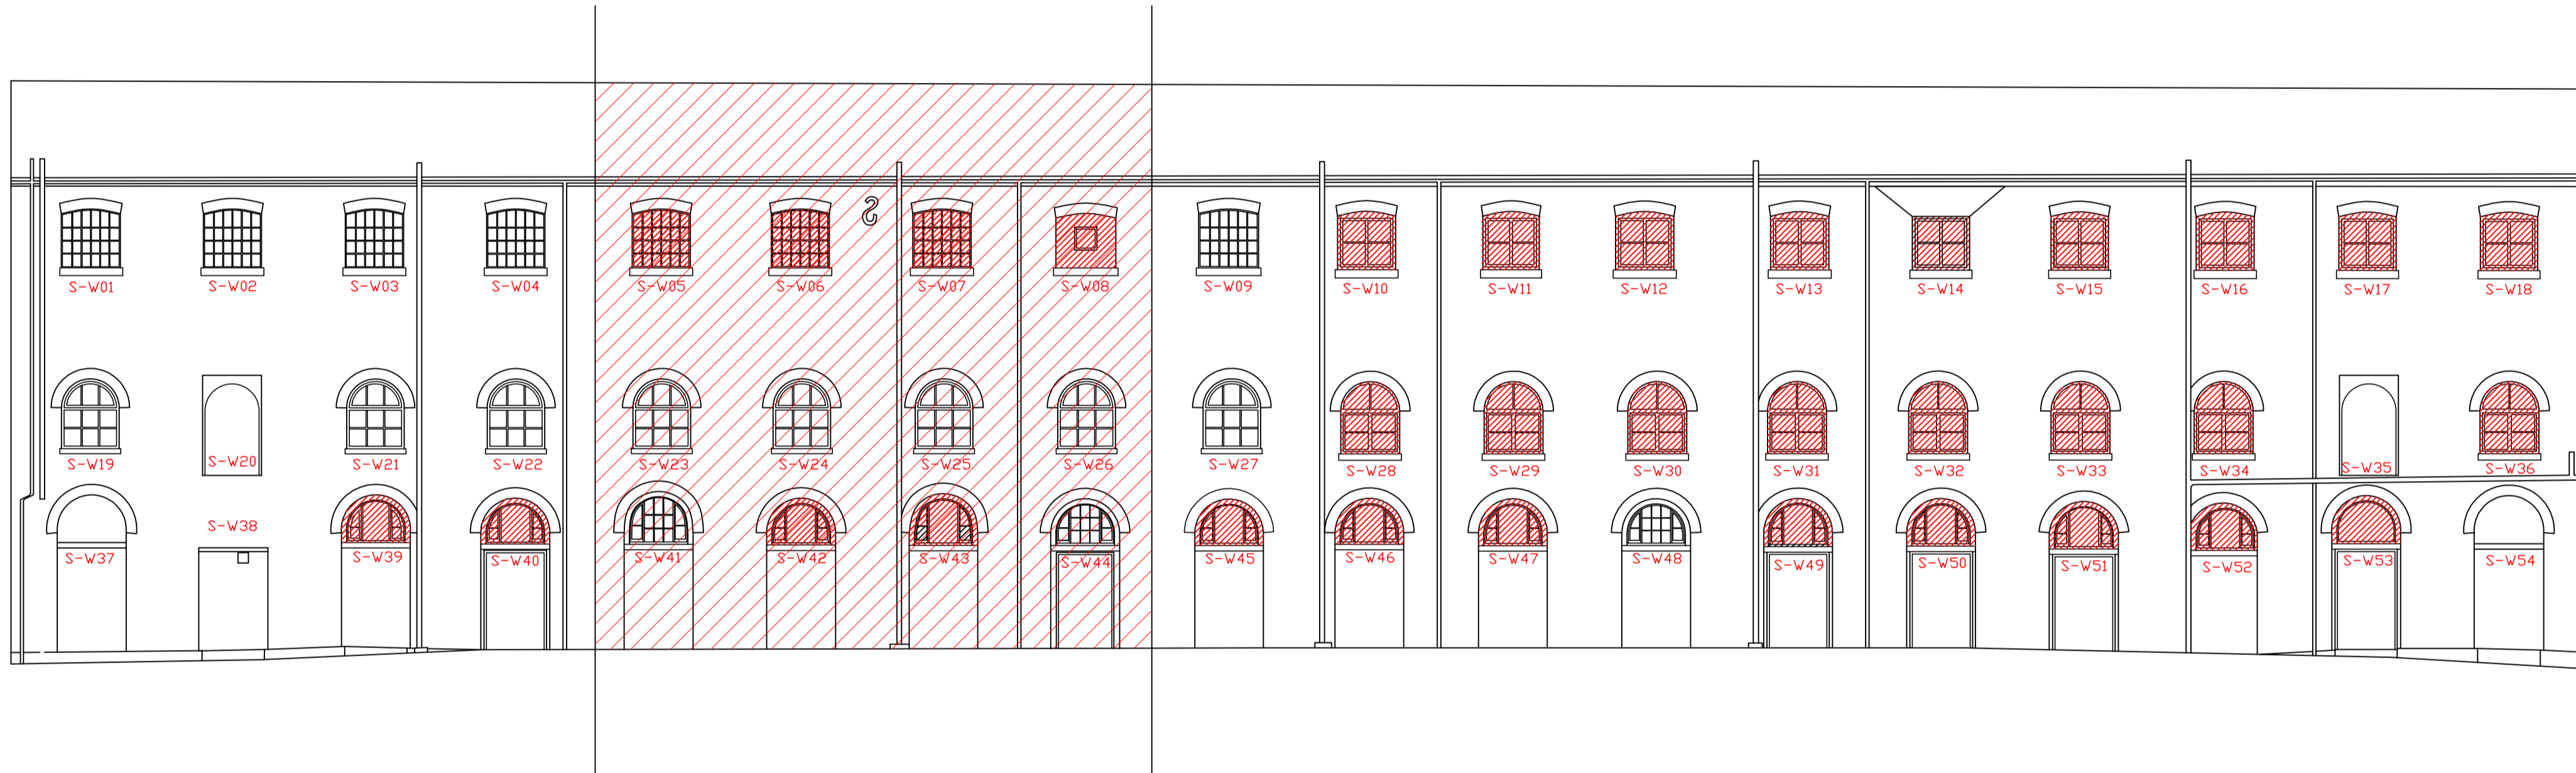

South Elevation as Proposed

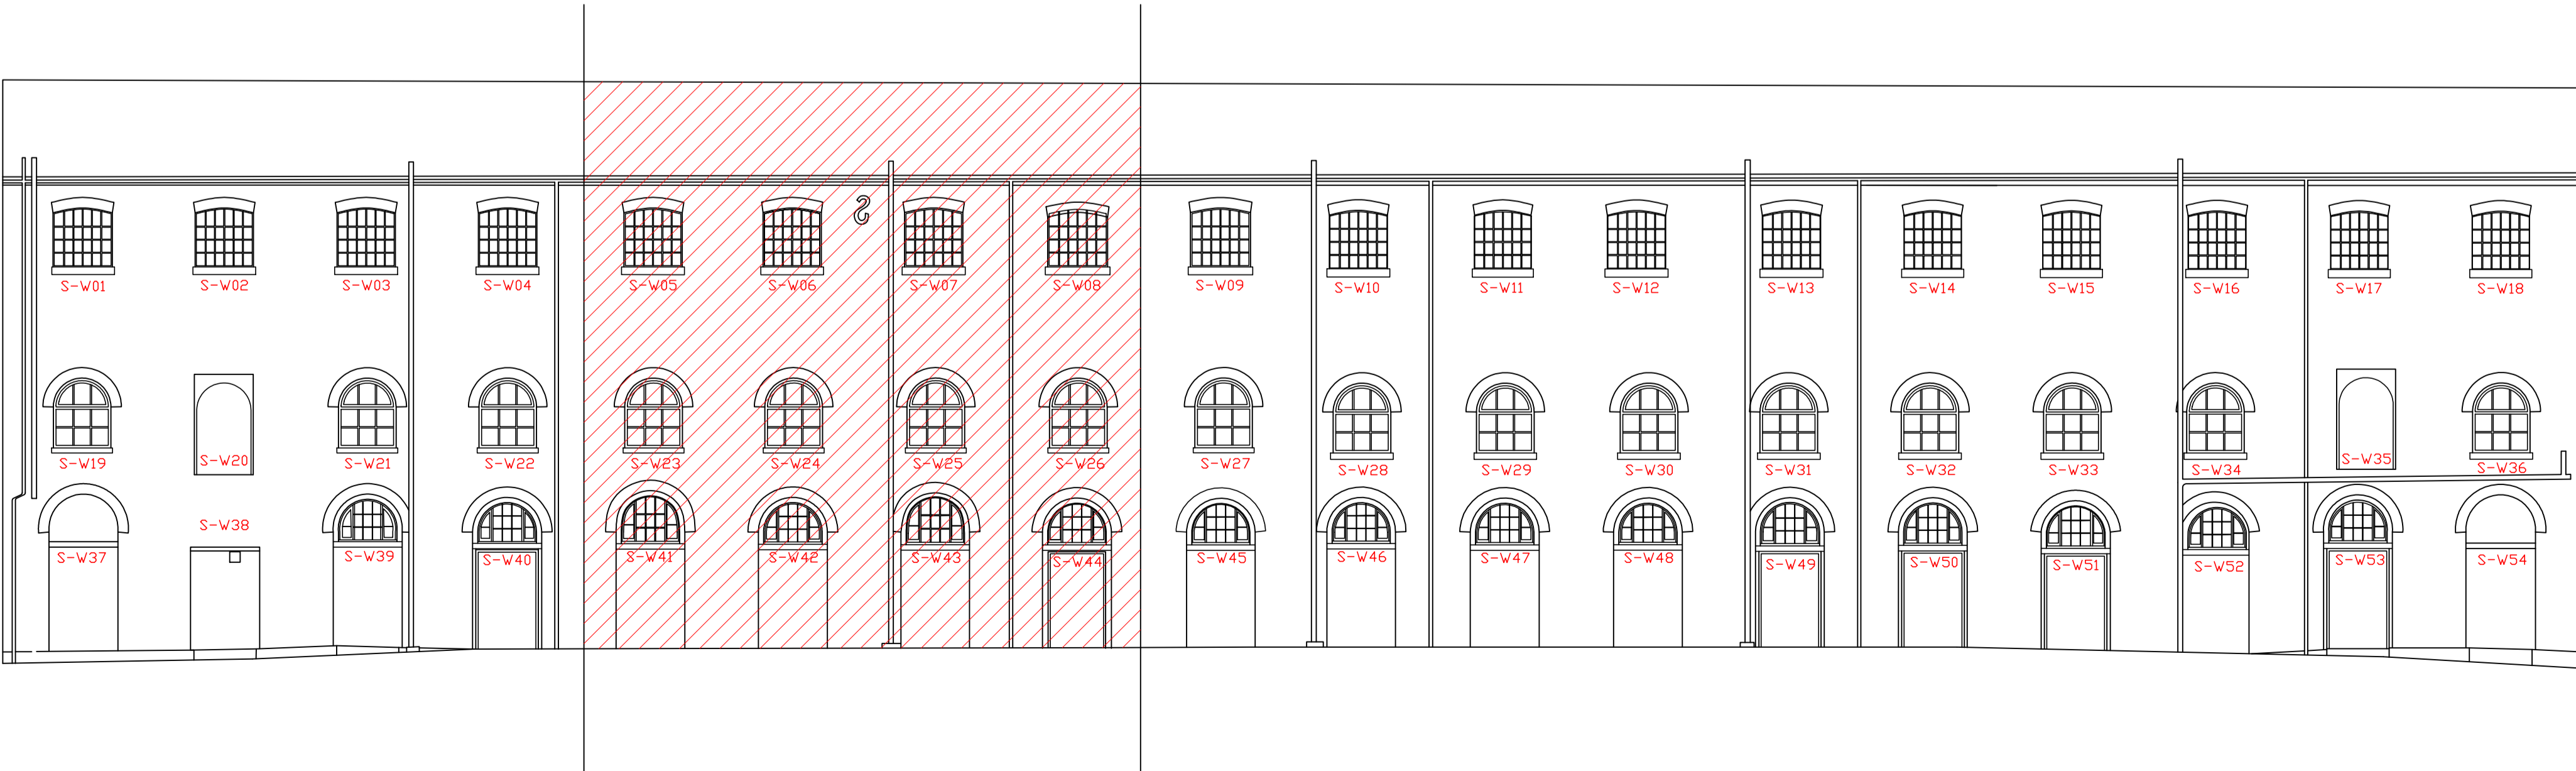

Camden Stables Market
London
NW1
United Kingdom

STANLEY SIDINGS

Camden Stable Market
Provender Stores

Drawing Title
**PROVENDER STORES
SOUTH & EAST ELEVATION WINDOWS
AS EXISTING AND AS PROPOSED**

To fit A1

Drawing Status
Planning

October 2014 Drawing No
B-SE&EE-Ref



STEPHEN LEVRANT HERITAGE ARCHITECTURE
62 British Grove, London, W4 2NL
E-mail: info@heritagemail.co.uk