

### 36 Flask Walk, London, NW3

Subterranean Construction Method Statement, and Structural Report in Support of Planning Application.

#### **Consulting Engineers**

Trigram Partnership Harling House 47-51 Gt Suffolk Street LONDON SE1 OBS

Tel: 020 7401 8100 Fax: 020 7401 8845

Email: mail@trigrampartnership.com

Job No 4266/JF/June 2015



#### 36 Flask Walk, London, NW6

#### **Structural Report in Support of Planning Application**

#### **Contents**

1.	Introduction	3
2.	Description of 36 Flask Walk and Adjoining Properties	3
3.	Proposed Structural Works	4
4.	Ground Conditions	5
5.	Hydrogeology	5
6.	Ground Stability	6
7.	Basement Construction	6
8.	Underpinning	6
9.	Trees	6
10.	Buried Services and Tunnels	7
11.	Monitoring	7
12.	Indicative Construction Sequence for the Works	7
13.	Conclusion	7
App	endix A - Indicative Construction Sequence	9
App	endix B - Designer's Risk Assessment Summary	.10
App	endix C - Underpinning Specification	.11
Арр	endix D - Temporary Works Specification	.12
Арр	endix E - Concept Drawings	.13
App	endix F - Structural Exposures, Trial Pits	.14
Ann	andix G. Structural Schome Calculations	15



#### 1. Introduction

This structural report has been prepared for the purpose of supporting the planning application for the construction of a single storey basement under no. 36 Flask Walk, NW3 1HE, and should not be used for any other purposes.

The extent of the proposed subterranean development covers the footprint of the existing building and front garden. A large open light well in the front garden allows natural light and ventilation to the new basement.

The report is limited in scope to that which is necessary to demonstrate a suitable construction method and sequence that will ensure the structural integrity of the building, the adjoining structures, public thoroughfares and buried structures.

#### 2. Description of 36 Flask Walk and Adjoining Properties

No. 36 Flask Walk is a three storey mid-terrace property within the Hampstead Conservation area, and appears to have been built late 1970's together with Nos. 32 & 34.

The building is of semi-traditional construction, having masonry walls, timber stud partitions, timber joist floors to all levels and timber roof. The floor joists span between the Party Walls to no. 34 and no. 38 Flask Walk.

The second floor has a mansard roof clad with slates. The mansard roof has been set back from the main elevations to form inboard gutters, and there is one large dormer at the front and two smaller dormers at the rear.

The ground floor is elevated above street level and under the ground floor there is an approximately 0.8 m deep unobstructed crawl space which occupies the full footprint of the property.

The property has a small patio at the rear, below which there is a communal underground car parking area.

A visual inspection suggests that the property has not been altered from its original configuration. The property, and the adjoining properties, appears to be in sound condition, and no signs of noticeable historic movements are apparent.

The ground floor area of no. 34 provides the access and hall way to its first floor. The remaining ground floor area is the access ramp down to the basement car park behind nos. 32, 34 and 36.

Two trial pits were excavated in order to investigate the foundations to the party walls at their respective locations.



In the case of the foundation to the party wall 36/38 Flask Walk a traditional corbelled brick foundation resting on a concrete base was observed. The underside of the existing foundation is at level 101.40, i.e. approximately 2.6 m below the existing ground floor level, and protrudes 300 mm from the face of the masonry wall.

In the case of the foundation to the party wall 34/36 Flask Walk the underside was encountered at level 101.16, which is approximately 0.8 m below the finished floor level of the communal parking area behind 36 Flask Walk. This indicates that the foundation is generally set at a constant level.

The concrete foundation was measured to be 500 mm deep and protrude 800 mm from the face of the masonry wall, and despite the geometry suggesting otherwise the foundation appeared to be unreinforced.

#### 3. Proposed Structural Works

It is proposed to construct a new basement under the existing building extending out to the boundary with the public footpath.

By extending the basement beyond the foot print of the existing building it becomes possible to include a cloakroom beneath the access steps and a good sized light well. The latter significantly improving the natural light and ventilation to the new basement.

The Structural Surface Level (SSL) for the new basement will be approximately 3.1 m below the Finished Floor Level (FFL) of the existing ground floor. Thus, the excavation for the new basement will entail a general lowering of the existing Ground Level (GL) within the crawl space of 36 Flask Walk by approximately 2.3 m.

The level of the oversite concrete under the building corresponds well to the level of the road surface in front of the property.

The basement slab will be designed in reinforced concrete to accommodate the heave forces associated with the removal of a overburden on the clay strata as well as pressures arising from the assumed ground water regime.

All reinforced concrete works will be specified as 'water tight concrete construction', but in addition there will be a drained cavity to achieve a grade 3 level of protection against water ingress.

The use of the property will be retained as 'residential' therefore the loadings on the suspended floors will remain as existing.



#### 4. Ground Conditions

According to British Geological Survey, sheet 256, Solid and Drift edition, the underlying soils for locality comprise an up to 30 m thick layer of Claygate Beds overlaying London Clay.

A comprehensive site specific geotechnical investigation was undertaken by Chelmer Site Investigations. The investigation involved sinking 2 no. boreholes from within the property to a depth of 10.0 m below the ground floor level. Their Factual Report, Geoenvironmental Report and Basement Impact Assessment are submitted with this report.

Based on the data from their investigation the stratigraphy under 36 Flask Walk is summarised as follows:

0.0 m - 0.8 m	BGL	Made Ground
0.8 m - 4.3 m	BGL	Re-worked Ground (Sandy Clay)
4.3 m - 5.7 m	BGL	Weathered Claygate (Silty Clay)
5.7 m - 8.8 m +	BGL	Claygate/London Clay

Thus, similar to the existing foundations the new foundations will all be located within the Re-worked Ground strata.

The geology was determined to have good loadbearing characteristics, and a safe bearing pressure of 160 kN/m<sup>2</sup> was reported to be applicable at the underside of the new foundations.

The concrete and the cover to any reinforcement will be specified in accordance with the aggressive chemical environment reported for this site.

#### 5. Hydrogeology

The records taken from the installed standpipes showed the presence of groundwater at relatively high levels. The highest of which almost coincided with the level of the underside of the new Party Wall foundations.

However, the hydrogeological investigation suggests that the water encountered is water perched in localised silt pockets within the Re-worked Ground strata, and there is no evidence of significant water flow across the site. Thus, it is anticipated that any adverse impact on the groundwater flow from the construction of the basement will be minimal.

In accordance with the recommendations by the geotechnical specialists the new structure will (as a precaution) be designed in the short-term condition for a groundwater level equal to the ground level, and in the long-term condition for a water level standing 0.5 m below ground.

There are no known water courses in close proximity to the site.



#### 6. Ground Stability

There are no steep areas and the proposed basement excavation raise no concern in relation to the overall stability of the 4.5 degree slope across the site.

Owing to the re-worked nature of the ground, full ground support will be installed as the excavations for the proposed basement are progressed.

In general normal precautions in supporting the ground around the basement should be taken, though when undercutting for the spreader footings in the Re-worked Ground special provisions need to be put in place to ensure the stability of the roof of these excavations at all time.

#### 7. Basement Construction

The structural form of the proposed basement will comprise reinforced concrete underpins to the party walls. The width of the new footings to will match the width of the existing footings.

We expect the excavation to remain dry during construction, though minor pumping may be required during construction in the event a pocket of groundwater were encountered.

The necessary provisions for supporting the footpath and the road will be put in place by means of shoring designed for appropriate surcharges.

Temporary works will be required during underpinning and construction of retaining RC walls, and will be maintained until the necessary permanent supports have been established.

#### 8. Underpinning

A 1-in-5 underpin sequence will be adopted to minimise the risk of induced settlement.

Some cracking may nevertheless occur, but should be category 0-1 (BRE categories), so would be cosmetic and repairable using normal decorating techniques. Such repairs would be the responsibility of the Building Owner, and be covered by a Party Wall Award.

#### 9. Trees

According to the guidelines by NHBC the new basement will be located within the zone of influence of the nearest trees. The nearest larger tree is located on the opposite side of Flask Walk at a distance of approximately 9 m.



The new foundations will all be founded within soils characterised as having medium volume change potential and will be sufficiently deep so as not to be affected by the trees and seasonal moisture movements.

#### 10. Buried Services and Tunnels

Tunnels for the Northern Line are known to pass close to the west of the site, though at a considerable depth. London Underground will have to confirm that the proposed basement is outside any of their exclusion zones prior to commencing construction.

No detailed information is available regarding existing and buried services, such as drainage runs, gas and electricity services, and a survey will have to be carried out prior to commencing construction.

As noted above, services in the public footpath and highway will be protected from ground movements. Those serving this property will be modified as part of these works.

#### 11. Monitoring

It is proposed that reflective targets are affixed to the front elevations of no. 34 and no. 38 Flask Walk prior to work starting on site.

Potential building movements will be closely monitored during execution of the works, and continue until all underpinning works within the existing basement have completed, the new basement walls are constructed and restrained and that all new permanent steel works supporting the front elevation have been installed.

#### 12. Indicative Construction Sequence for the Works

A proposed sequence for the construction of the works is appended.

The Main Contractor will be responsible for defining the detailed construction sequence, and for the design of all temporary works. The design and method statements will be vetted by the Design Team prior to implementation.

#### 13. Conclusion

By adopting these measures, the proposed basement extension can be constructed with no detrimental effect to the structural integrity or stability of the house or the existing structures adjoining or adjacent to the house.



This Report was prepared by:

Dr Jesper Friis, BSc, MSc, PhD

Bruce Huxtable, CEng, MIStructE, MICE, MSt, BSc (Hons)

June 2015



#### **Appendix A - Indicative Construction Sequence**

- Install monitoring targets in accordance with the requirements of the Party Wall Award.
- Install waling beams and props to replace the restraining effect of the timber floor during construction.
- Remove the existing ground floor joists to facilitate excavation for new basement. Install props across the site.
- Install Temporary Works piles on either side of front façade, carry out integrity tests and construct pile caps.
- Position two no. primary beams on top of the pile caps parallel with the existing wall.
- Needle through the existing wall. Needles supported on primary beams, and dry pack.
- Transfer weight of façade to Temporary Works, allowing the existing foundations to the front elevation to be removed in due course.
- General level reduction. Check integrity and 'plumbness' of exposed piles.
   Excavate to underside of existing footing (platform level)
- Working from platform level excavate to form 1 in 5 of the underpins. Install full support, trench shoring, as the excavation progress.
- Construct bases of underpins.
- Fix reinforcement, erect shutters and concrete stems of underpins.
- Strike shutters when concrete has gained sufficient strength, and dry pack.
- Excavate trench between pins of opposite wall, fix reinforcement and cast strip of basement slab. Props across the site will be in place and adjusted during the excavation of the trench.
- Install temporary lateral propping at front construct retaining walls.
- Complete all underpins, infill slabs and construct front retaining walls.
- Install steel box frame to support front façade.
- Remove Temporary Works needles, break down and remove pile caps and piles.



#### **Appendix B - Designer's Risk Assessment Summary**

#### <u>General</u>

The works involve excavations below an existing building.

#### Particular Residual Risks

Full ground support will be necessary during the excavation of the underpins, and all other excavations in the reworked soils.

The basement excavation will extend beyond the front façade. The façade will be supported on temporary works propping, using RC piles as columns. Therefore, these piles must be designed to provide vertical support and lateral stability. The piles integrity is to be confirmed during the excavation phase. The piles/columns are to be designed as if out of plumb, but within the specified 1 in 75 tolerances.



#### **Appendix C - Underpinning Specification**

The general specification will be in accordance with the Standard Detail D80, overleaf.

The main contractor will produce a layout drawing defining the bays and sequence, to take account of the particular site features. This will be reviewed in principle by the design team.



HARLING HOUSE 47-51 GREAT SUFFOLK ST TEL: 0171 401 8100 FAX: 0171 401 8845

Job No	Sheet No	Rev
	D 80	

#### STANDARD DETAIL

TYPICAL UNDERPINNING DETAILS.

#### GENERAL NOTES.


(REF. CIRIA REPORT 111: STRUCTURAL RENOVATION OF TRADITIONAL BUILDINGS).

- A. THE CONTRACTOR IS TO SUBMIT FOR APPROVAL THEIR LAYOUT PLAN SHOWING THE PROPOSED PIN LAYOUT AND SEQUENCE.
- B. HEALTH AND SAFETY FILE / RECORD DRAWINGS: COLLATE AND SUBMIT A FULL SET OF RECORDS FOR INCLUSION IN HEALTH AND SAFETY FILE.

  CONTENT FOR EACH UNDERPINNING BLOCK RECORD: DATE OF CASTING; DEPTH OF BASE BELOW DATUM; LENGTH; WIDTH EITHER SIDE OF WALL; DETAILS OF DRAINS AND SERVICES BUILT INTO BLOCK AND DIAMETER OF SLEEVING. (LATEST DAY FOR SUBMISSION: 14 DAYS AFTER COMPLETION.)
- C. UNDERPINNING (EXCAVATION, CONCRETING & DRY PACKING) IS TO BE CARRIED OUT IN THE NUMERICAL SEQUENCE SHOWN i.e. BAY(S) 1 FOLLOWED BY BAY(S) 2 etc.
- D. NO UNDERPINNING BAY(S) IS TO BE STARTED UNTIL THE PREVIOUS BAY IN THE NUMERICAL SEQUENCE HAS BEEN COMPLETED.

#### CONSTRUCTION SEQUENCE.

- 1. EXCAVATE TO UNDERSIDE OF PROPOSED UNDERPINNING BAY INSTALLING APPROPRIATE SHORING AS NECESSARY TO FORM BAY PROFILE WHILE KEEPING THE WORKS FREE FROM GROUND WATER.
- 2. SET UP SIDE FORMWORK AS REQUIRED.
- 3. CAST CONCRETE FOR BAY UP TO 75mm BELOW UNDERSIDE OF EXISTING FOUNDATION. (CONCRETE GRADE FND2 DESIGNATED MIX TO B.S.8500.)
- 4. ALLOW 2 DAYS FOR CONCRETE TO SET.
- 5. INSERT DRY PACK BETWEEN NEW CONCRETE AND EXISTING FOUNDATION. (DRY PACK MIX PROPORTIONS BY WEIGHT 1:3 CEMENT/SAND MIXED TO DRY CONSISTENCY)
- 6. ALLOW ONE DAY FOR DRY PACK TO SET.
- 7. CARRY OUT STEPS 1 to 6 inc. ABOVE FOR ALL OTHER NUMBERED BAYS (IN NUMERICAL SEQUENCE) UNTIL FULL LENGTH OF WALL IS UNDERPINNED.
- 8. REMOVE SIDE SHUTTER.
- 9. BACKFILL AND REMOVE SHORING AS REQUIRED.

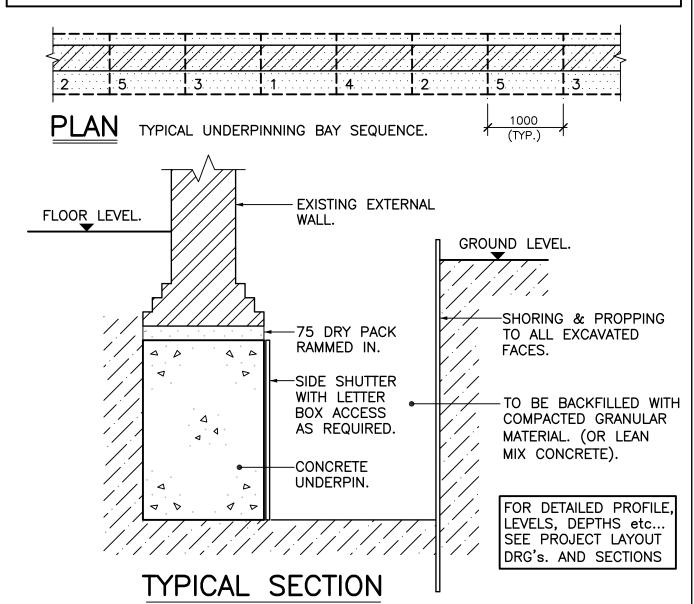

TRIGRAL PARTNERSHIP Job No Sheet No. Rev 4266 CONSULTING STRUCTURAL ENGINEERS Made By Dates Chkd 03/06/15 36 FLASTE WALK Underpinning sequence # 36 #38 EXTE 6/L 1/2// # 34 PROF STAGE 1: EXCAVATE TO UNDERSIDE OF EXISTING FOOTINGS. INSTALL PROPS ACROSS SITE PROP PROP 11/1/1/ - LATERAL GROUND

STAGE 2: CUT BACK EXISTING FOOTING

EXCAUATE TO FORM UNDERPIN AND CAST NEW MC FOOTING

SUPPORT SYSTEM

SUPPORT

SYSTEM

114714




Job No Sheet No. Rev


42 6 6

Made By Dates Chkd

36 FLASH WALK

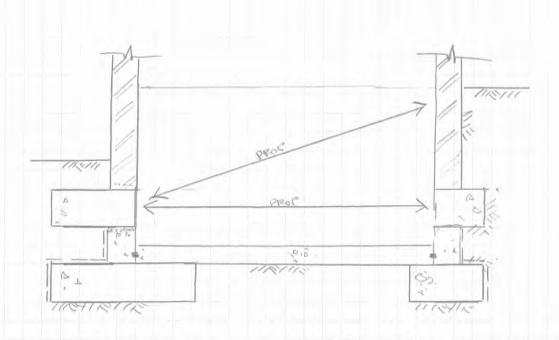

STAGE 3; SHUTTER, FIX REINFORCEMENT AND CAST WALL STUBS
STRIKE SHUTTER AND DRY PACK.
EXCAVATE TRENCH, FIX REINFORCEMENT AND CAST
BASEMENT SURB

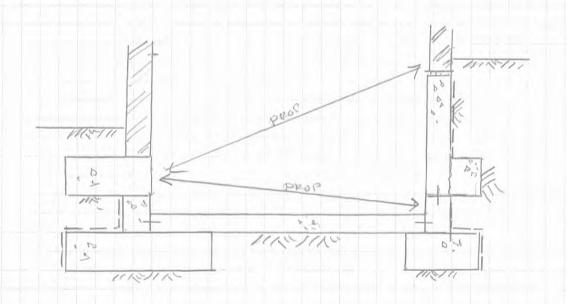

STAGE 4: PART DEMOUSH MASOURY WALL TO # 38 FLASK WALLE.

INSTACL LATERAL GROUND EOPPOINT SYSTEM.

FIX REINSTONLEMENT, SHOTTEN AND CAST RC WALL

EXTERSION.

STRIKE SHUTTER AND DRYPACK.



#### **Appendix D - Temporary Works Specification**


The main contractor will be responsible for the design of all temporary works supports for vertical loads; lateral soil pressures; and for the overall stability of the various structures.


The proposed methodology and sequence of works will be vetted by the design team. The proposed loadings will be agreed with Trigram Partnership LLP.



#### **Appendix E - Concept Drawings**

As Proposed - Sections SK.01 & SK.02

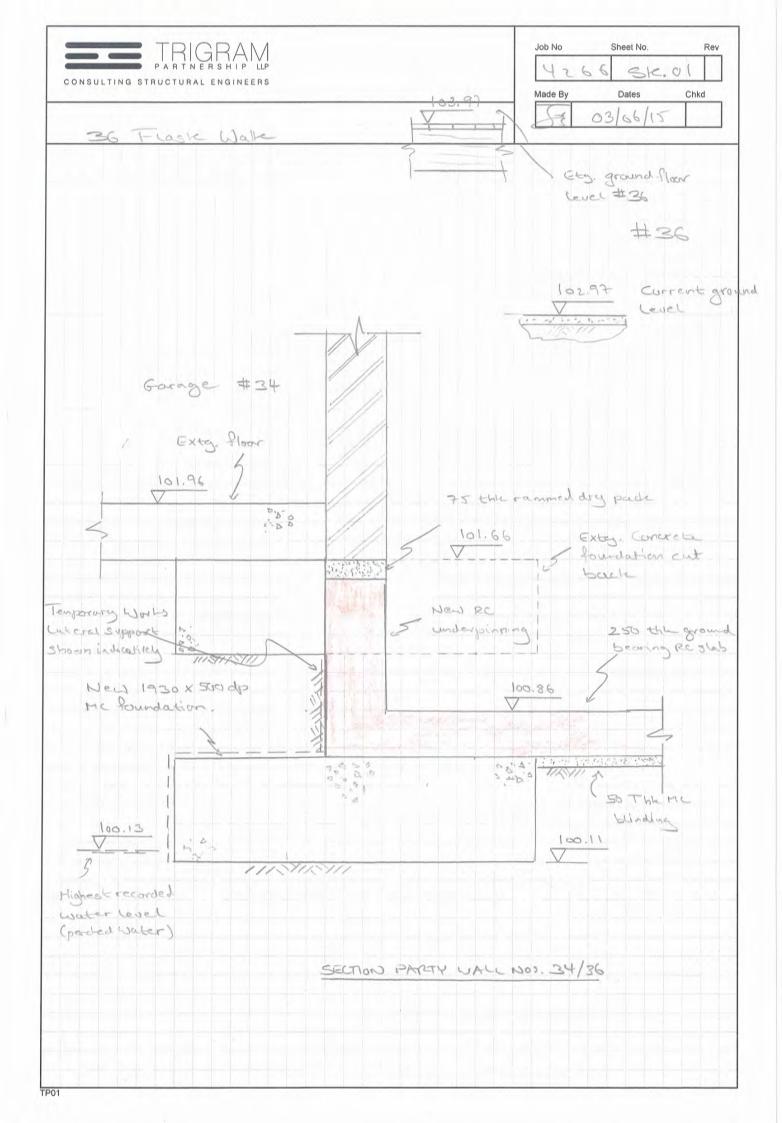


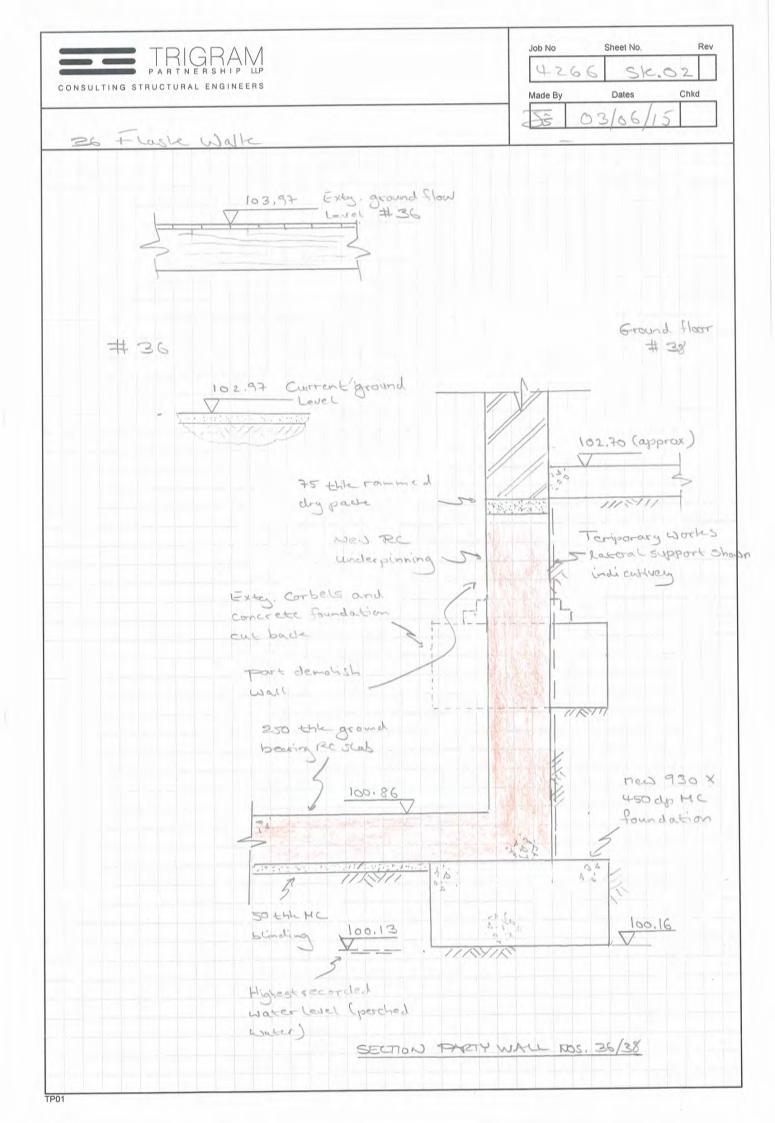



#### **Appendix F - Structural Exposures, Trial Pits**

Site Investigation Plan and Sections - SI.01

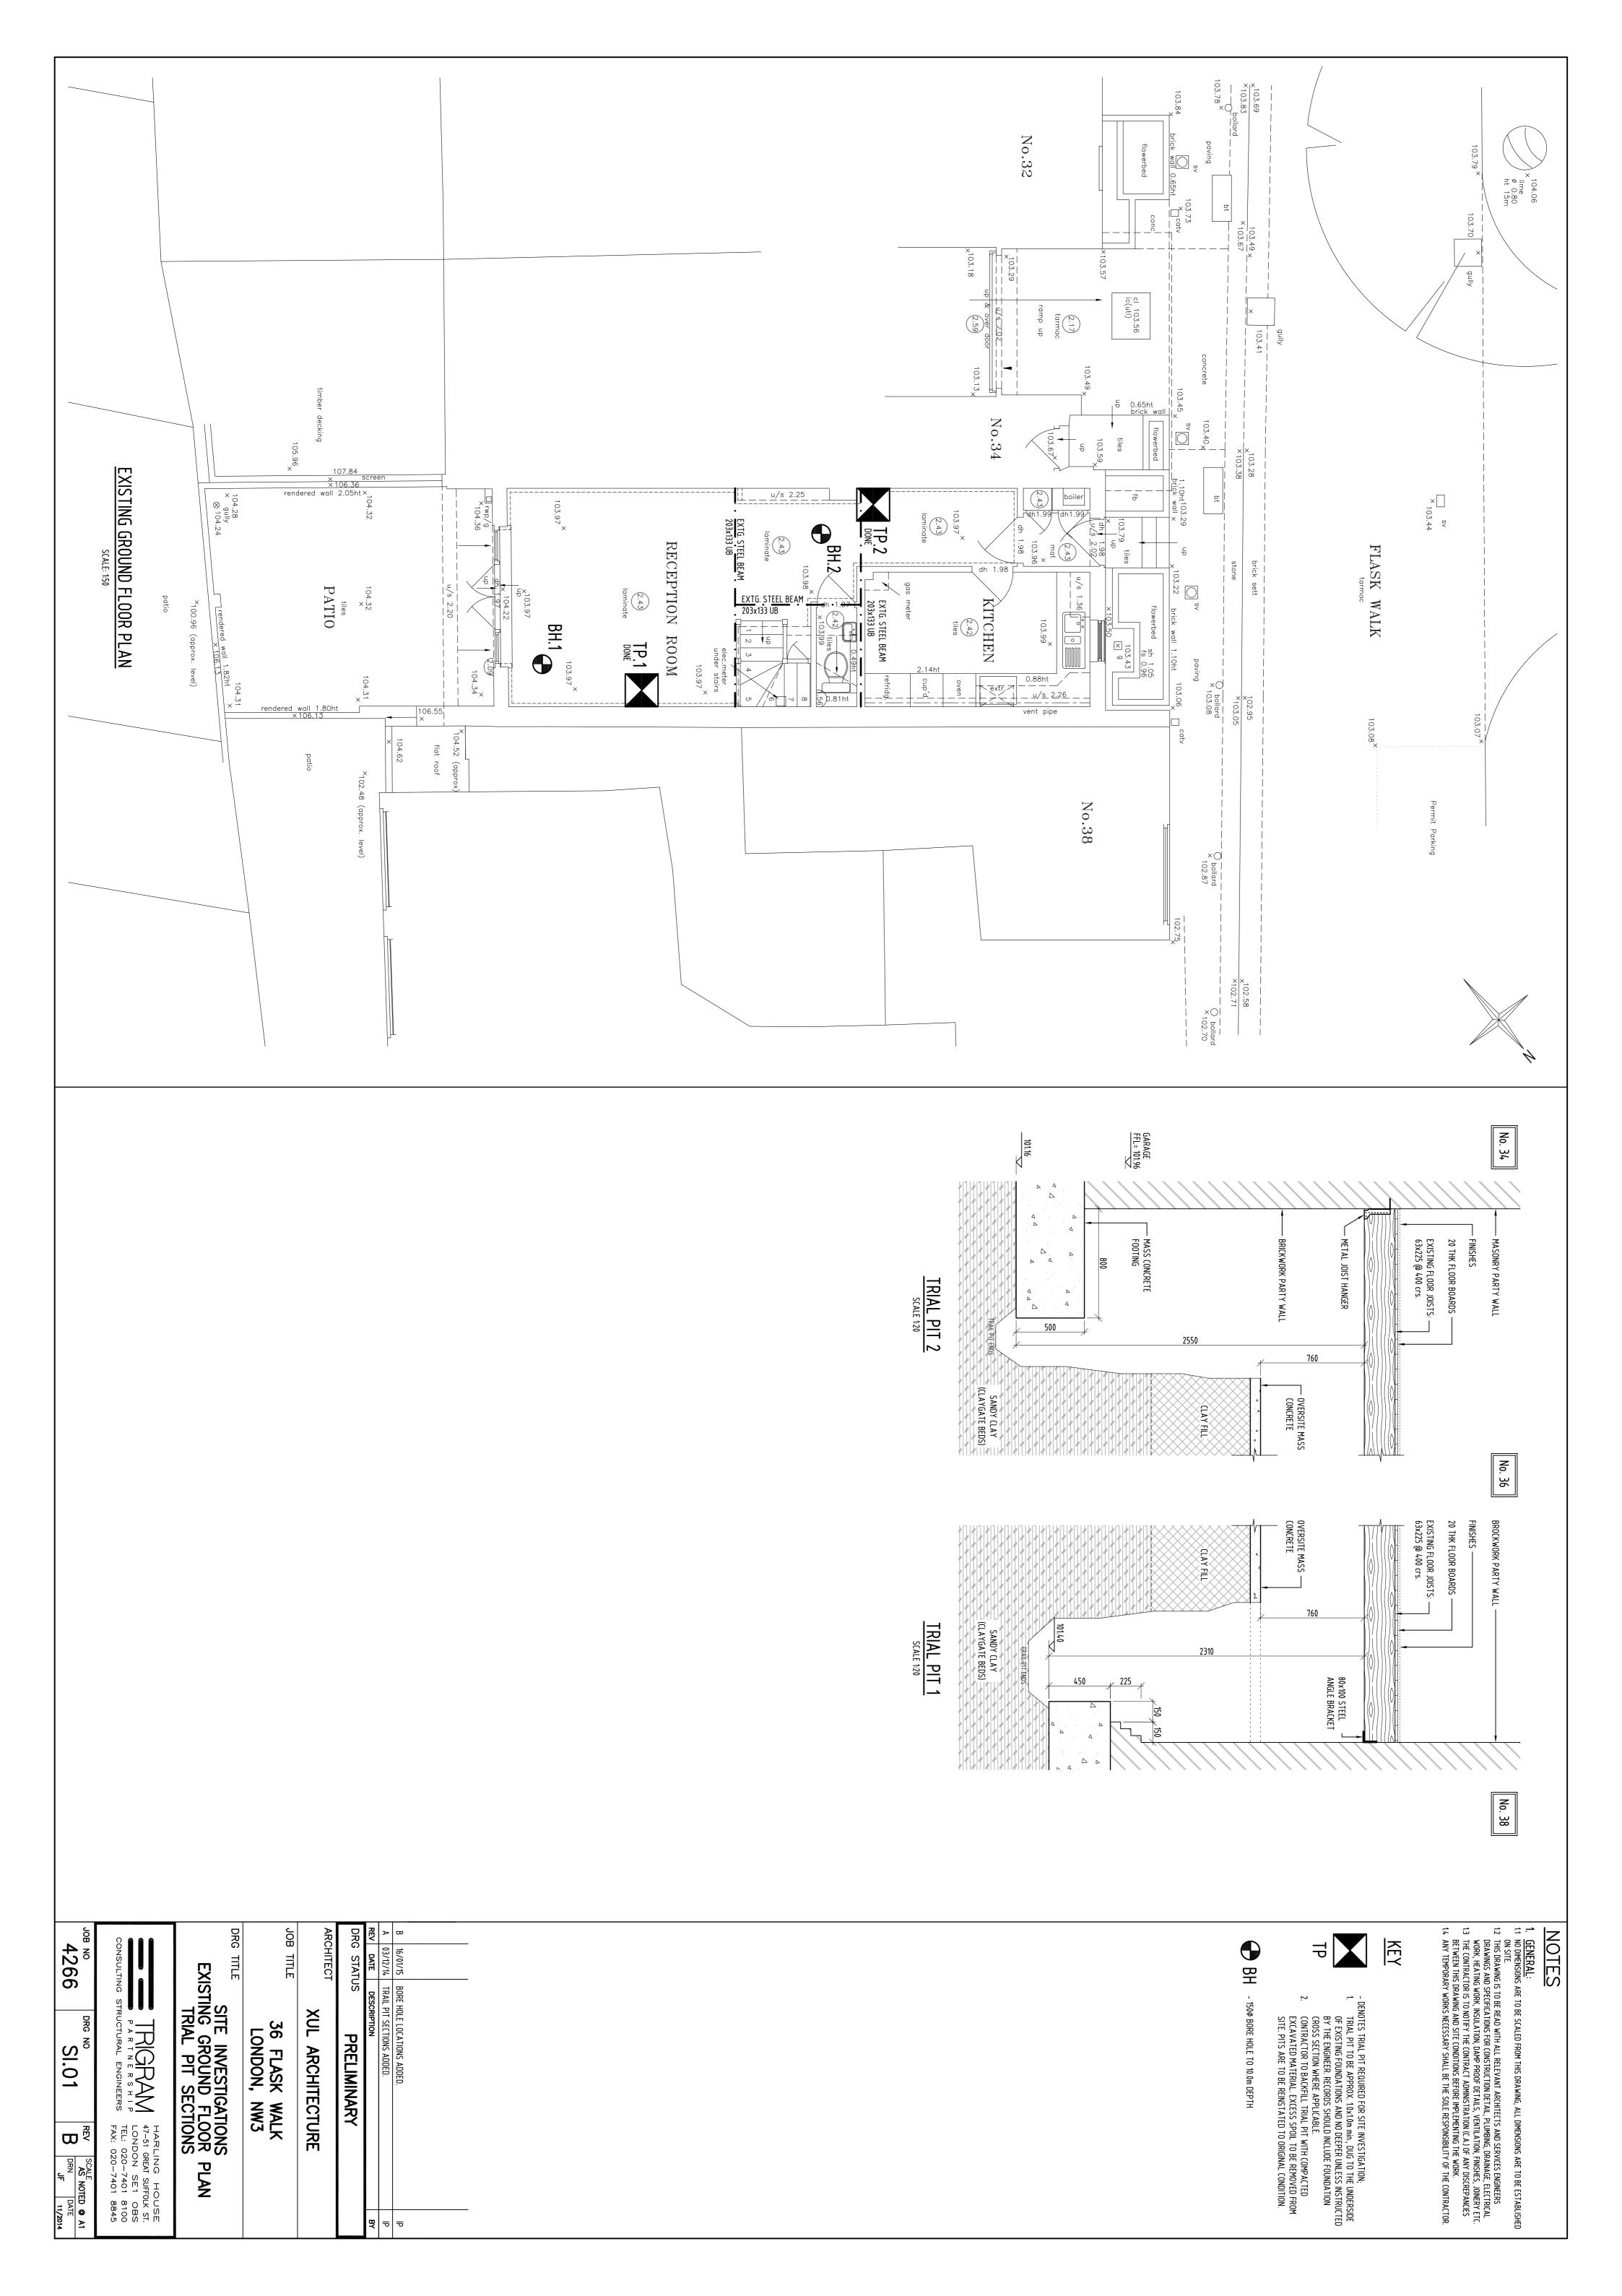



#### **Appendix G - Structural Scheme Calculations**

- 1. Load take down
- 2. Box Frame
- 3. Basement Slab
- 4. Retaining walls



Job No Sheet No. Rev

4 2 6 6

Made By Dates Chkd

36 Flask Walk

1, Load take down.

Front elevation:





CONSULTING STRUCTURAL ENGINEERS

Job No	Sheet No.	
Made By	Dates	Chkd
12	Dates	

36 Flage Walk

Rear elevation:





Job No Sheet No. Rev

4 2 6 6

Made By Dates Chkd

	_					
-		1	1 -		1 - 1	10
36	1	500	1	W	CUI	1

-	and the same of th						
1	Tron		-1	100	bline	-	
7	400	-	-	CI	1000	on	- 1

@ section >-A:

Ptot = (4.2.6.3 - 2.1.1 - 0.8 - 1.6) .4.40 = 96.2

+ (4.2.3.0 - 1.9).1.00

10.7

(ax P.201

Pang = 106.9/4.2 = 25.4 km/m

(sls)

Rear elevation;

@ section A-A:

Prox = (4.2.3.9 - 2.1.1).4.40

- 62,4

= 11.0

+ (4.2.30 - 2.08). 1,00

73.4 Kes


para = 73.4/4.2 = 10.3 ku/m

(sis)



TP01


4266		
Made By	Dates	Chkd

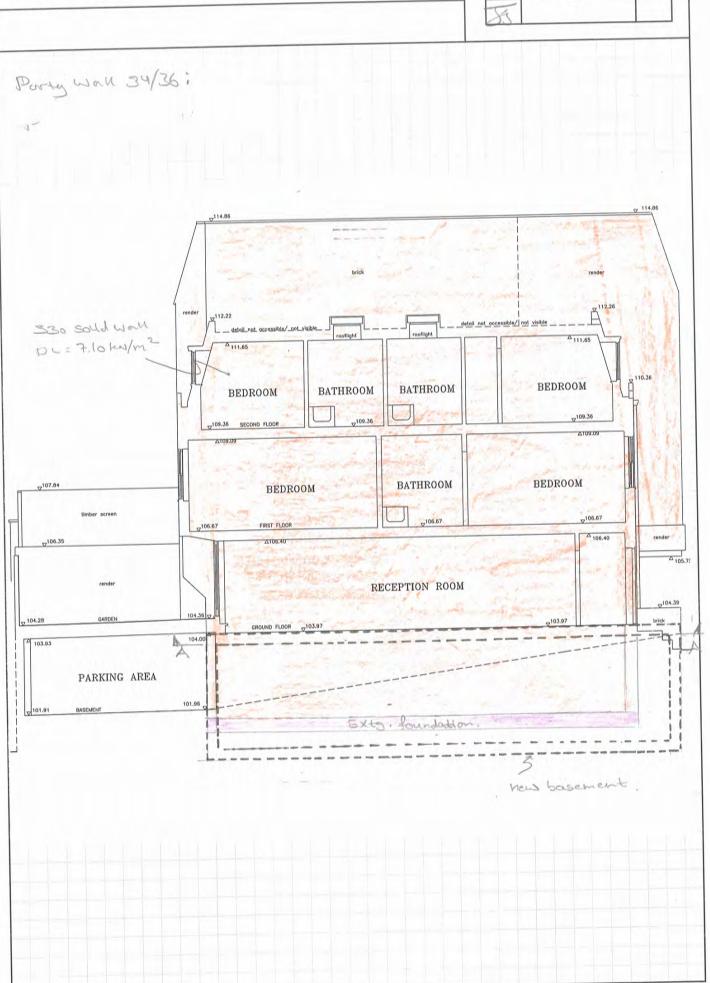



Job No	Sheet No.	Rev
426	6	
Made By	Dates	Chkd
50		

party walk 36/38:

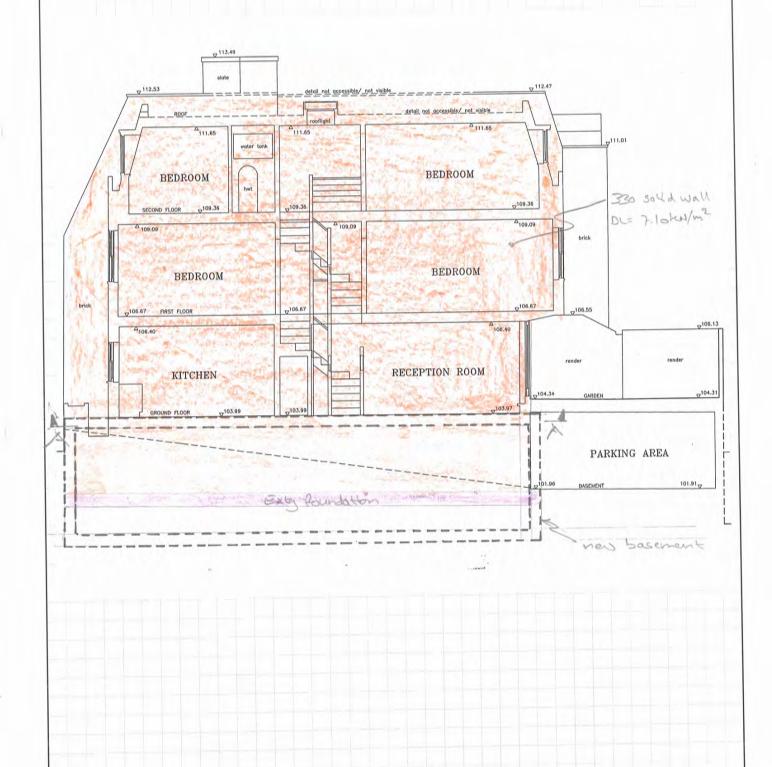



Job No Sheet No. Rev

H 2 6 6

Made By Dates Chkd

36 Fluste Walk Indicative cross section: # 34 # 36 #38 Sisan = 4.1 m DL= 1.00 KN/m2 1001 LC = 0.75 ton/m2 Span = 4.0 m 512 w 3 4.1 m Span 2 1.6 m DC = 0.70 hu/m2 DC = 1.00 hulley DC= 1.00 mu/m LL = 2,00 hu/m2 LL = 3.00 has/m2 LL = 0.75 KN/m2 2nd Span 24.1 m 2 vid D1 = 0.70 her/m2 DC = 0.70 ku/mi 11 - 2,00 km/m2 UL = 2.00 hos/m Span 2 3.6 m. 2nd D1 = 0.70 KN/m 11 = 8.00 happin span = 4:1m DL = 0.70 hall DL= 0.70 hw/-2 Spa \$3.6 m LL = 2.00 hollow 11: 2.00 has/and LL = 2,00 hu/m Ground Span & I.L m DC= 0.70 MN/m2 1 Growing DV = 0.70 KU/m2 LL= 2-00 tellmi LC = 1.50 hor/m2 ground bearing ground bearing. Des Mc foundation \* 0.50 km/m2 allowance for portitions



Sheet No. Job No Rev Dates Chkd

36 Flage Walle

posty war 34/36:

e section A-A.

+ 3.11.1. /2.4.0. (0.70+2.00) = 179.8

+ 1.10.5.1/2.4.0 (1.00+0.75) = 36.8

+ 3.12.8 12.4.1. (0.70+2.00) = 212.5

4.41 = (02.1+05.0) -5.1.5/1.6.0) + 1.4.4

+ 1.12.0. 12.4.1. (1.00+0.75) = 43.1

1484,9 Ked

, selfut party war

, #36 flows

, # 36 rout

, # 34 floors (1,243)

, # 34 flow (Gr)

, # 34 roof

Paux = 1484.9/115 = 129.1 km/m

Porty Wan 36/38:

@ Section A-A

Ptot = (12.5. 8.5) 7.10

= 754,4

as above

= 179.8

as above

+ 2.12.5.16.3.6. (0.70+2.00) = 121.5 ,#38 Ploons

+ 1.12.5. /2.3.6. (1.00 + 3.00) = 90.0

, # 36 floors


, selfut, party war


= 36.8 , # 36 roof

# 38 100+

1182.5 KN

Dava = 1182.5/12.4 = 95.4 KN/m

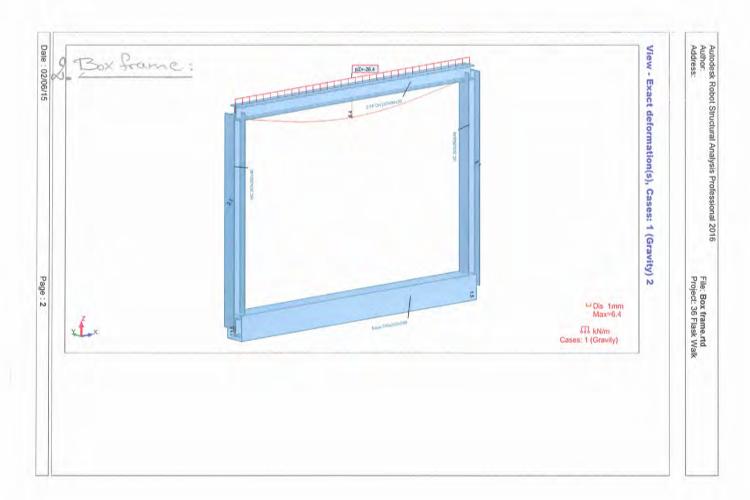

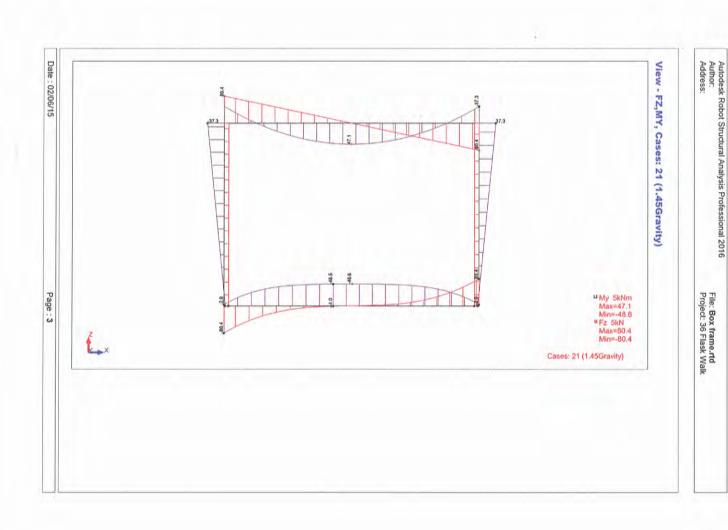

ð	4	U
n	ă,	7.
4	м	Ţ
		ď

Trigram Partnership 47-51 Great Suffolk Street Hading House

London, SE1 0BS

4266	Evision 1	Approved dash
Johno	Start page no.iRevision	Approved by
		Checked date
36 Flask Walk	Box frame	Checked by
36 Flas	Boxi	Calcs date 02/06/2015
Project	Celcs for	Calcs by

## STEEL MEMBER DESIGN (BS5950)

In accordance with BS5950-1:2000 incorporating Corrigendum No.1

TEDDS calculation version 3 0.05

Section details

Section type Steel grade

From table 9: Design strength py Thickness of element

Modulus of elasticity Design strength

max(T, t) = 14.0 mm

UKPFC 200x90x30 (Corus Advance)

E = 205000 N/mm<sup>2</sup> p, = 275 N/mm<sup>2</sup>

### Lateral restraint

L<sub>3</sub> = 4200 mm Ly = 4200 mm Distance between major axis restraints Distance between minor axis restraints

Effective length factors

K. = 1.00 K,= 1.00 Effective length factor in major axis Effective length factor in minor axis Effective length factor for lateral-torsional buckling K-r=1.20

Classification of cross sections - Section 3.5

E = \([275 N/mm² / p<sub>v</sub>] = 1.00

Internal compression parts - Table 11 Depth of section d/t=21.1 . E <= 80 . E b/T=6.4×6<=9×c b = B = 90 mm

Outstand flanges - Table 11

Width of section

d=148 mm

Class 1 plastic

Fyy = 40.2 KN

Shear capacity - Section 4.2.3

Design shear force

Section is class 1 plastic

Class 1 plastic

3 × 02 × 1/P

ed date 4266 Start dage no. Revision Job no. 36 Flask Walk Calcs date 02/06/2015 Caics by Cales for THE P 47-51 Great Surfox Street Trigram Partnership London, SE1 08S Hading House Tedds

A - 1 - D - 1400 mm2	2000
Web does not need to be checked for shear buckling	

Shear area	A <sub>v</sub> = t × D = 1400 mm <sup>2</sup>
Design shear resistance	Pyy = 0.5 x py x Av = 231 kN
	PASS - Design shear fesistance exceeds design shear force
Shear capacity - Section 4.2.3	

F.c. = 0 kN M = 24 kNm Moment capacity fow shear - cl.4.2.5.2 Moment capacity - Section 4.2.5 Design bending moment Design shear force

 $M_c = min(p_y \times S_{xx}, 1.2 \times p_y \times Z_{xx}) = 80.1 \text{ kNm}$ Le = 12 x L, = 5040 mm Effective length for lateral-torsional buckling - Section 4.3.5 Effective length for lateral torsional buckling

v=1/[1+0.05 × (1, / x)] = 0.561 125 = 0 × V × 1 × V[Bw] = 93.578 A = Le / ry = 175.051 x = 12.979Bw = 1,000 u = 0.953 Equivalent slenderness - Section 4.3.6.7 Equivalent slendemess - cl.4.3,6.7 Buckling parameter Slenderness factor Slendemess ratio Ratio - cl.4,3.6.9 Torsional index

קנד = max(מנד × (אנד - אנפ) / 1000, 0) = 0.415 φετ = (p<sub>1</sub> + (ηετ + 1) × p<sub>E</sub>) /2 = 301 N/mm<sup>2</sup> pe = = x × E / 2 L = 231.1 N/mm<sup>2</sup> 0.7=7.0 Bending strength - Section 4.3.6.5 Robertson constant Euler stress Perny factor

λετ > λει - Alfowance should be made for lateral-torsional buckling

3us = 0.4 × (x2 × E / p,)05 = 34.310

Limiting slenderness - Annex B.2.2

 $p_0 = p_0 \times p_1 / (\phi_0 \tau + (\phi_0 \tau^2 - p_0 \times p_1)^{0.9}) = 136.5 \text{ N/mm}^2$ Equivalent uniform moment factor - Section 4.3.6.6 Bending strength - Annex B.2.1

mLT = 1.000

Equivalent uniform moment factor for LTB

Mb = Po x Sox = 39.8 kNm Buckling resistance moment - Section 4,3,6,4 Buckling resistance moment

PASS - Buckling resistance moment exceeds design bending moment Ms / mt = 39.8 kNm

Tedds	gram Partnership
	Trig

47-51 Great Suffolk Street

Harling House

London, SEJ 0BS

4266	Revision	Approve
Job no.	Start page no.fRe	Approved by
		Checked date
36 Flask Walk	Box frame	Checked by
36 Flas	Boxí	Catcs date 02/06/2015
Project	Calcs for	Calcs by JF

# STEEL MEMBER DESIGN (BS5950)

In accordance with BS5950-1:2000 incorporating Corrigendum No.1

Section details

Section type Steel grade

From table 9: Design strength py Thickness of element

Modulus of elasticity Design strength:

UC 203x203x46 (BS4-1)

max(T, 1) = 11,0 mm p, = 275 N/mm<sup>2</sup>

E = 205000 N/mm<sup>2</sup>

4.73 +1114 HILL

### Lateral restraint

Ly = 3000 mm L<sub>v</sub> = 600 mm Distance between major axis restraints Distance between minor axis restraints

Effective length factors

K,=1.00 K, = 1.00 Effective length factor in major axis Effective length factor in minor axis

Effective length factor for lateral-torsional buckling K<sub>17</sub> = 1.20

Classification of cross sections - Section 3.5

E = 1275 N/mm2 / py] = 1.00

Internal compression parts - Table 11

Depth of section

Stress ratios

Outstand flanges - Table 11

Width of section

b/T=9.3 x E <= 10 x E b=8/2=101,8 mm

 $d/t = 22.3 \times \varepsilon <= \max(80 \times \varepsilon / (1 + r1), 40 \times \varepsilon)$  Class 1 plastic

r1 = min(Fo/ (d x t x py\*), 1) = 0.253

d = 160.8 mm

12 = Fc / (A x p,m) = 0.05

Class 2 compact

Section is class 2 compact

١	č	
1	ā	
	)	Tadde

36 Flask Walk. 4266	Start page no. Revision 2	Calcs rate Checked trate Approved by Approved by Approved date 02/06/2015
Project	Calcs for	Cates by JF

rship		Street	98
Trigram Partne	Harling House	47-51 Great Suffolk	London, SE1 06

Approved date

Shear capacity - Section 4.2.3	hear force F <sub>vv</sub> = 13.4 kN	d/1<70*E	Web does not need to be checked for shear buckling	A <sub>c</sub> = 1 × D = 1463 mm <sup>2</sup>
Shear capacity -	Design shear force			Shear area

Design shear resistance Shear area

TEDDS relouation version 3/0,05

PASS - Design shear resistance exceeds design shear force Py, = 0.6 × py × A. = 241.4 kN

M = 37.3 kNm Fx. = 0 kN Moment capacity - Section 4.2.5 Shear capacity - Section 4.2.3

Design shear force

 $M_c = min(p_y \times S_{zz}, 1.2 \times p_y \times Z_{xz}) = 136.8 \text{ kNm}$ Effective length for lateral-torsional buckling - Section 4.3.5 Moment capacity low shear - cl.4.2.5.2 Design bending moment

LE = 1.2 x Ly = 720 mm J=LE/FW=14.023 Effective length for lateral torsional buckling Slendemess ratio

Equivalent slenderness - Section 4.3.6.7 **Buckling parameter** 

v=1/[1+0.05 < (x/x)<sup>2</sup>]<sup>0.25</sup> = 0.992 Bw = 1.000 x=17,713 u=0.847 Slendemess factor Ratio - cl.4.3.6.9

Equivalent stendemess - cl.4.3.6.7

345 = 0.4 × (#2 × E / py/05 = 34,310  $\lambda_{kT} = u \times v \times \lambda \times v(p_{wd}) = 11.780$ Limiting slendemess - Annex B.2.2

كله < كله - No allowance need be made for fateral-torsional buckling

Buckling resistance moment - Section 4,3,6.4 Bending strength

PASS - Moment capacity exceeds design bending moment M = ps × Sx = 136.8 kNm Po = py = 275 N/mm<sup>2</sup> Buckling resistance moment

F. = 80.4 KN Compression members - Section 4.7 Design compression force.

Les = Ls × Ks = 3000 mm 1 = L= 1 for = 34.017 Effective length for major (x-x) axis buckling - Section 4.7,3 Effective length for buckling Slendemess ratio - cl.4.7.2

Compressive strength - Section 4.7.5 Limiting stendemess

30=0.2 × (# × E1p,)05 = 17.155

Strut curve - Table 23 Robertson constant

D. = 3.5

 $\phi_c = (p_c + (\eta_s + 1) \times p_{EC})/2 = 1063.3 \text{ N/mm}^2$ Tp = Cts × (Xs - Xs) / 1000 = 0.059 per = x2 x E / 1,2 = 1748.4 N/mm² Euler stress Perry factor

Compression resistance - Section 4.7.4 Compressive strength - Annex C.1

Compression resistance - cl.4.7.4

 $p_{12} = p_{13} \times p_1 / (4x + (4x^2 - p_{13} \times p_1)^{0.3}) = 257.2 \text{ N/mm}^2$ 

PASS - Compression resistance exceeds design compression force Pox = A x pox = 1510,6 kN

	-
and the	
000	1
20	Ċ
1-	1
	- 1

Trigram Partnership 47-51 Great Sulfolk Street Landon, SE1 0BS Harling House

Start page no./Revision 4266 Job no Checked by 36 Flask Walk Box frame Calcs date 02/06/2015 Calcs by Calcs for Project

Effective length for minor (y-y) axis buckling - Section 4.7.3

 $L_{E_f}=L_f\times K_y=600~mm$ Effective length for buckling

14 = Ley / 1m = 11.686 Slendemess ratio - cl.4.7.2

Compressive strength - Section 4.7.5

Strut curve - Table 23 Limiting slenderness

 $\lambda_0 = 0.2 \times (\pi^2 \times E / (p_y)^{0.5} = 17.155$ 

Robertson constant Euler stress Perry factor

Compressive strength - Annex C.1

Compression resistance - Section 4.7.4 Compression resistance - cl.4.7.4

Poy = A × poy = 1666.2 kN

 $p_{ev} = p_{Ev} \times p_v I(\phi_v + (\phi_v^2 - p_{Ev} \times p_v)^{0.6}) = 283.7 \text{ N/mm}^2$ 

 $\phi_f = (p_y + (\eta_{1f} + 1) \times p_{E_f}) / 2 = 7322.3 \text{ N/mm}^2$ ps, = x2 « E / 3,2 = 14815,2 N/mm<sup>2</sup>

TIX = COp × (Ay - No) / 1000 = -0.030

0, = 5.5

PASS - Compression resistance exceeds design compression force

Comb.compression & bending check - cl.4.8.3.2  $F_c/(A \times p_y) + M/M_c = 0.322$ Compression members with moments - Section 4.8.3

PASS - Combined bending and compression check is satisfied

Member buckling resistance - Section 4.8.3.3.

M<sub>.7</sub> = M<sub>.</sub> = 37.30 kNm Max major axis moment governing Ms.

Equivalent uniform moment factor for major axis flexural buckling

пъ = 1,000

Fe/Por+ mk x M / Mk x (1+0.5 x Fe/Pox) = 0.333  $m_{ij} = 1.000$ Buckling resistance checks - cl 4.8.3,3,2

Fe/Por+ mar > Mar/ Mb = 0.321

PASS - Member buckling resistance checks are satisfied




Job No	Sheet No.	Rev
Made By	Dates	Chkd
(		

#### 36 Flask Walk

c	8		B	asem	ent	scab
×	P 4	г			_	

Flotation and residual heave calculations show that the uplift pressure applied to the underside of the basement slab is less than the downward forces. The residual heave pressure is astimated to half the weight of the removed overburden, i.e. 0.5. 2.4. 20 = 24.0 tos/m2 The worst credible water level is at the garage floor level along the party wall 34/36 Flask Walle, and at the ground floor level of no. 38 Flask Walk for the apposite party wall . #34 # 38

DL party wall = 1150,3/12,3+3,4,7,10 = 117.7 hw/m

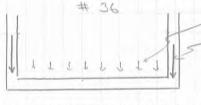


selfut of slab = 6.0 km/m2 DL party wall = 1876.1/12:3+34.7.16 = 95,4 har/m

heave = 24.0 hu/m2

Water = 1.35.10=13.5 kW/m water = 2.05:10 = 20.5 hal/2

Tedds Trigram Partnership Harling House 47-51 Great Suffoit Street London, SE1 0BS

or control	36 Fla	36 Flask Walk		Job no.	4266
Calcs for	Basem	Basement slab		Start page no Revision	Sevision 1
Caks by	Calcs date 02/06/2015	Checked by	Checked date	Approved by	Approved date

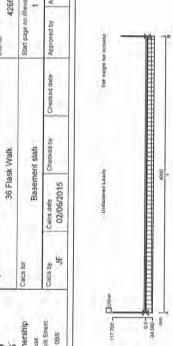

# CONTINUOUS BEAM ANALYSIS - INPUT

BEAM DETAILS

Number of spans = 1

Material Properties:

Modulus of elasticity = 25 kN/mm<sup>2</sup>

Material density = 2400 kg/m3

Rotationally "Free" Rotationally "Free"

Support Conditions:

Support A Vertically "Restrained"

Vertically "Restrained" Support B

Cross-sectional area = 250000 mm<sup>2</sup> Noment of inertia = 1,00x10\* mm<sup>4</sup> Length = 4200 mm Span Definitions: Span 1

LOADING DETAILS

Beam Loads:

UDL Other load 6.0 kN/m Load 1

Point Other load 117.7 kN at 0.000 m Load 3 Load 2

Point Other load 95.4 kN at 4.200 m

UDL Other load -24.0 kN/m Load 4

VDL Other load -20.5 kN/m to -13.5 kN/m

Load 5

Support A loads:

Beam pointOther Load 117.7 kN Support B loads: Load 2

Beam pointOther Load 95.4 kN LOAD COMBINATIONS

Load 3

1xOther Load combination 1 Span 1 1×Other Support A

CONTINUOUS BEAM ANALYSIS - RESULTS 1×Other Support B

# RESULTS FOR COMBINATION 1

Moment = 0.0 kNm Moment = 0.0 kNm Support Reactions and Deflections - Combination 1: Support A Reaction = -24.3 kN Support B Reaction = -24.3 kN

Rotation = -249,27 deg Rotation = 245.97 deg

Deflection = 0.0 mm Deflection = 0.0 mm

nes downward 2 year

to xpm - 1-1 rox 0.99 300 Pouce

4266	Start page no Revision 2	fby Approved d
Job no.	Start pag	Approved by
		Checked date
36 Flask Walk	Basement slab	Chedited by
36 Flas	Basem	Calcs date 02/06/2015
Project	Cates for	Calcs by JF
Tedds	Trigram Partnership Haring House	7-51 Great Suffork Streigh London, SE1 0BS

	<b>1</b> 7°	912	d ¬a
Bending Albertet - Combination 1 -57.2	0027	Sincer Force - Cerubination t	2000
150 mm	1	214 Z. 14 Z.	15.55 17.60 17.60

## ELEMENT DESIGN to BS 8110:1997 SOLID SLABS

dti

Originated from RCC11.xls v2.1 @ 2001-2003 BCA for RCC

ĺ				1	n	
	70= 1.50	7s = 1.05		Section location SIMPLY SUPPORTED SPIN		Software transferred and the
	N/mm²	460 N/mm²		SIMPLY	NONE	John Hankon
	+	460		ation	steel	-1
	fcu 35	fy		Section loc	Compression steel	appe have
	KNm/m		mm	mm	mm.	mm to these hare
Sase slab		1.00	2600	250	16 =	L
Location Base slab	Design moment, M	(Sb	span	Height, h	Bar Ø	COVIDE 30
INPUT	Design					

Compression steel = NONE OUTPUT Base slab

d = 250 - 30 - 16/2 = 212.0 mm (3.4.44)

(3.4.4.4)

(3.4.4.1)

K' = 0.156 > K = 0.059 ok  $z = 212.0 [0.5 + (0.25 - 0.059 /0.893)]^{4}/_{2} = 197.0 > 0.95d = 201.4 \text{ mm}$   $As = 93.00E6 /460 /196.9 \times 1.05 = 1078 > \text{min As} = 325 \text{ mm}^{2}/\text{m}$   $PROVIDE T16 @ 175 = 1149 \text{ mm}^{2}/\text{m}$   $fs = 2/3 \times 460 \times 1078 /1149 /1.00 = 287.8 \text{ N/mm}^{2}$  Tens mod factor = 0.55 + (477 - 287.8) /120 /(0.9 + 2.069) = 1.081  $Permissible L/d = 20.0 \times 1.081 = 21.621$  Actual L/d = 2600 /212.0 = 12.264 ok(Eqn 7) (Edu 8)

(3,4.6.3)



Job No Sheet No. Rev

4 26 6

Made By Dates Chkd

36 Flask Walke

4. Retaining 12c wall	
Worst case is work cet front to possel footpast:	
ALL Sucharge = 10 km/m²	
X = 20 km/m², 9' = 25°  Ha= 0.41	
new window W/L	
300 the	
new sliding folding doors	
Surdiage Soil inhiten (519)	
Lacer Lloading:	
Surcharge: p = 0.41.10 = 4.1 HN/m2	
Sall (sat): pmax = 0.41.2.6. (20-10) = 10.7 10/m2	
water pmx = 2.6.10 = 26.0 km/m2	

TP01

Trigram Partne Harling Hou London, SE

4266	# -	5	
Johno.	Start page no /Revisit	Approved by	Self ways not included
		Checked date	plan per
36 Flask Walk	Retaining wall - Front	Checked by	9 8
36 Flas	Retaining	Calcs date 02/06/2015	Unusered Loads
5	Calcs for	Calcs by JF	2
Ø.8	rfnership	uffolk Street E1 0BS	200 dd (

# CONTINUOUS BEAM ANALYSIS - INPUT

BEAM DETAILS

Number of spans = 1

Material Properties:

Modulus of elasticity = 25 kN/mm<sup>2</sup>

Material density = 2400 kg/m3

Rotationally "Restrained"

Rotationally "Free"

Support Conditions:

Vertically "Free" Support A

Vertically "Restrained" Support B

Span Definitions:

Cross-sectional area = 250000 mm² Moment of inertia = 1,00x10f mm4 Length = 2600 mm LOADING DETAILS Span 1

UDL Other load 4.1 kN/m Beam Loads: Load 1

VDL Other load 0.0 kN/m to 10.7 kN/m Load 2

VDL Other load 0.0 kN/m to 26.0 kN/m Load 3

LOAD COMBINATIONS

Load combination 1

1×Other Span 1

Span 1 1.2xOther CONTINUOUS BEAM ANALYSIS - RESULTS Load combination 2

## RESULTS FOR COMBINATION 1

Support Reactions and Deflections - Combination 1:

Moment = 55.2 kNm Moment = 0.0 kNm Reaction = -58.4 kN Reaction = 0.0 kM Support B. Support A

Deflection = 3172.9 mm Rotation = -89.12 deg

Rotation = 0.00 deg

Deflection = 0.0 mm

0.0

Trigger	i	Project Calcs for	36 Flask Walk	k Walk		Job no. 4.	4266
Harlin	Harling House	50	Retaining wall - Front	vall - Front		start page no intevision	2
47-51 Great	47-51 Great Suffolk Street London SE1 08S	Calcs by	Calcs date 02/06/2015	Checked by	Checked date	Approved by	Аррга-ед бате
	8.		Shew Force - Combanies 1	T seek		100	
	26.200 1 mm		5600			7.7	
RESULTS	RESULTS FOR COMBINATION 2	51					
Support Rea	Support Reactions and Deflections - Combination 2;	ions - Comb	ination 2:	6			
Support B	Reaction = -70.0 kN	z	Moment = 65,2 kNm	Deflection	Deflection = 0.0 mm Rotation = 0.00 deg	Rotation = 0.00 deg	00 deg
	- 44.54-		Eccling Moneon - Combinators 2	in Longery		7 19	
	Too.		2500	ė		11	
	700 000		Shear Force - Combination 2	geo 5		1	
	The man						
	mm A		ide:			767	

## ELEMENT DESIGN to BS 8110:1997 SOLID SLABS

Originaled from ROC11.xls v2.1 @ 2001-2008 BCA for RCC

dti CONCRETE

	yc= 1.50	7s= 1.05		VER		control only)
	N/mm²	460 N/mm²		CANTILEVER	NONE	ideflection
	4	460		ation	steel	
out	fcu 35	Ŋ		Section location	Compression steel	se pars
wall - Fro	kNm/m		mm	mm	тт Сотри	mm to the
Retaining	66.2	1.00	2600	300	16 ~	20
Location	Design moment, M 66.2 kNm/m	8b	span	Height, h	Bar Ø	cover
INPUT	Design					

Compression steel = NONE d = 300 - 50 - 16/2 = 242.0 mm OUTPUT Retaining wall - Front

 $z = 242.0 [0.5 + (0.25 - 0.032/0.893)]^{11/2} = 233.0 > 0.95d = 229.9 \text{ mm}$ K' = 0.156 > K = 0.032 ok (3,4,4,4) (3,4,4,4)

(3,4,4,1)

Tens mod factor = 0.55 + (477 - 225.6) /120 /(0.9 + 1.130) = 1.582 fs = 2/3 x 460 x 657 /894 /1.00 = 225.6 N/mm<sup>2</sup> (Eqn 7) (Eqn 8) (3.4.6.3)

Permissible L/d = 7.0 x 1.582 = 11.074 Actual L/d = 2600 /242.0 = 10.744 ok

ELEMENT DESIGN to BS 8110:1997 SLAB SHEAR

dt.

INPUT Location Retaining wall - Front fou = 35 4 N/mm²  $\gamma c = 1.50$ 

© 2001-2003 BCA for RCC

inginated from RCC11.xls v2.1

1000 d 242

fyl = 460 N/mm²

75= 1.05

Shear V 70.0 KN Legs Side cover 3 E 01 2 16 = 6 = mm Ø mm Ø Link Main Steel

4.44 2

UDL NVm

As = 893 N/mm² = 0.369% OUTPUT Retaining wall - Front

v = 70.0 x 103 /1,000 /242 = 0.289 N/mm² (Eqn.3)

vc = 0.575 N/mm², from table 3.8 No links needed (Table 3.8)

#DIV/0I

4266 Revision 1	Approved date		
Job na.	Start page no Revision	Approved by	7.
		Checked date	S - S - S - S - S - S - S - S - S - S -
36 Flask Walk	Retaining wall - Front	Checked by	2 - 2 - 2
36 Flas	Retaining	Calos date 02/06/2015	axis z z z z z z z z z z z z z z z z z z z
Project	Calcs for	Calcs by JF	Neutral E.
Tedds	Trigram Partnership	17-51 Great Sulfolt, Street. London, SE1 0BS	h + + + + + + + + + + + + + + + + + + +

# CRACK WIDTH CALCULATION TO BS8110:PART 2:1985

TEDDS calquiation version 1,6.02

Beam details

Section width

Section depth

Applied servicability limit state moment

Ms = 55.2 kNm

b = 1000 mm h = 300 mm for = 35 N/mm²

 $f_v = 500 \text{ N/mm}^2$ 

Material details

Characteristic strength of reinforcement Modulus of elasticity of the concrete Characteristic strength of concrete

E. = (20kN/mm² + 200 × f<sub>co</sub>) / 2 = 13,5 kN/mm²

E = 200 KN/mm²

Modulus of elasticity of reinforcement

Reinforcement details

Area of tension reinforcement provided

A<sub>s</sub> = 1340 mm<sup>2</sup>

6 = 16 mm

Maximum spacing of lension reinforement bars Minimum cover to tension reinforcement bars Diameter of tension reinforcement bars

S=150.0 mm = Series = London

Crin = 50 mm

A PARTY OF THE PARTY OF A

d=h-c∞-φ/2=242.0 mm ( T≥ 8cm+

m = Es / Ec = 14.815

 $x = (-m \times n + v((m \times n)^2 + 2 \times m \times n)) \times d = 80.2 \text{ mm}$ 

Calculate design surface crack width

Effective depth of tension reinforcement

Depth to neutral axis Modular ratio

Reinforcement stress Lever arm

Strain at soffit of beam Concrele stress

Strain due to stiffening of concrete between cracks  $s_2 = 1 \text{N/mm}^2 \times b \times (h - x)^2 / [3 \times E_s \times A_c \times (d - x)] = 0.000371$ Average strain at soffit of beam

 $\epsilon_1 = (f_a / E_s) \times (h - x) / (d - x) = 0.001300$  $f_0 = f_0 \times A_0 / (0.5 \times b \times x) = 6.397 \text{ N/mm}^2$ fs = Ms / (As x z) = 191.351 N/mm<sup>2</sup> z=d-x/3=215.3 mm n = Ae / (b x d) = 0.008

En = El - E2 = 0.000928

 $W = 3 \times a_{tr} \times \epsilon_{m} / (1 + 2 \times (a_{er} - c_{min}) / (h - x)) = 0.181 \text{ mm}$ Distance of crack to surface of nearest tension bar  $a_{cr} = \sqrt{((S/2)^2 + (h-d)^2)} - \phi/2 = 86.8 \, \text{mm}$ Design surface crack width