



water feature added
 stair widened, landing added
 Basement size & shape as built

Drainage manhole at back-of-pavement

AS PROPOSED

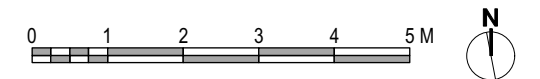


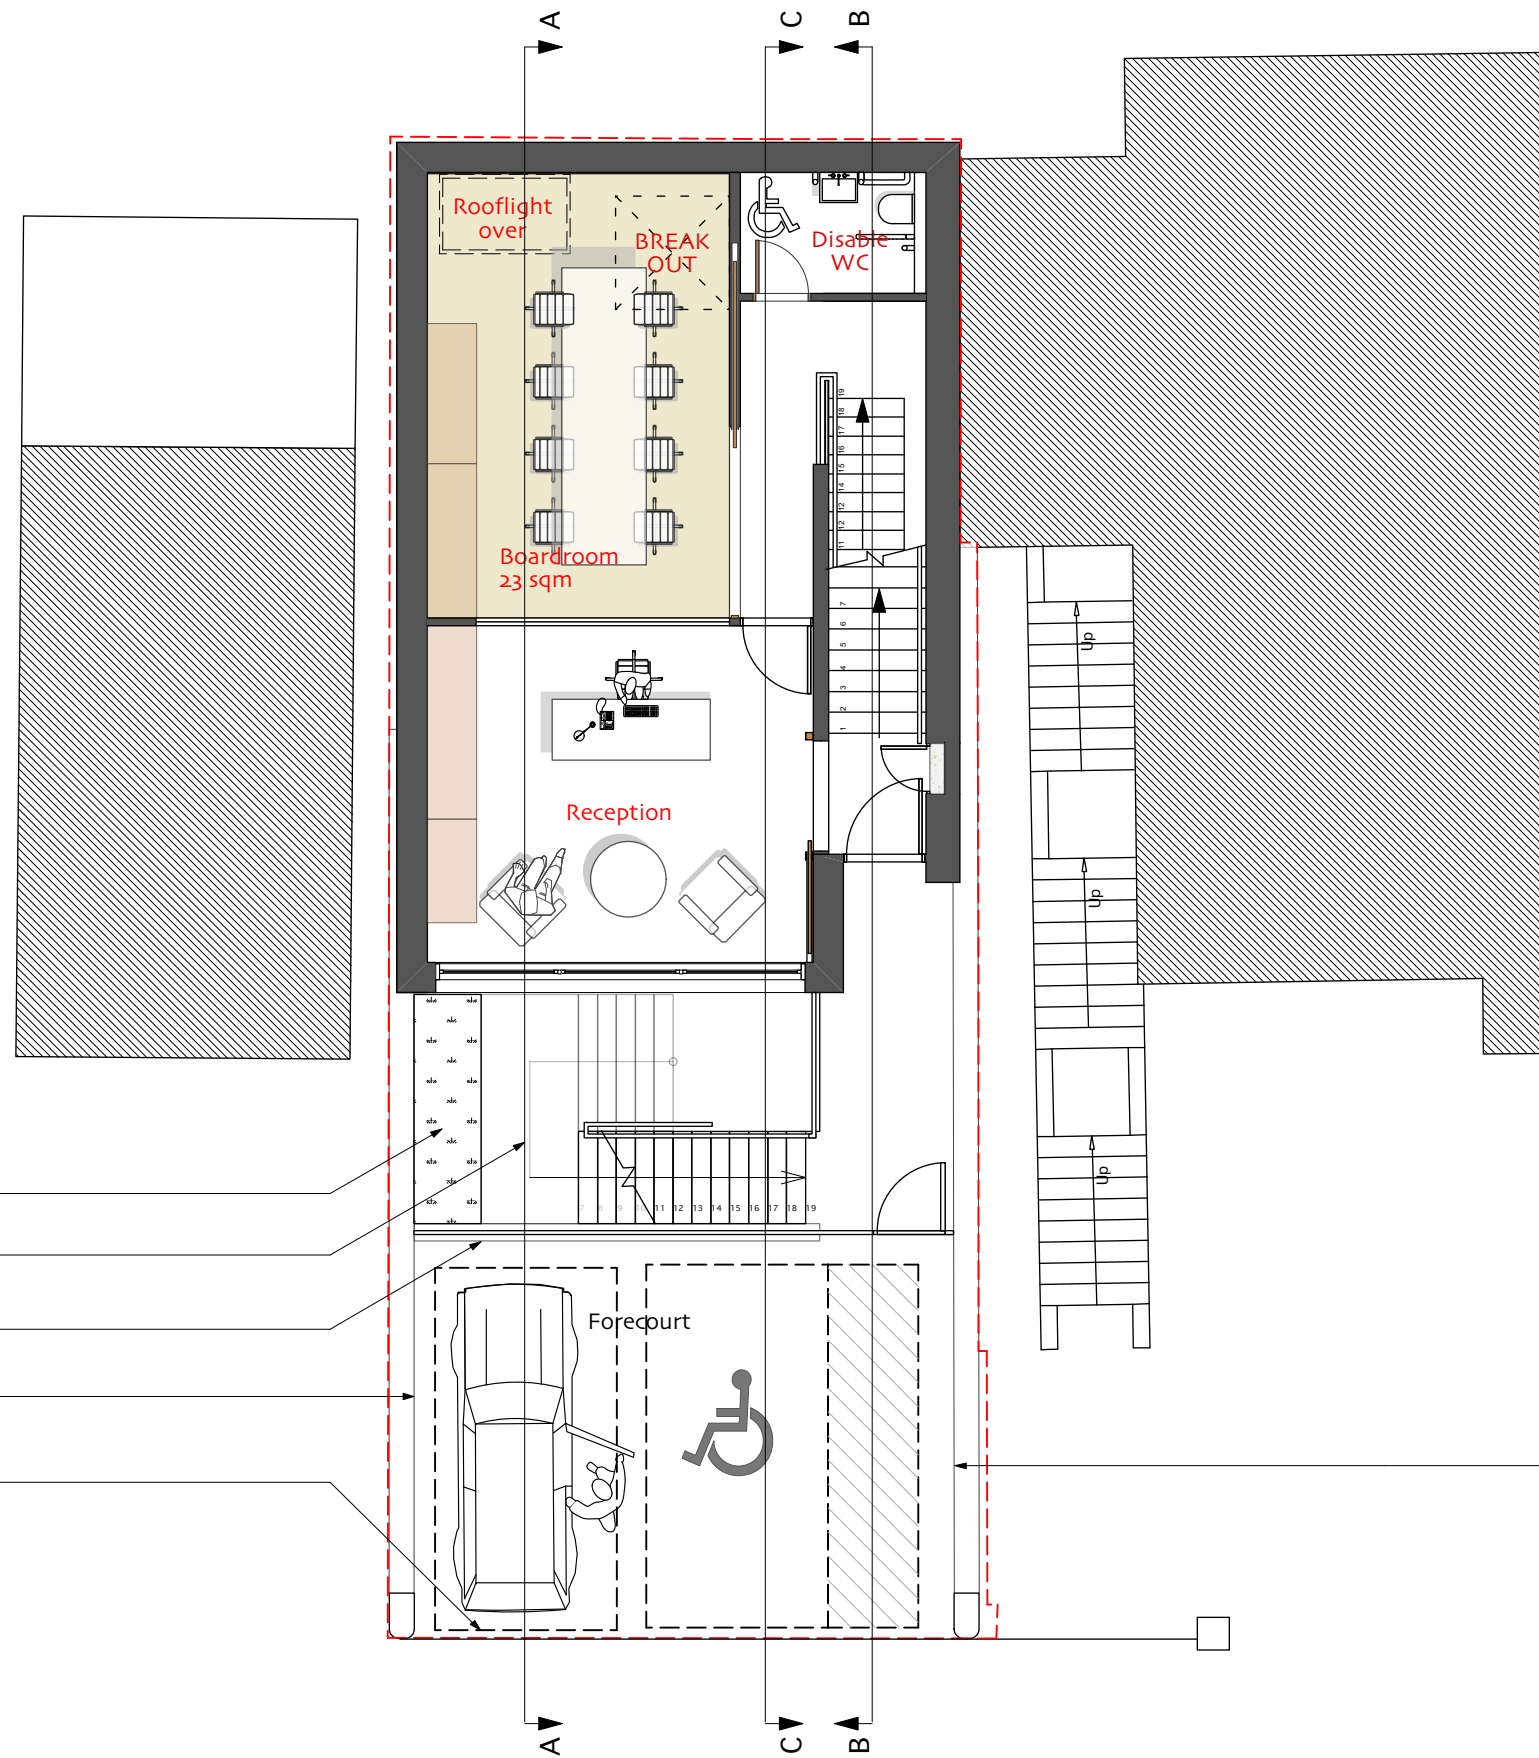

- planter added
- stair widened, landing added
- gate moved back behind forecourt
- Street number & company name lettered onto inner face of wall
- sliding gates replaced by railings

Street number & company name lettered onto inner face of wall


AS PROPOSED

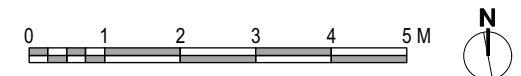


rooflight recessed so as not to discharge rainwater over neighbouring property


WC changed to tea point



Stairs moved as approved for house

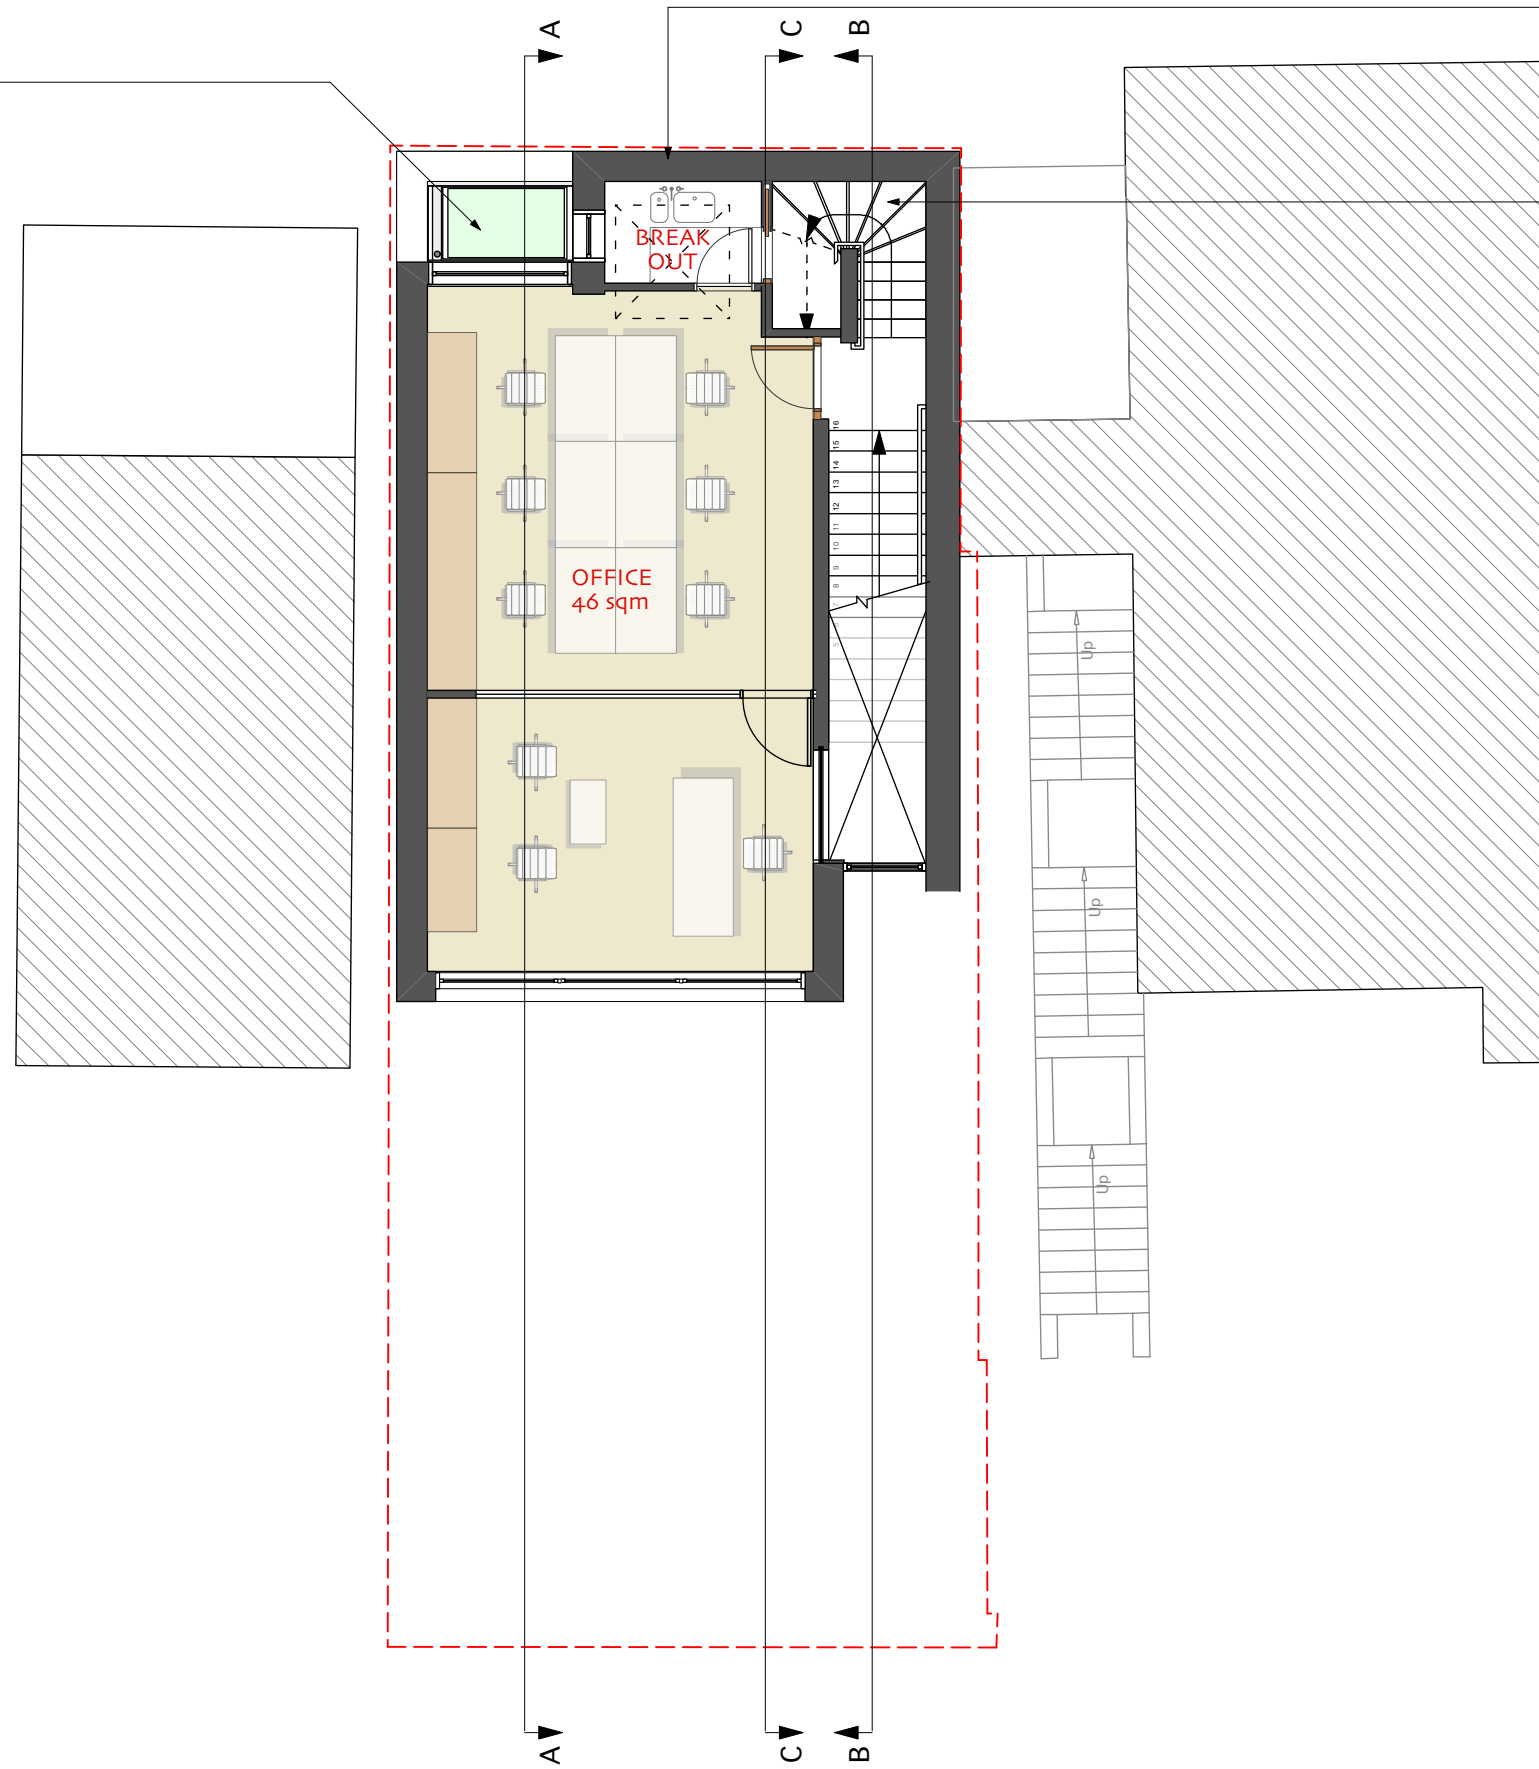


AS PROPOSED

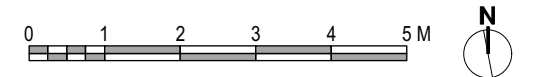


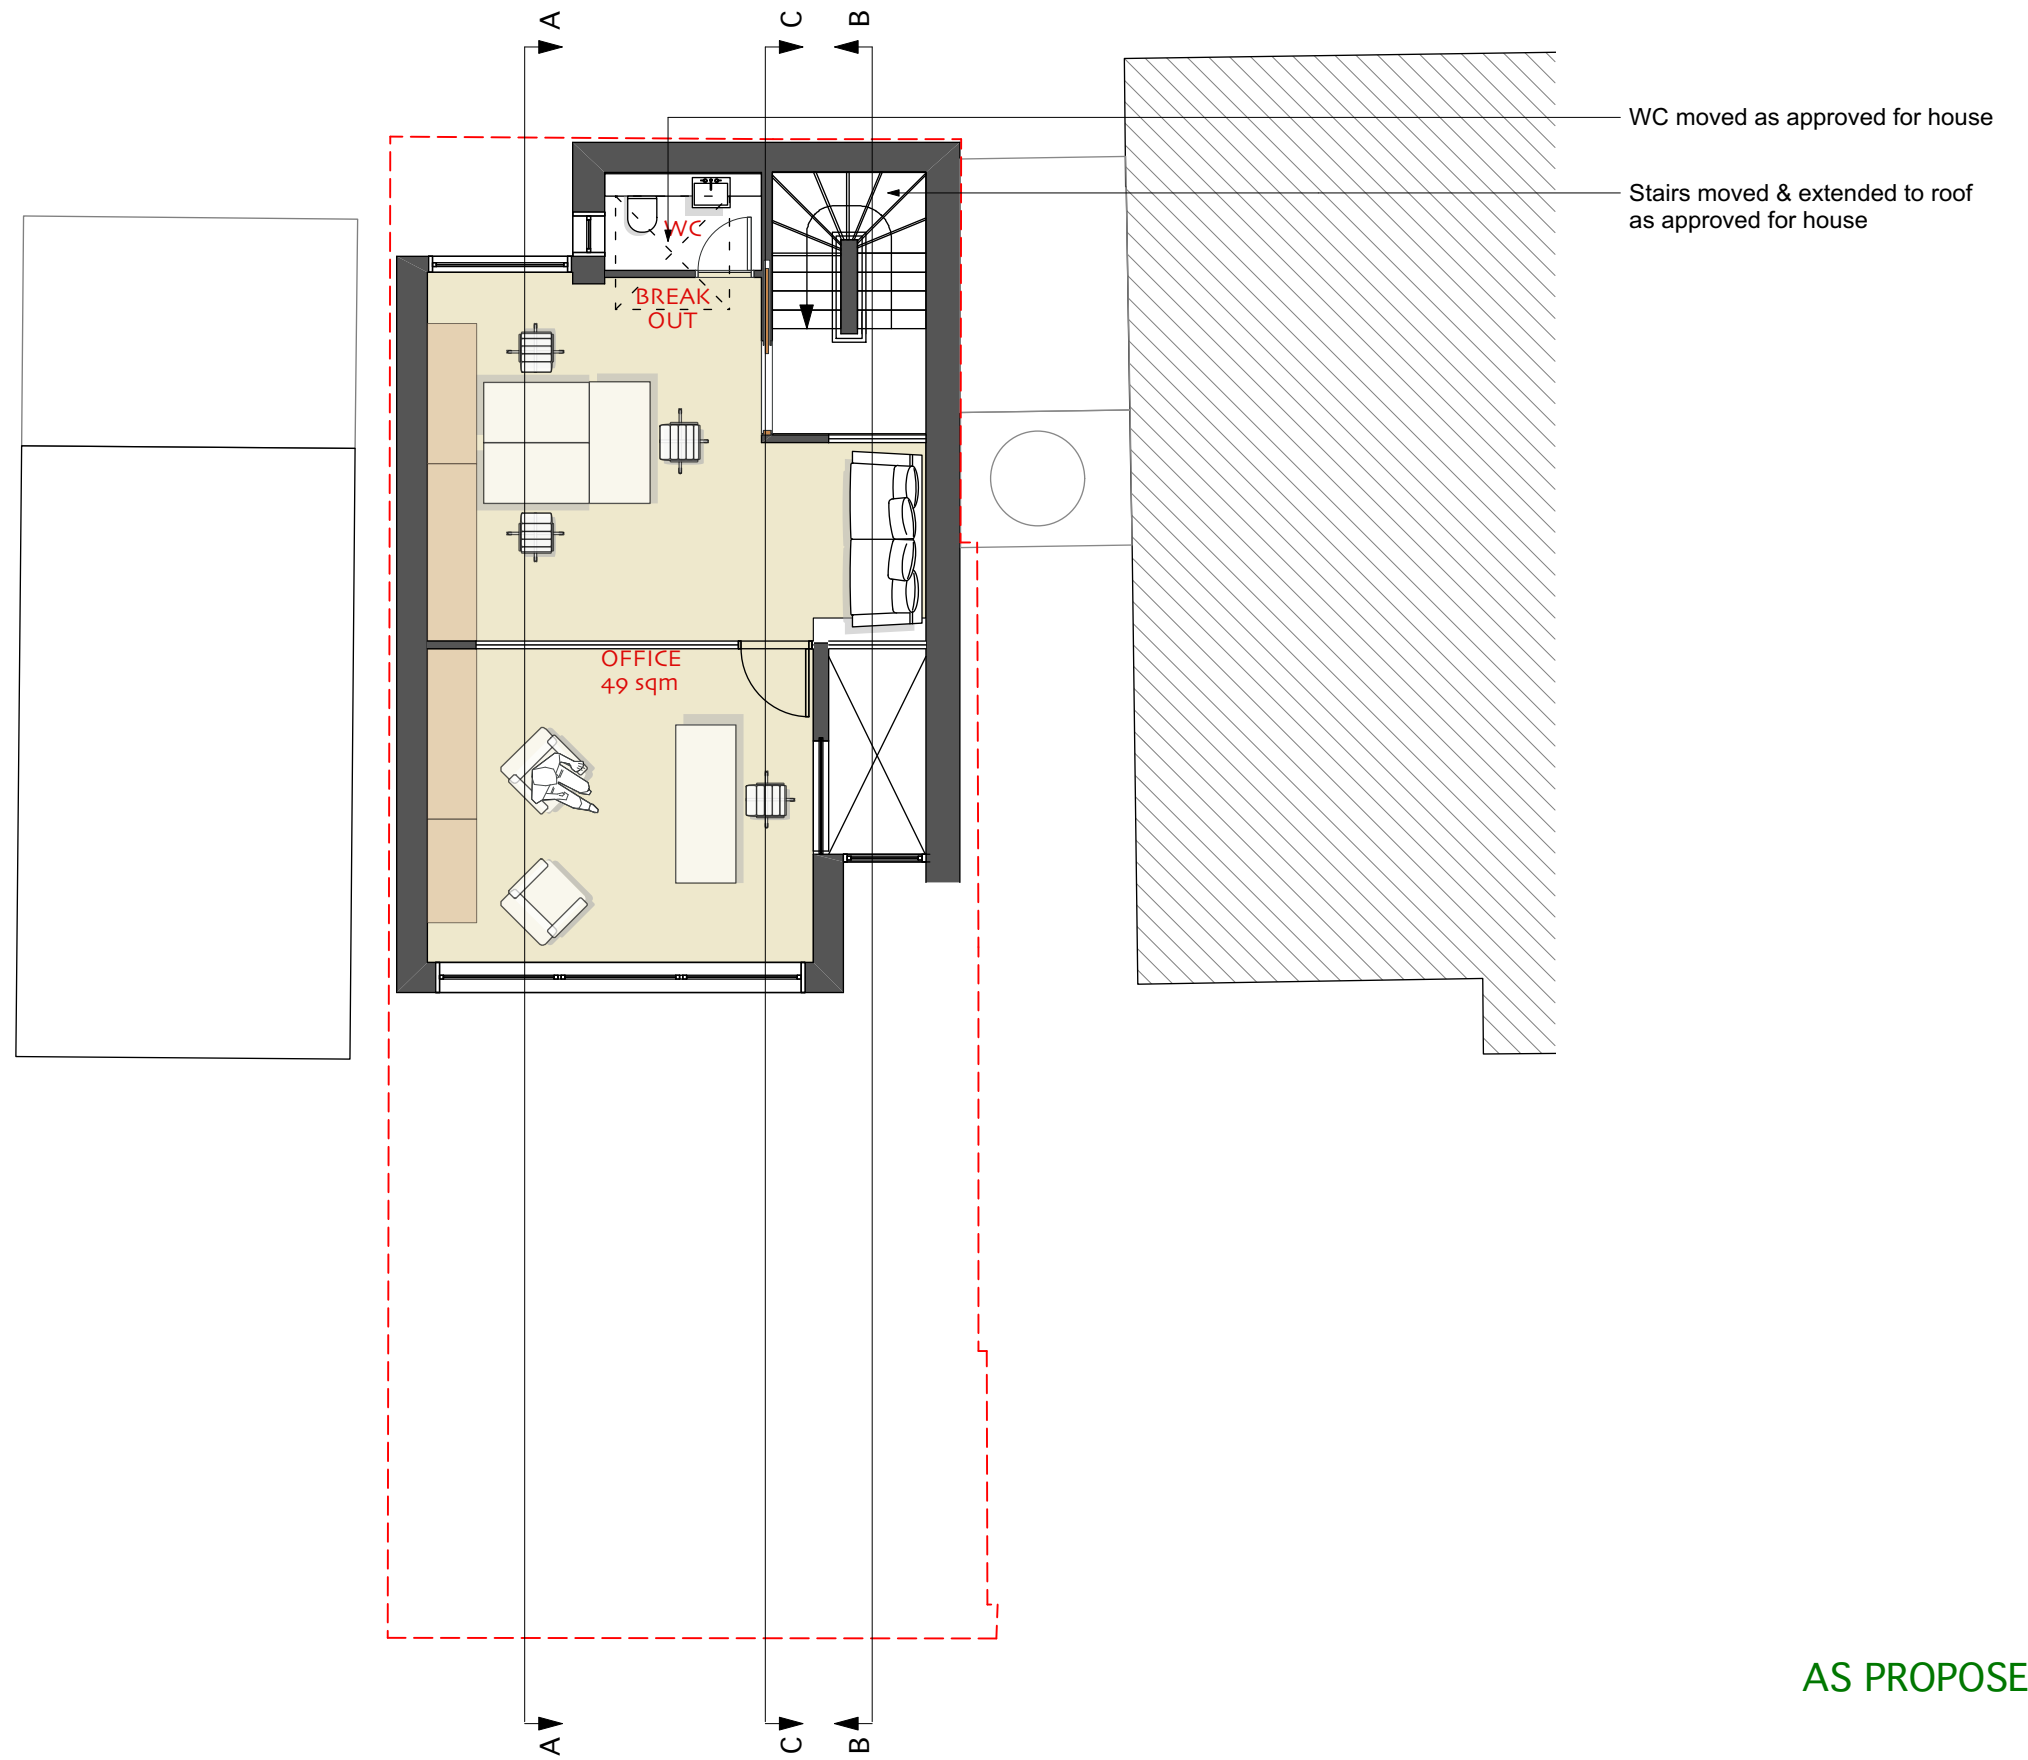


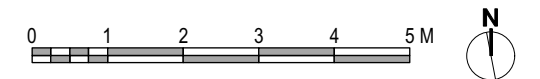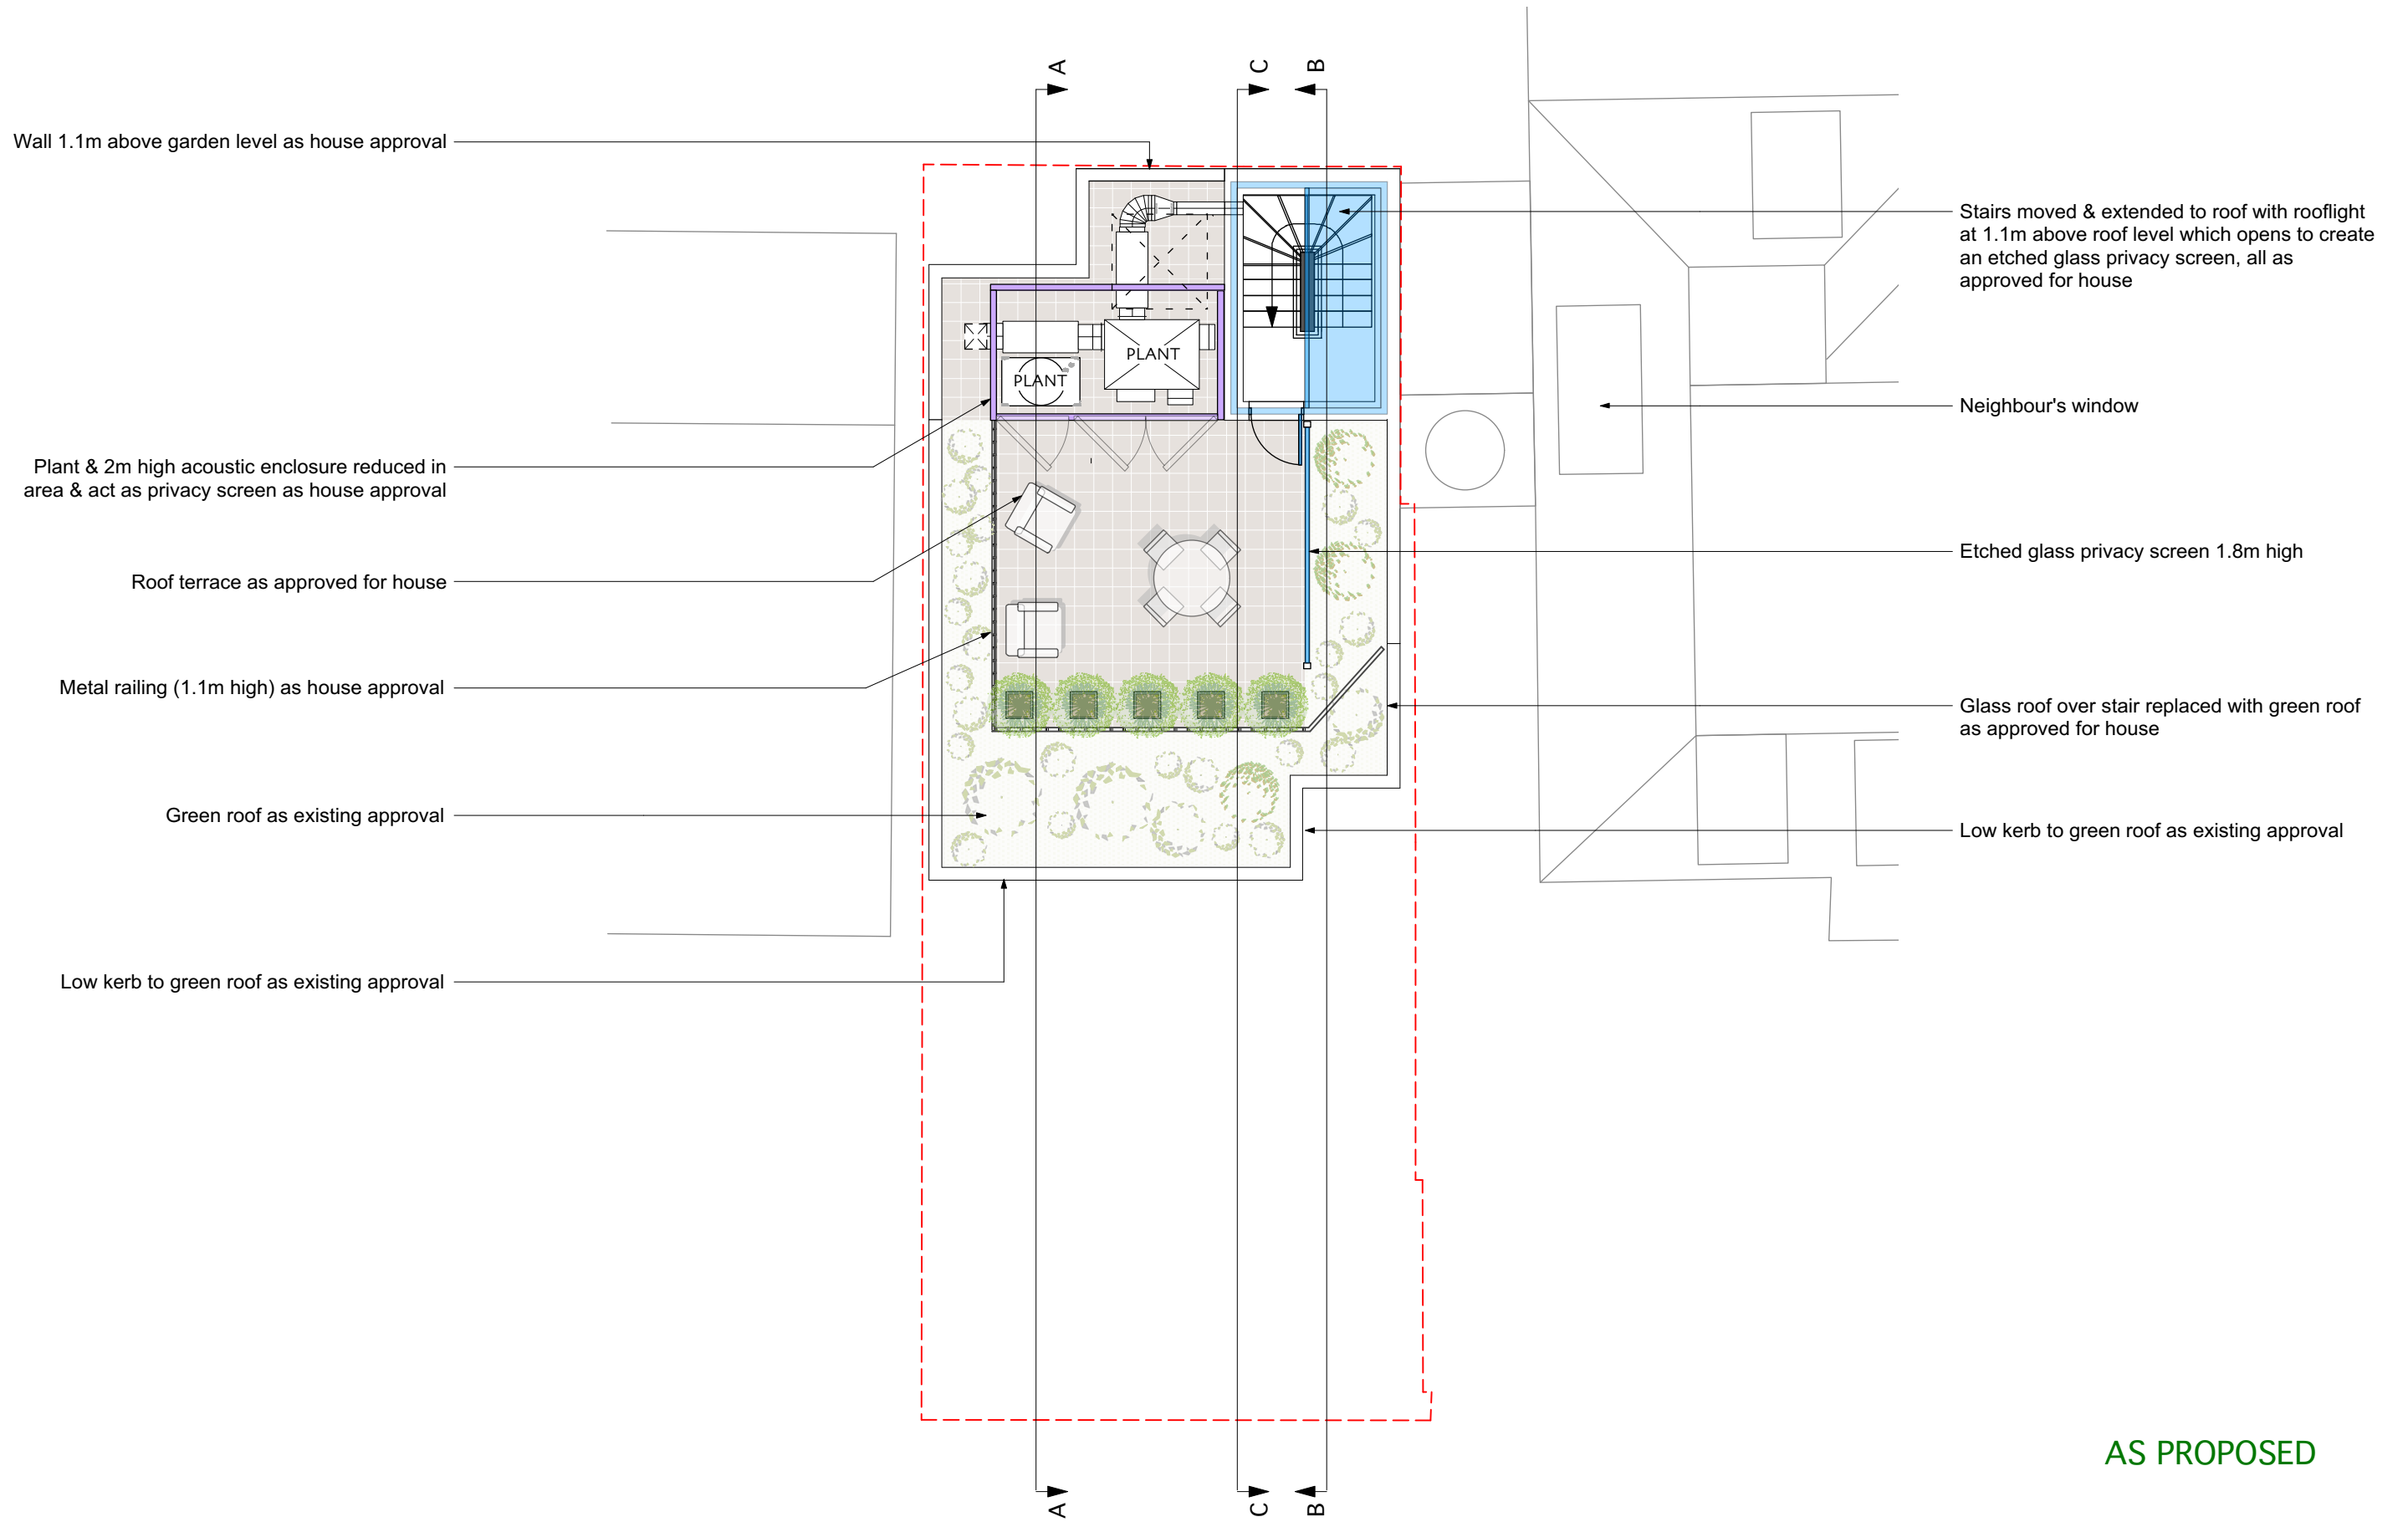

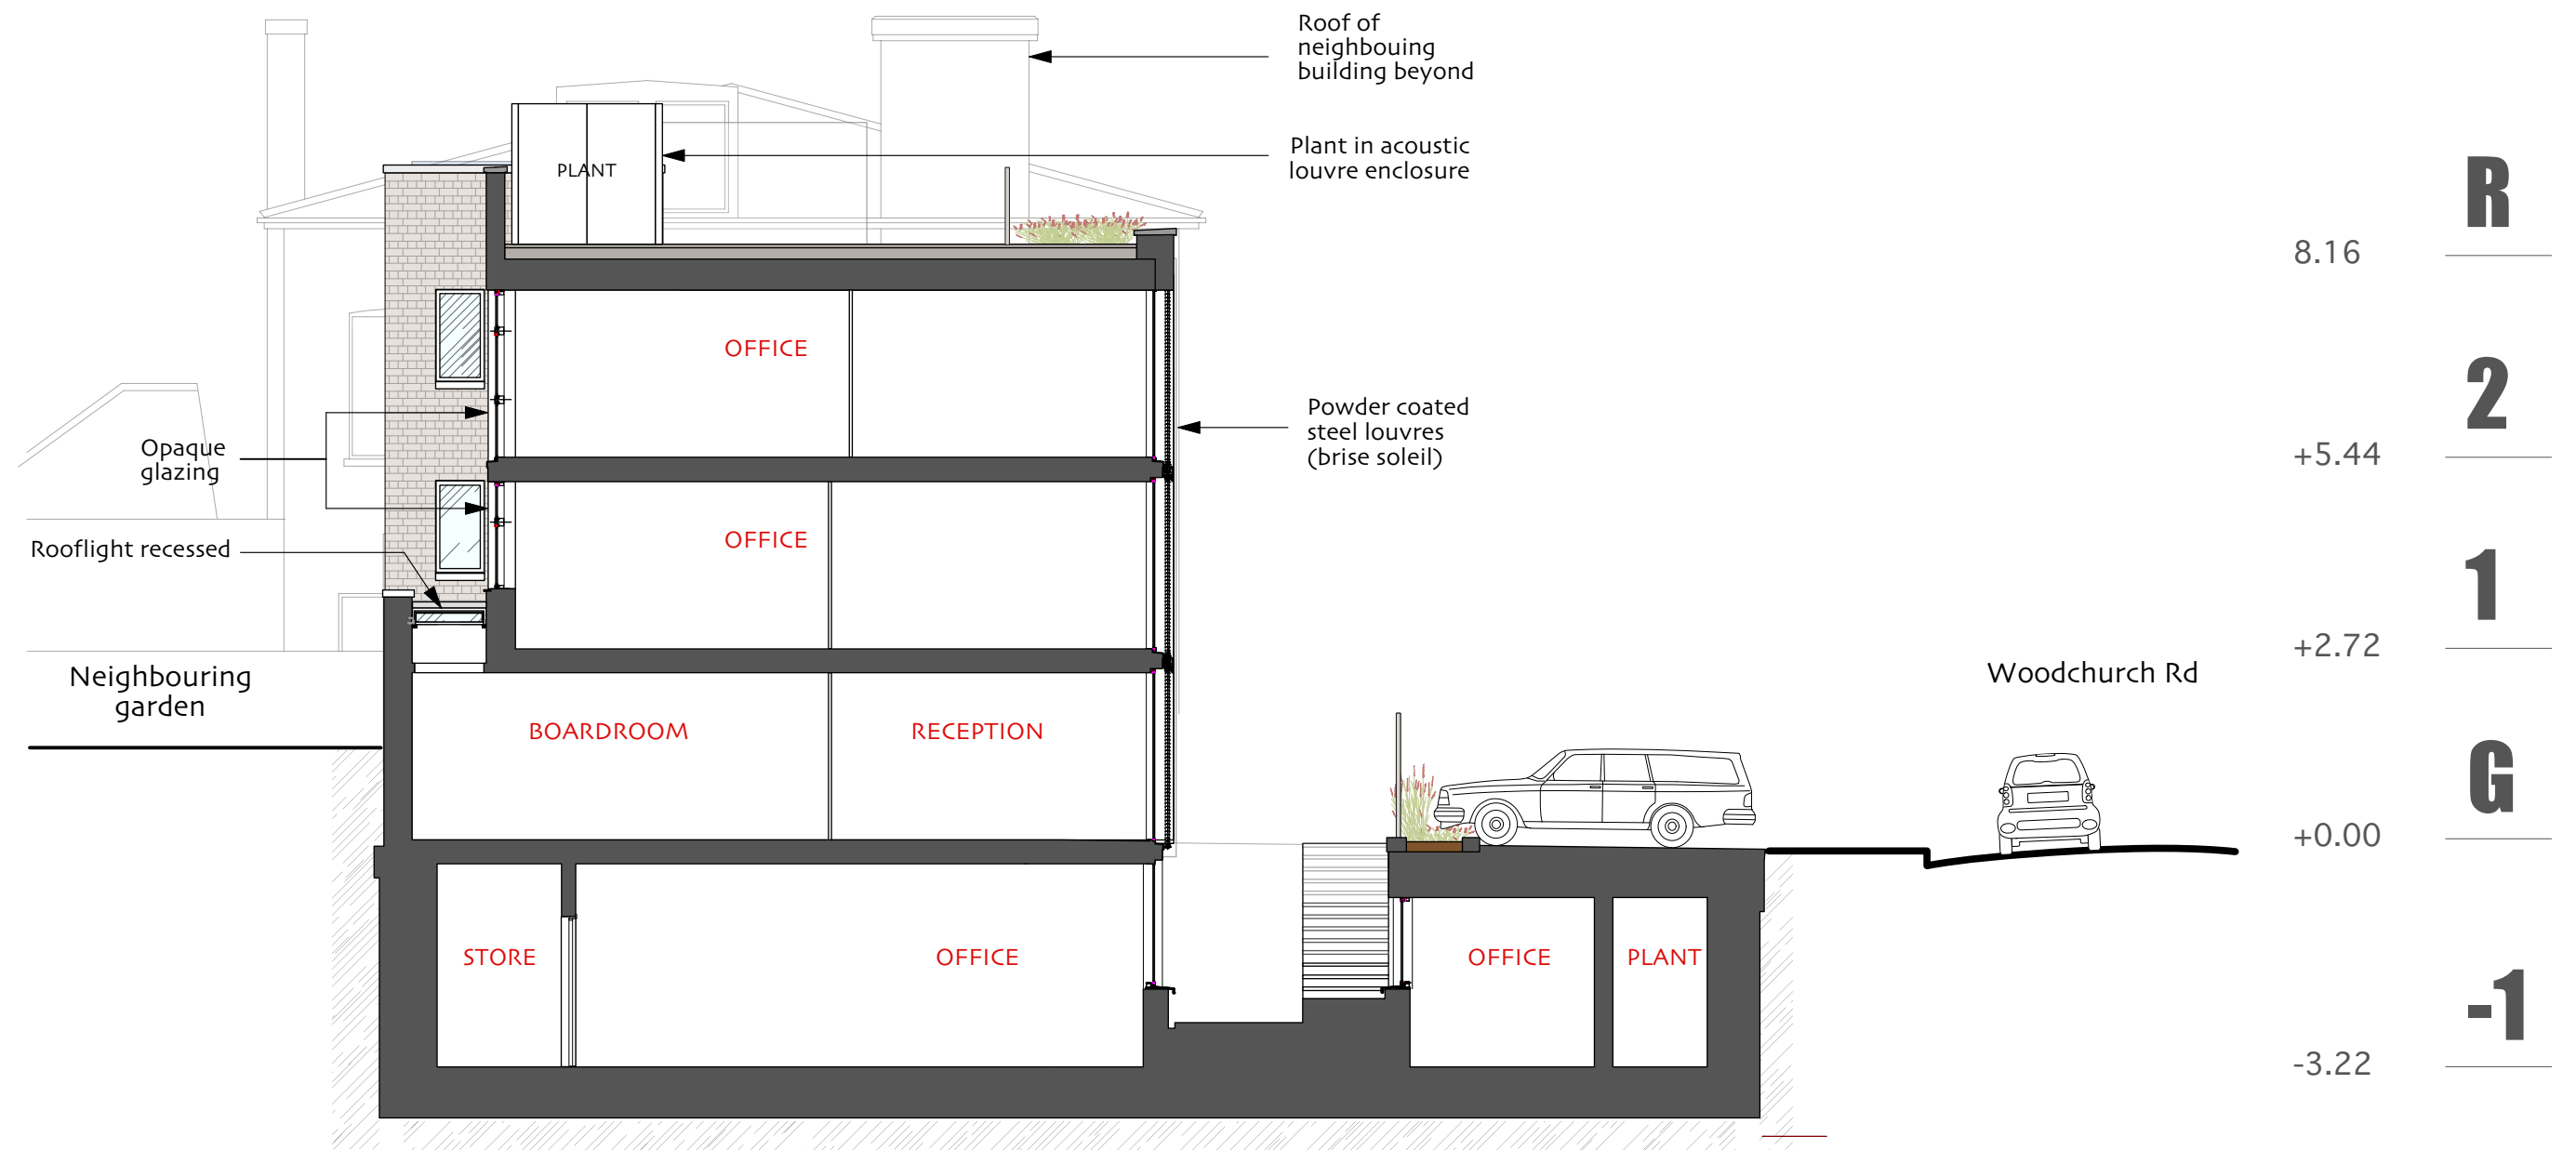



AS PROPOSED

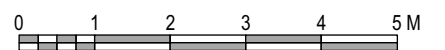

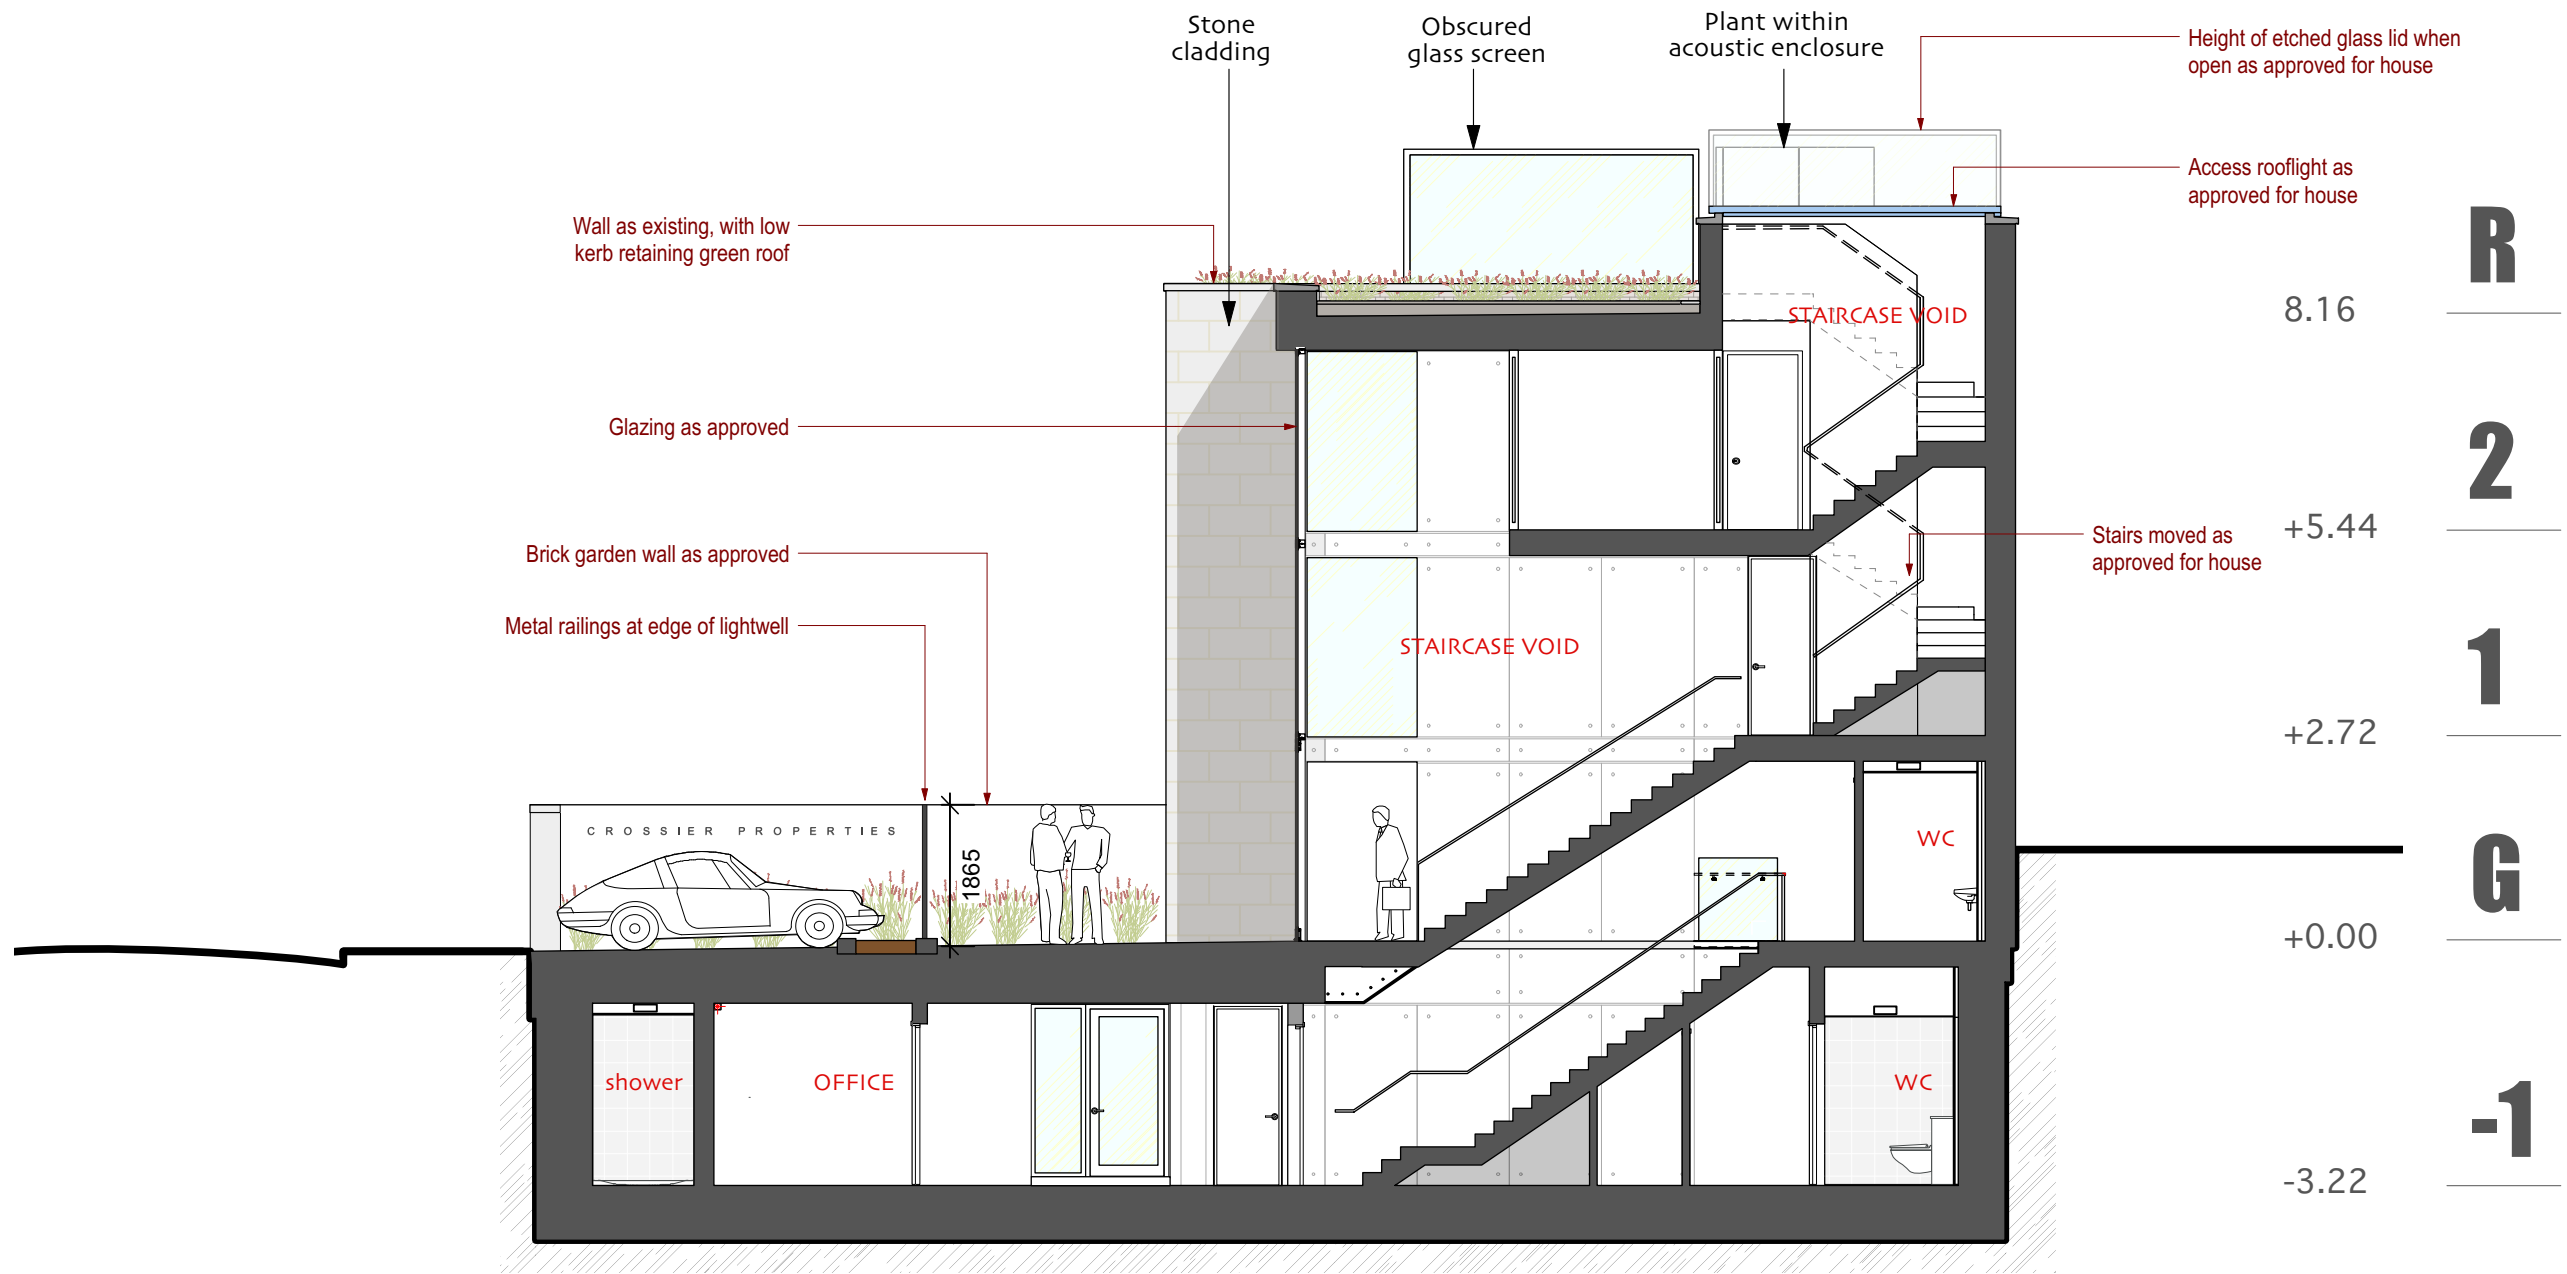


AS PROPOSED

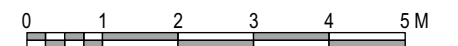


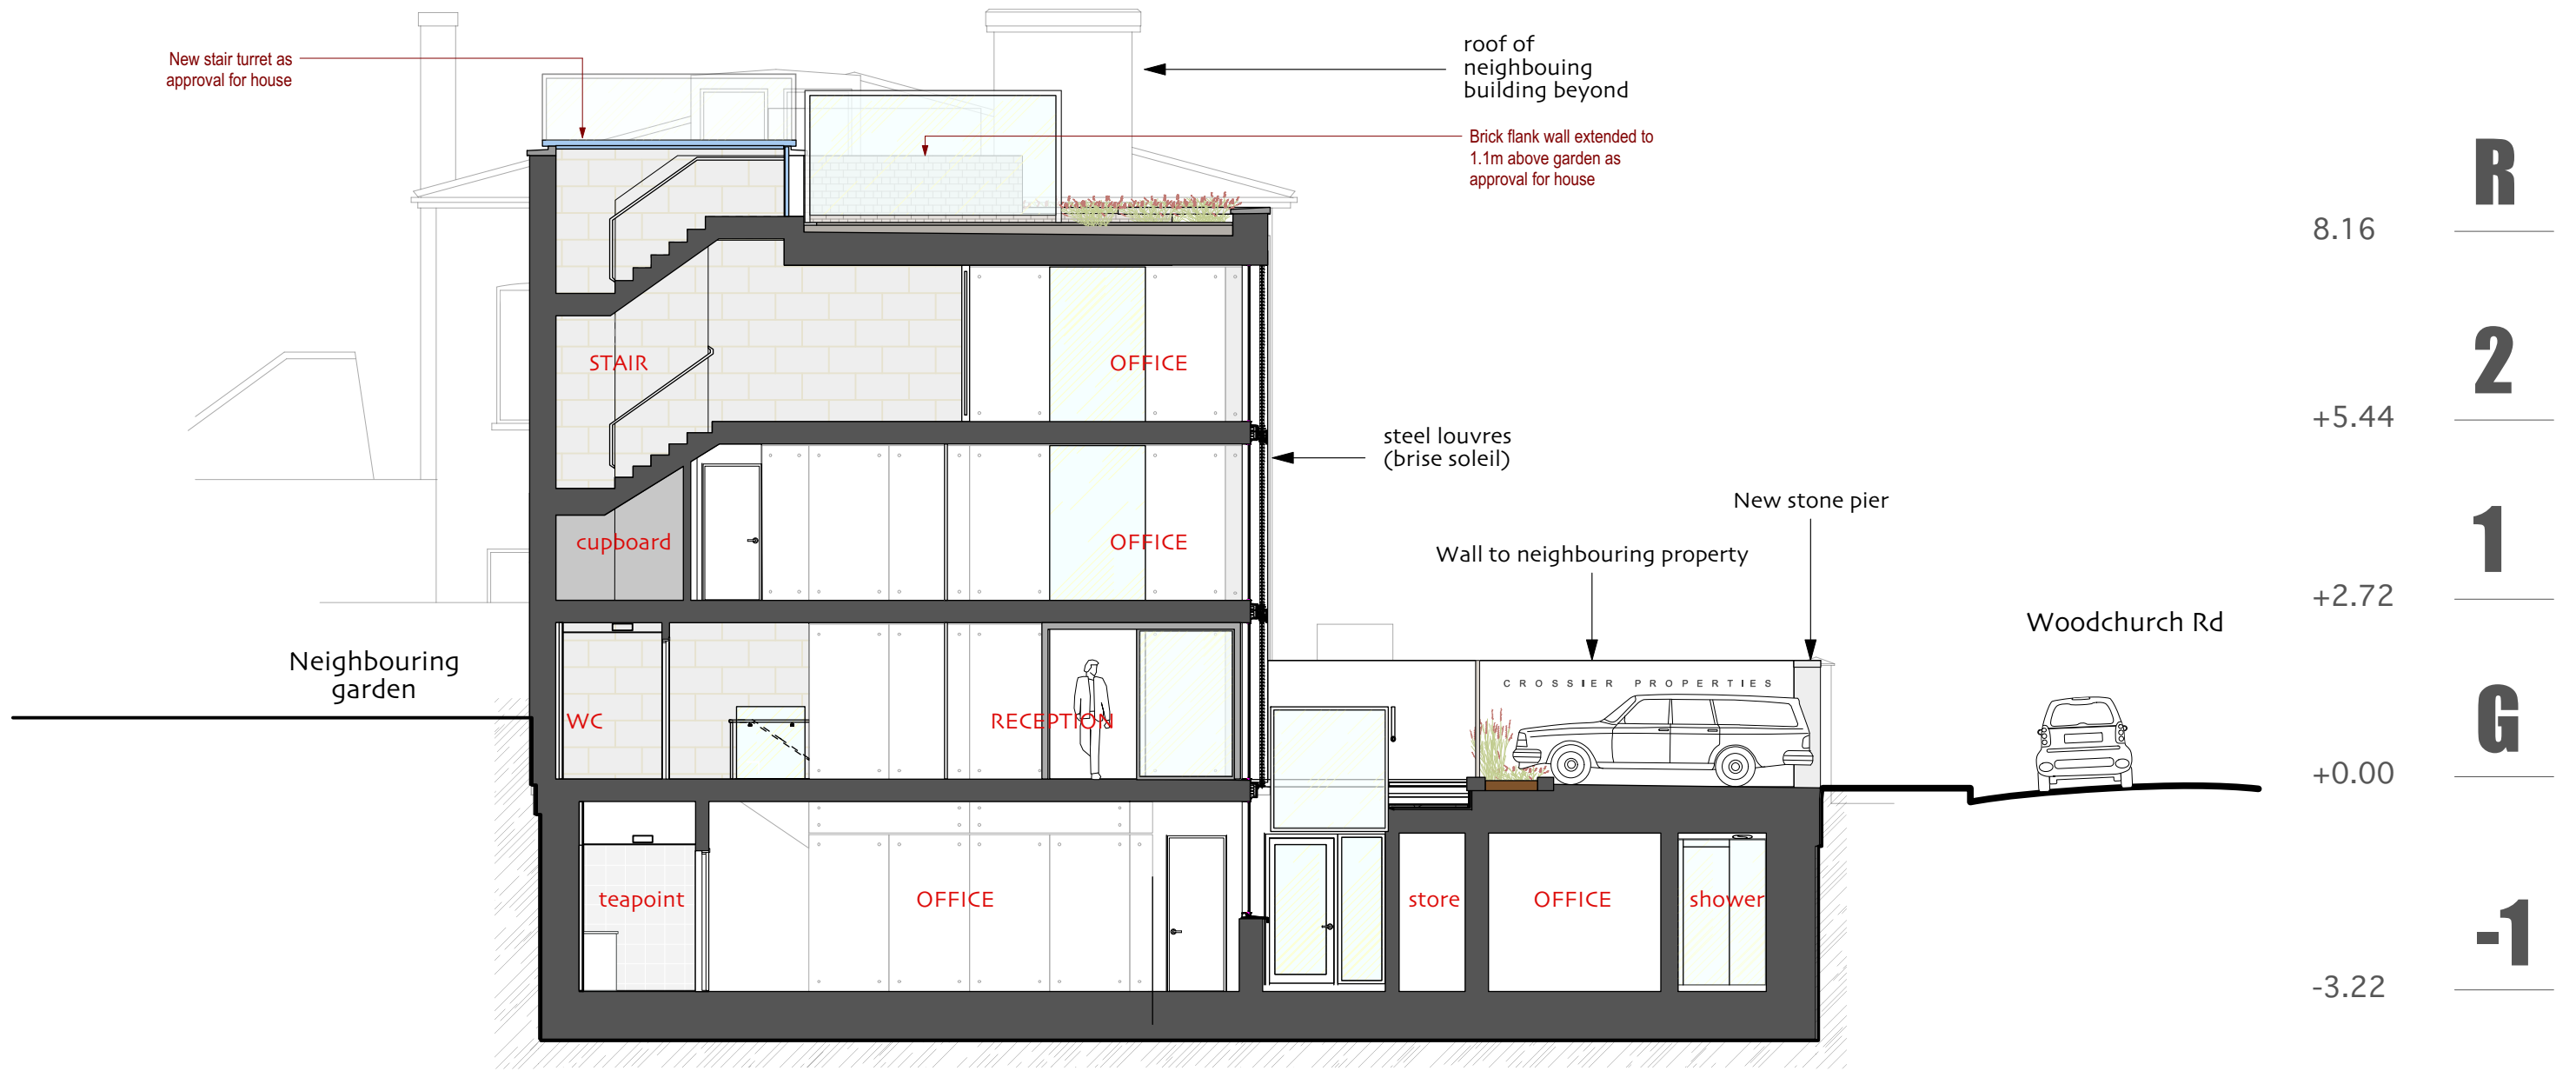


AS PROPOSED

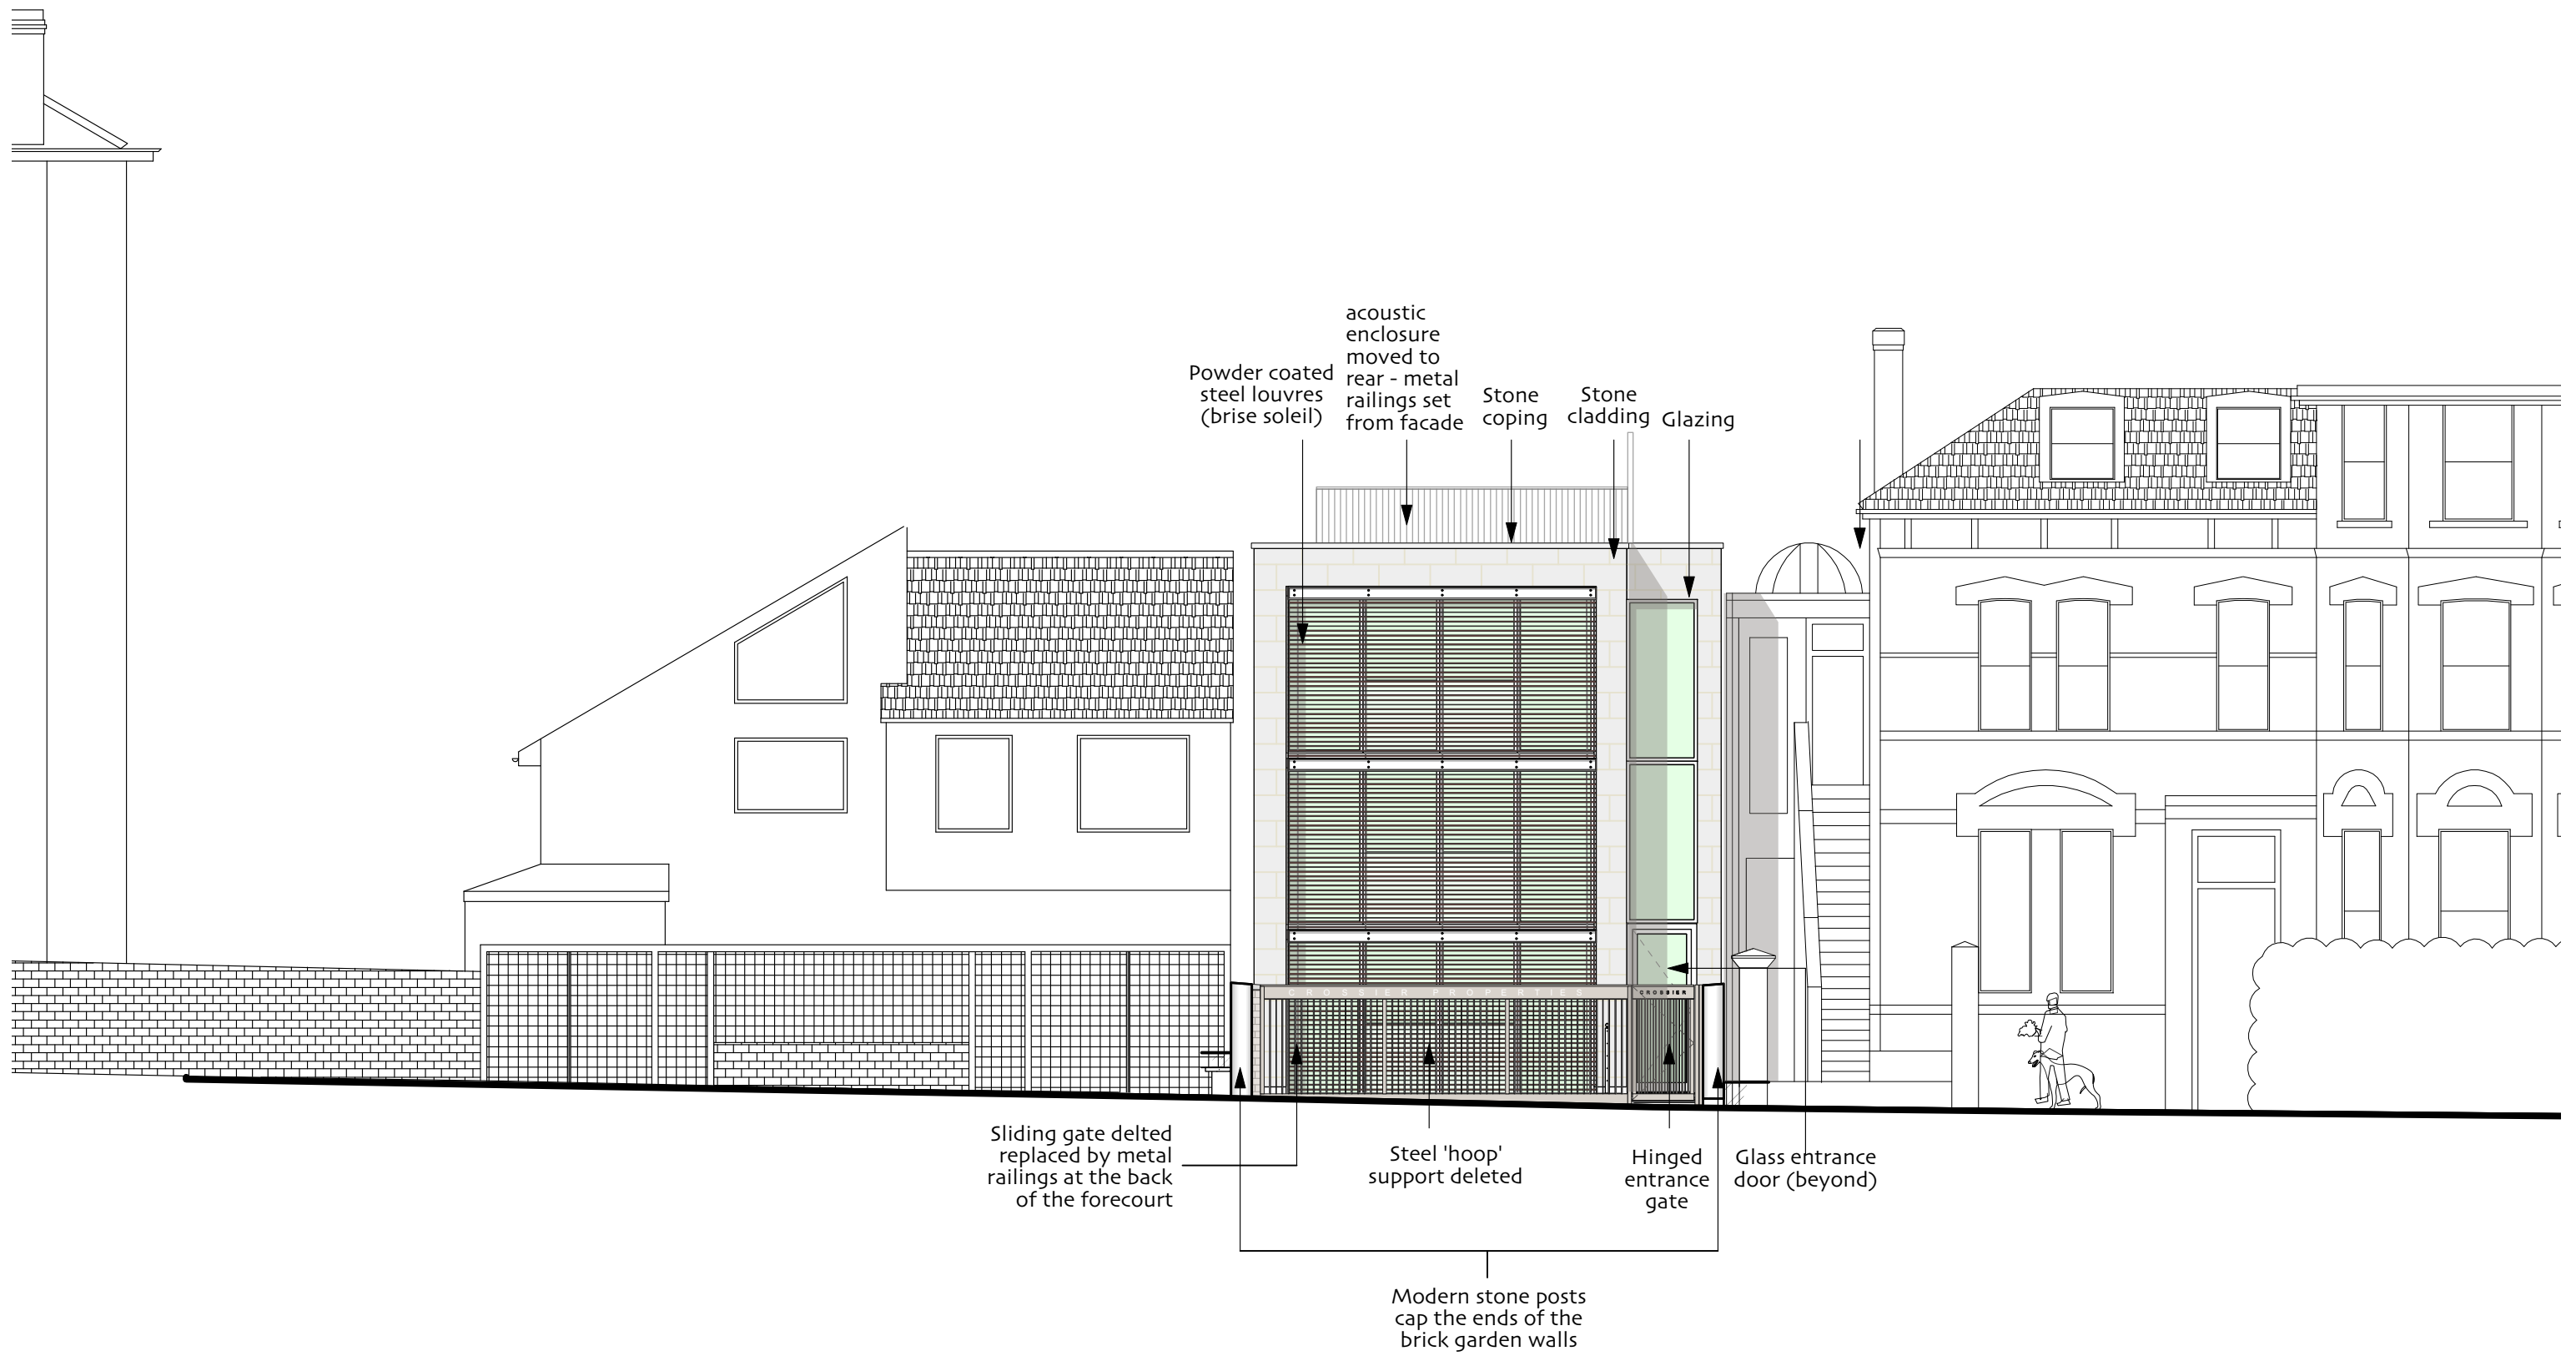

AS PROPOSED

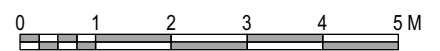

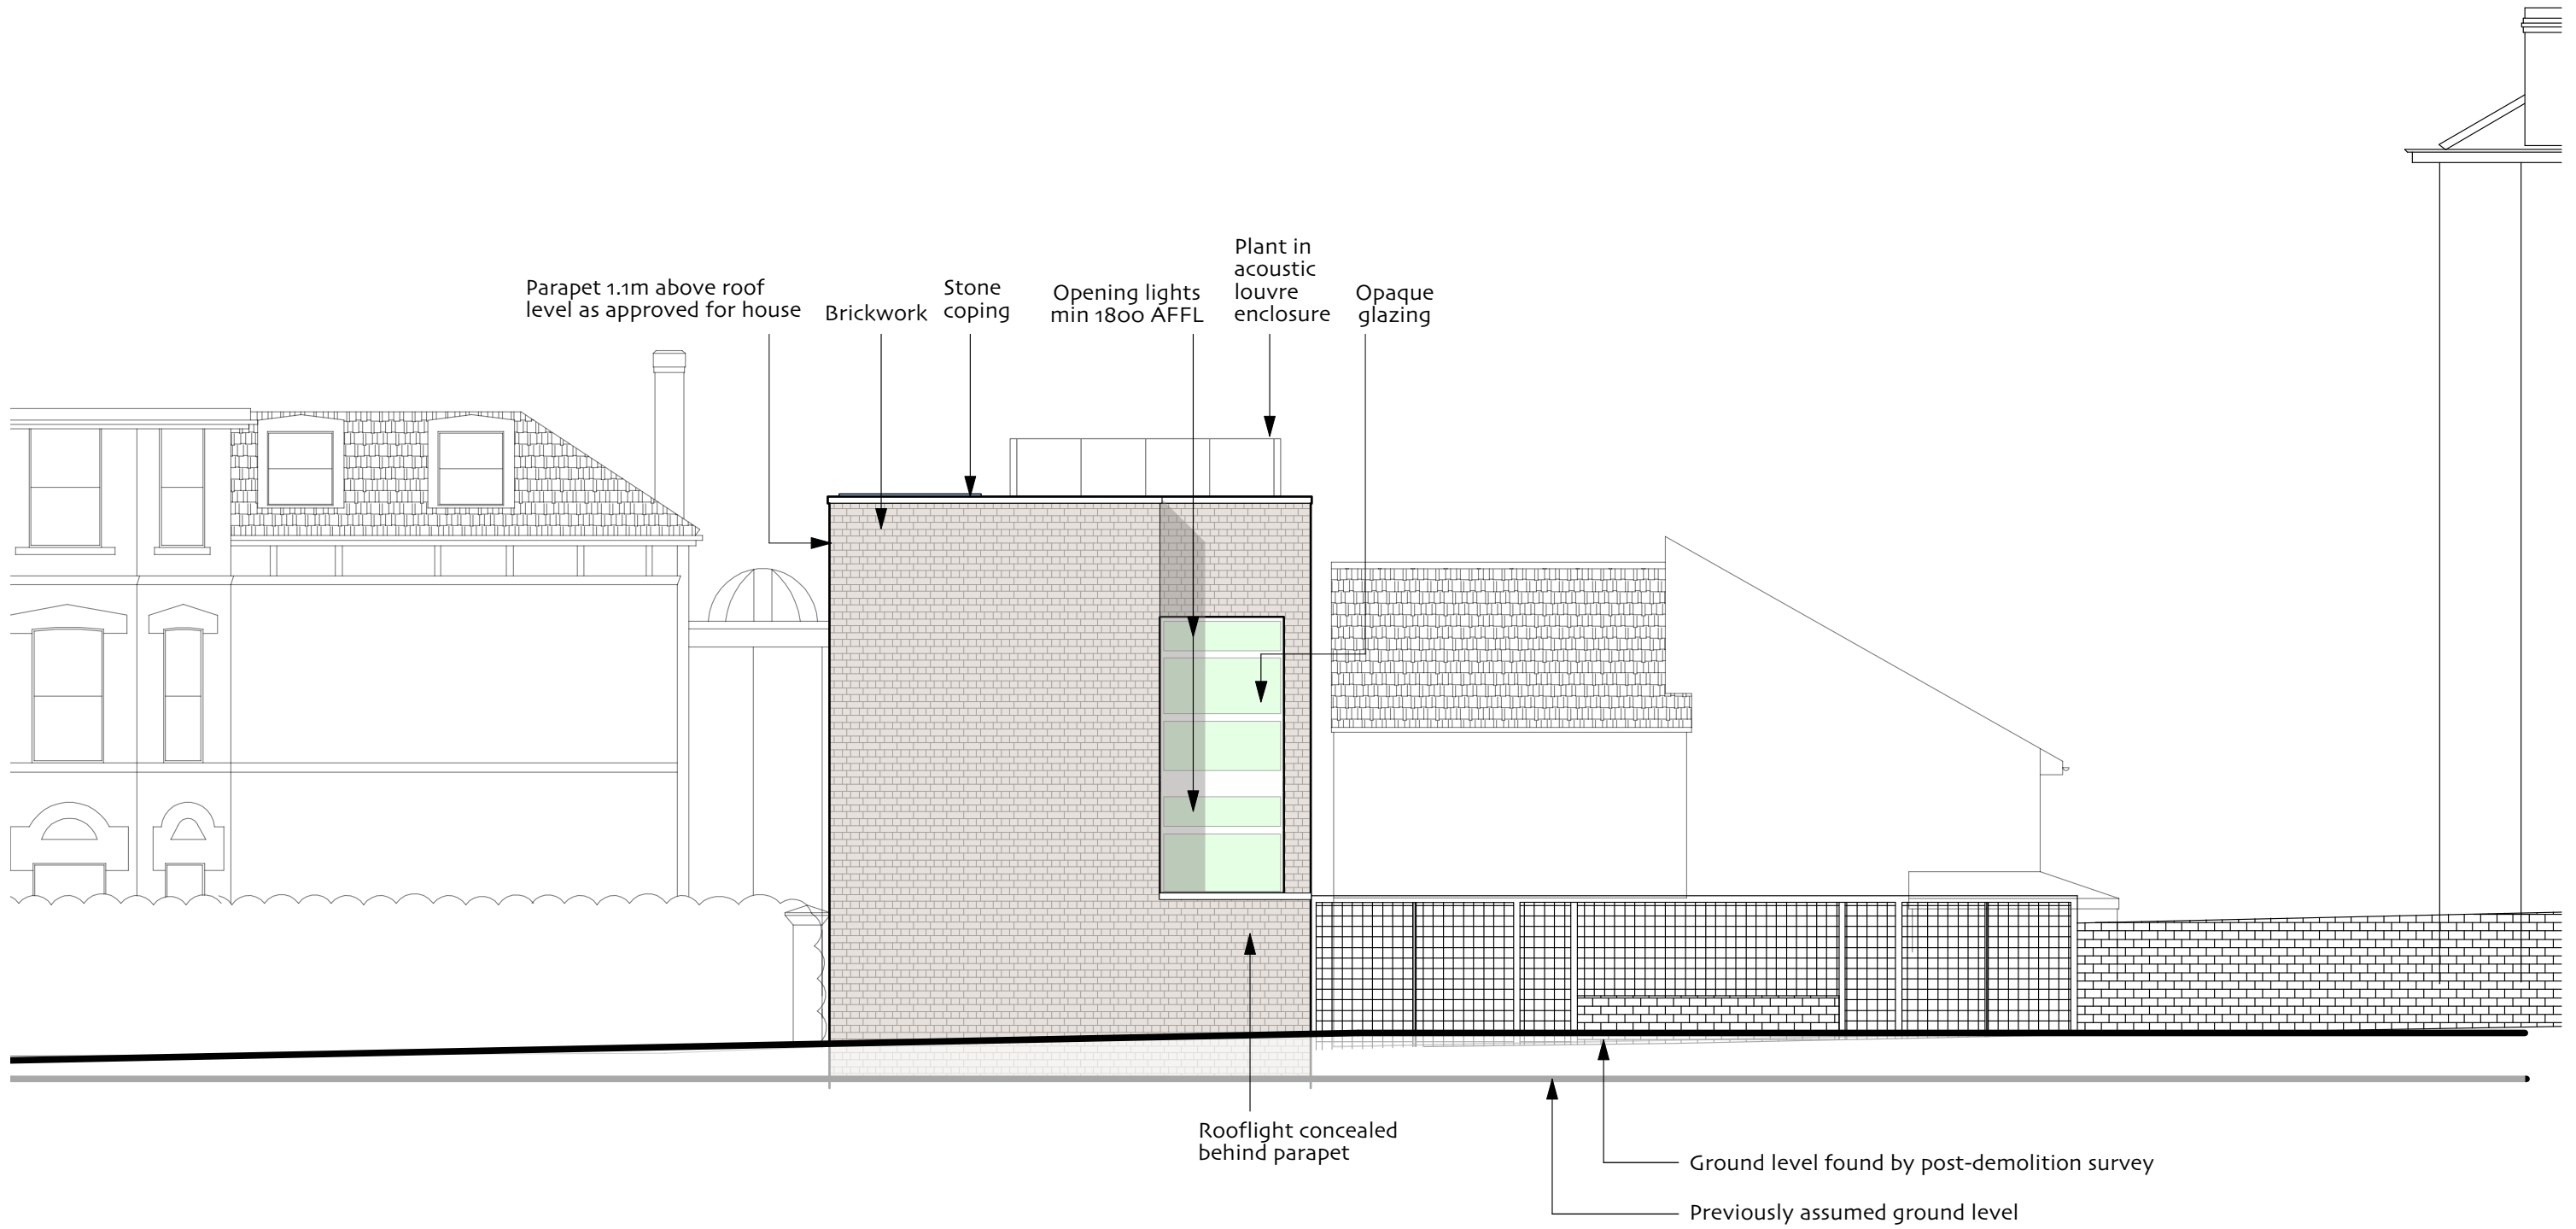

AS PROPOSED

