


DO NOT SCALE FROM DRAWING

THIS DRAWING IS CONFIDENTIAL AND IS THE PROPERTY OF SAPPHIRE MECHANICAL UK LTD. AND MUST BE RETURNED UPON REQUEST. IT MUST NOT BE COPIED, LENT OR EXHIBITED WITHOUT THE CONSENT OF SAPPHIRE MECHANICAL UK LTD.

THIS DRAWING IS COMPILED FROM THE FOLLOWING INFORMATION		
TITLE	DRAWING NO.	REV.

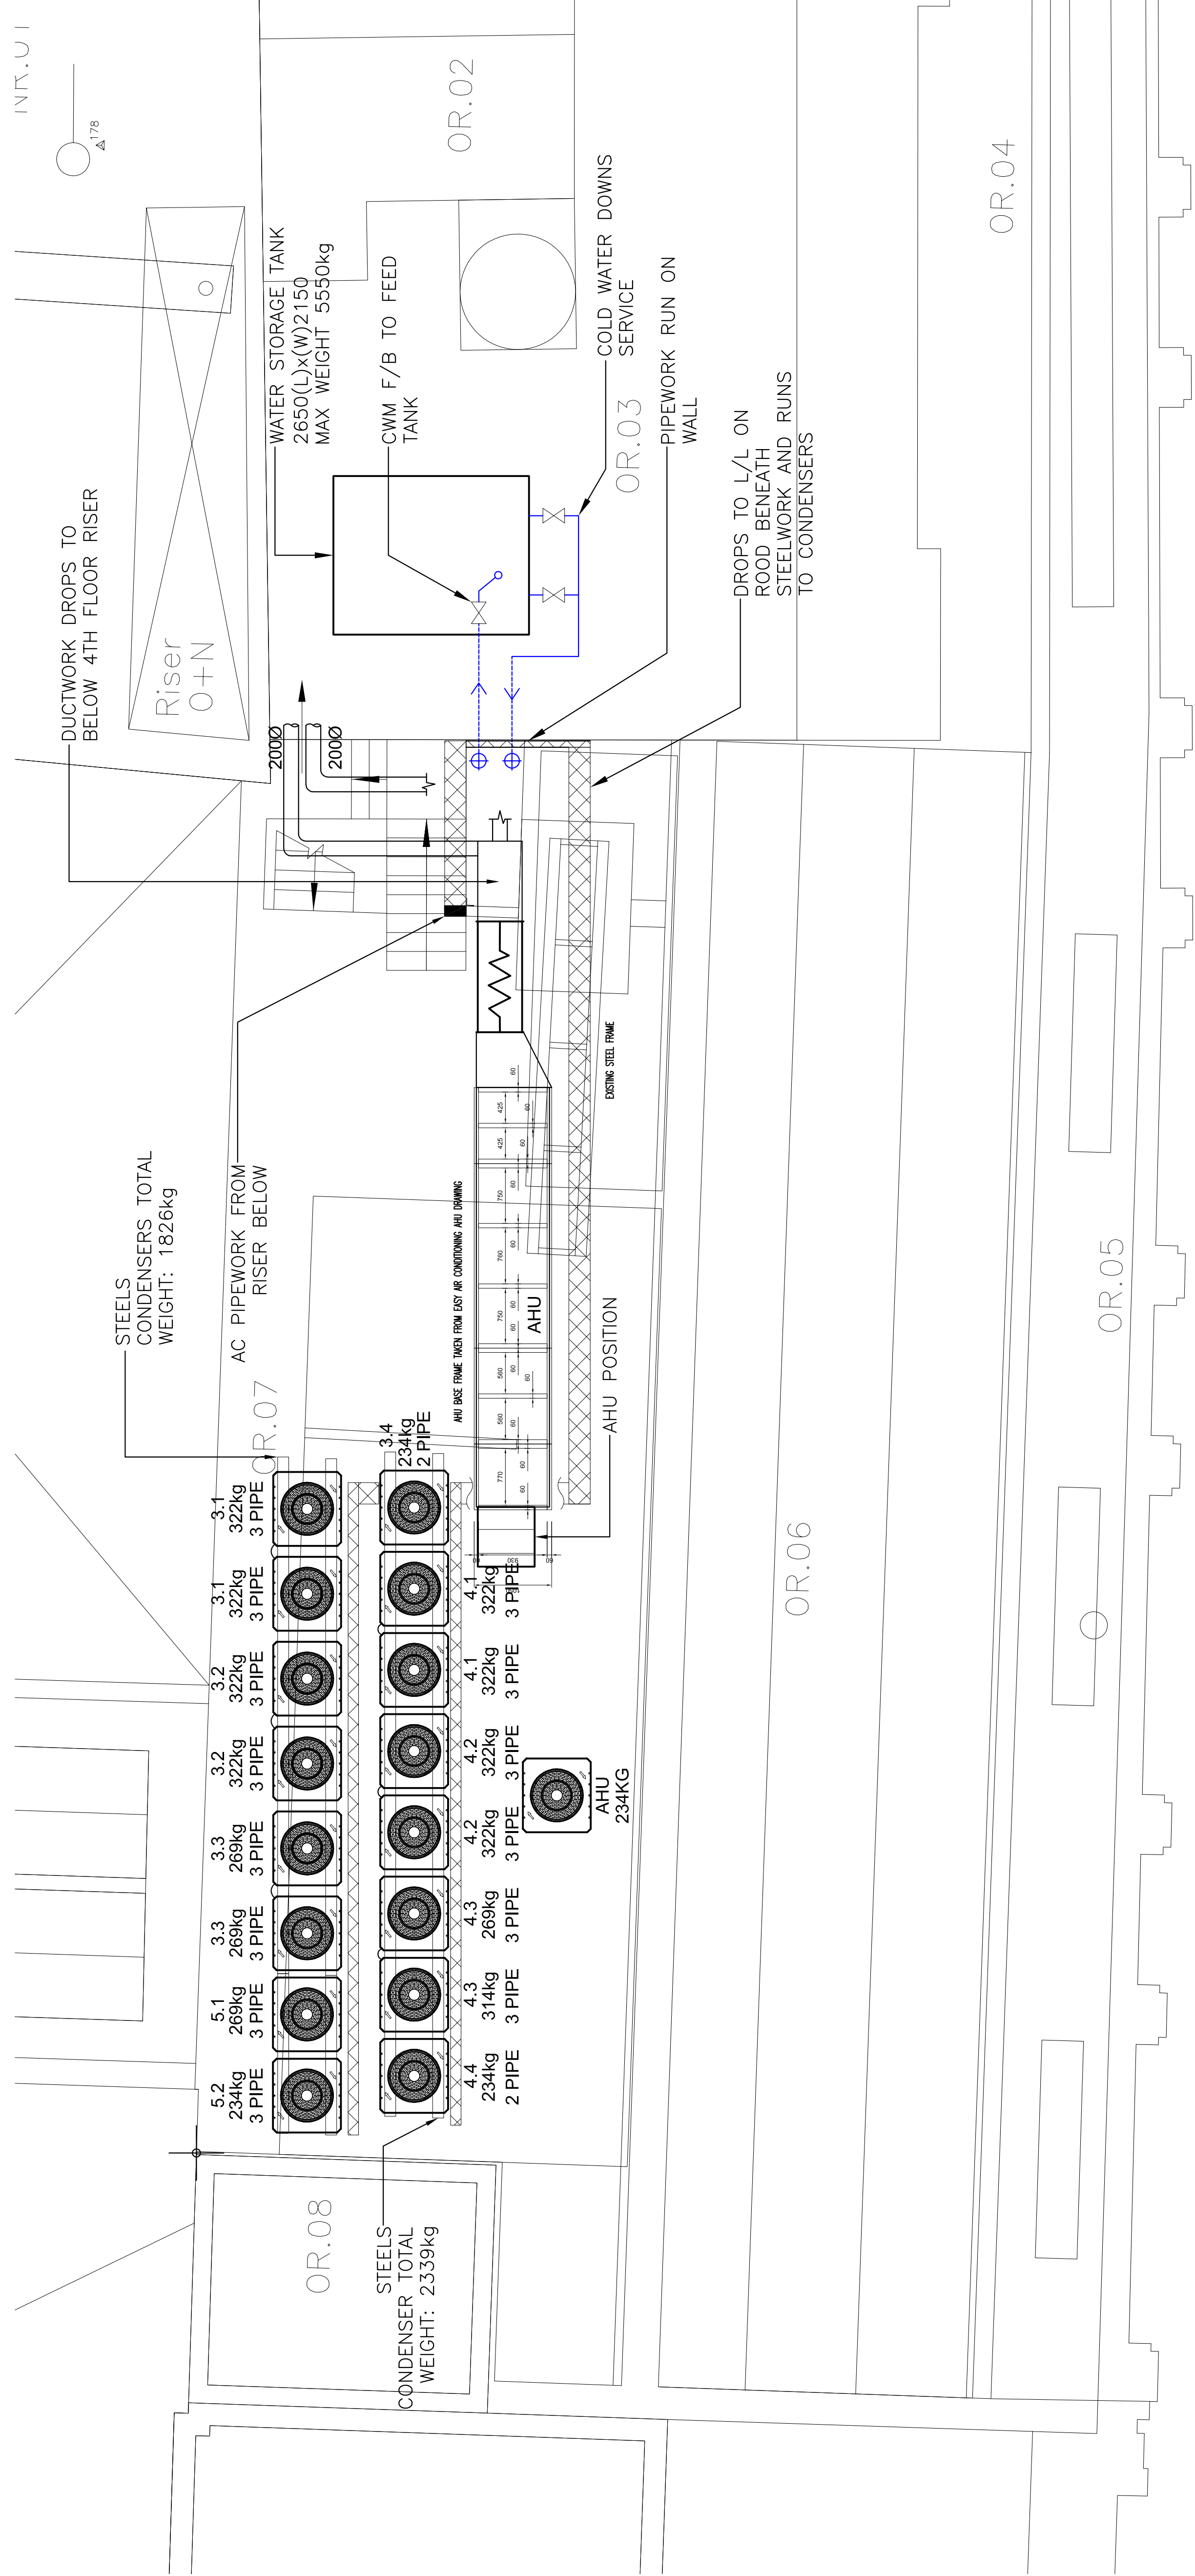

RD RECORD DRAWING REF 31.03.15 DATE

REVISION

RECORD DRAWING



SQUARE METRE

Project: Alfred Mews

Title: Roof Mechanical Services Layout

Date:	Issue Ref:
OCTOBER 2014	-
Project No.: 10988	Scale: 1:50 @ A1
Drawn: DG	HT
Rev.:	RD

SAP/10988/M/503