

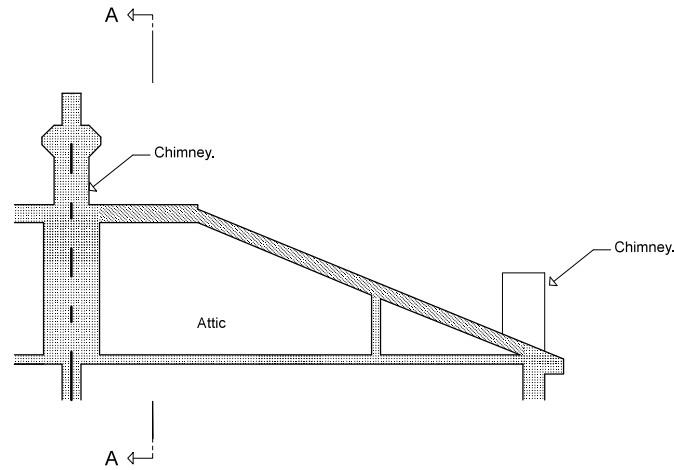


Existing Section B-B

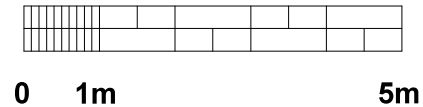

Proposed Section B-B

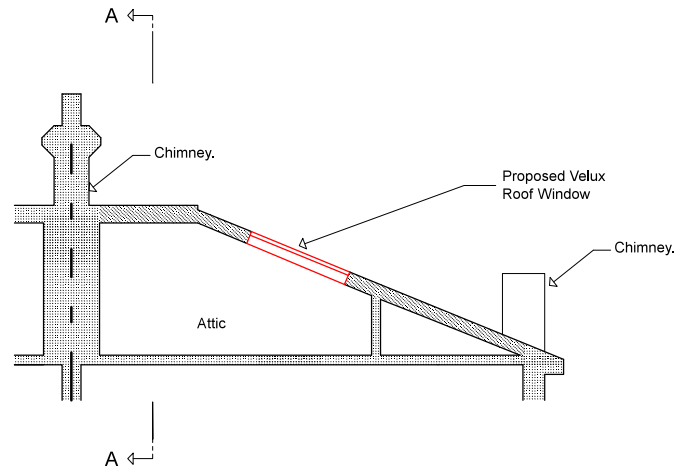

Please note that all dimensions must be checked on site and not scaled off this drawing

Preliminary	
Planning	X
Building Regs.	
Tender	
Construction	
As-built	X

Rev.	Date	Revision

File Ref: Existing & Proposed Section B-B.pdf

Client	
Project	Flat 3, 4 Priory Road

Drawing Title  
**Existing & Proposed Section B-B**

Scale	1:100	Drawing size.	A4
-------	-------	---------------	----

Date	September 2015
------	----------------

Reference No.	Rev.