
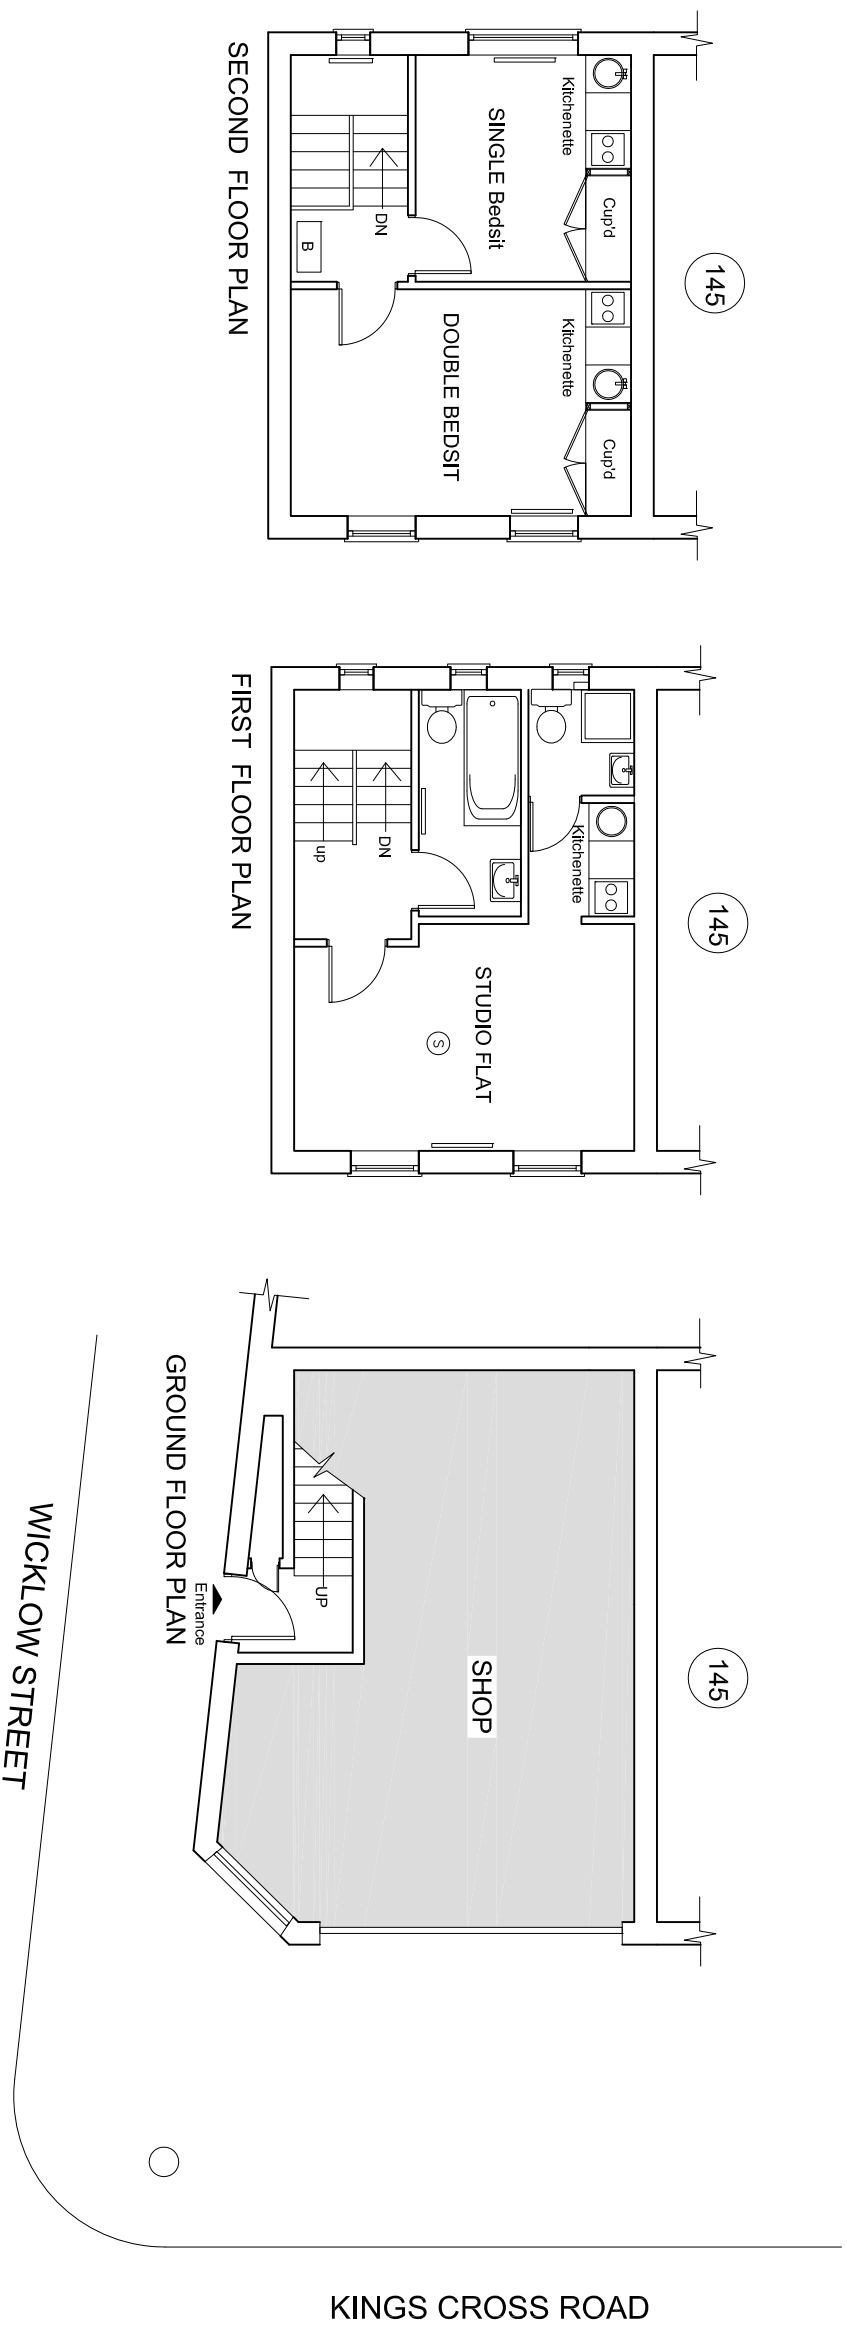


- NOTES:**
1. This drawing is a COPYRIGHT of Studio 11 Development.
 2. Do not scale the drawing, use figured dimensions only.
 3. All dimensions must be checked on site and Studio 11 Development should be informed immediately of any discrepancies prior to construction.

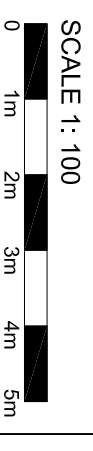

WICKLOW STREET

KINGS CROSS ROAD

ISSUE	DESCRIPTION
-------	-------------

STUDIO 11 DEVELOPMENT

Architectural Consultants

79 ST. BARNABAS ROAD WOODFORD GREEN IG8 7BY
 Tel: 07940593742 Fax: 0871 266 4177
 e-mail: studio11development@gmail.com

Project:
 143 KINGS CROSS ROAD
 LONDON
 WC1X 9BN

Drawing Title:
 AS BUILT PLANS

Drawn:	Date:	Scale:
Z.D.	SEP 15	1:100 @ A3
Plan No.	Issue:	Status:
143 (01)-01	A	Preliminary drawing Tender drawing Working drawing