


• DO NOT MEASURE FROM DRAWING
• IF IN DOUBT ASK

KEY



ADMIRAL'S WALK

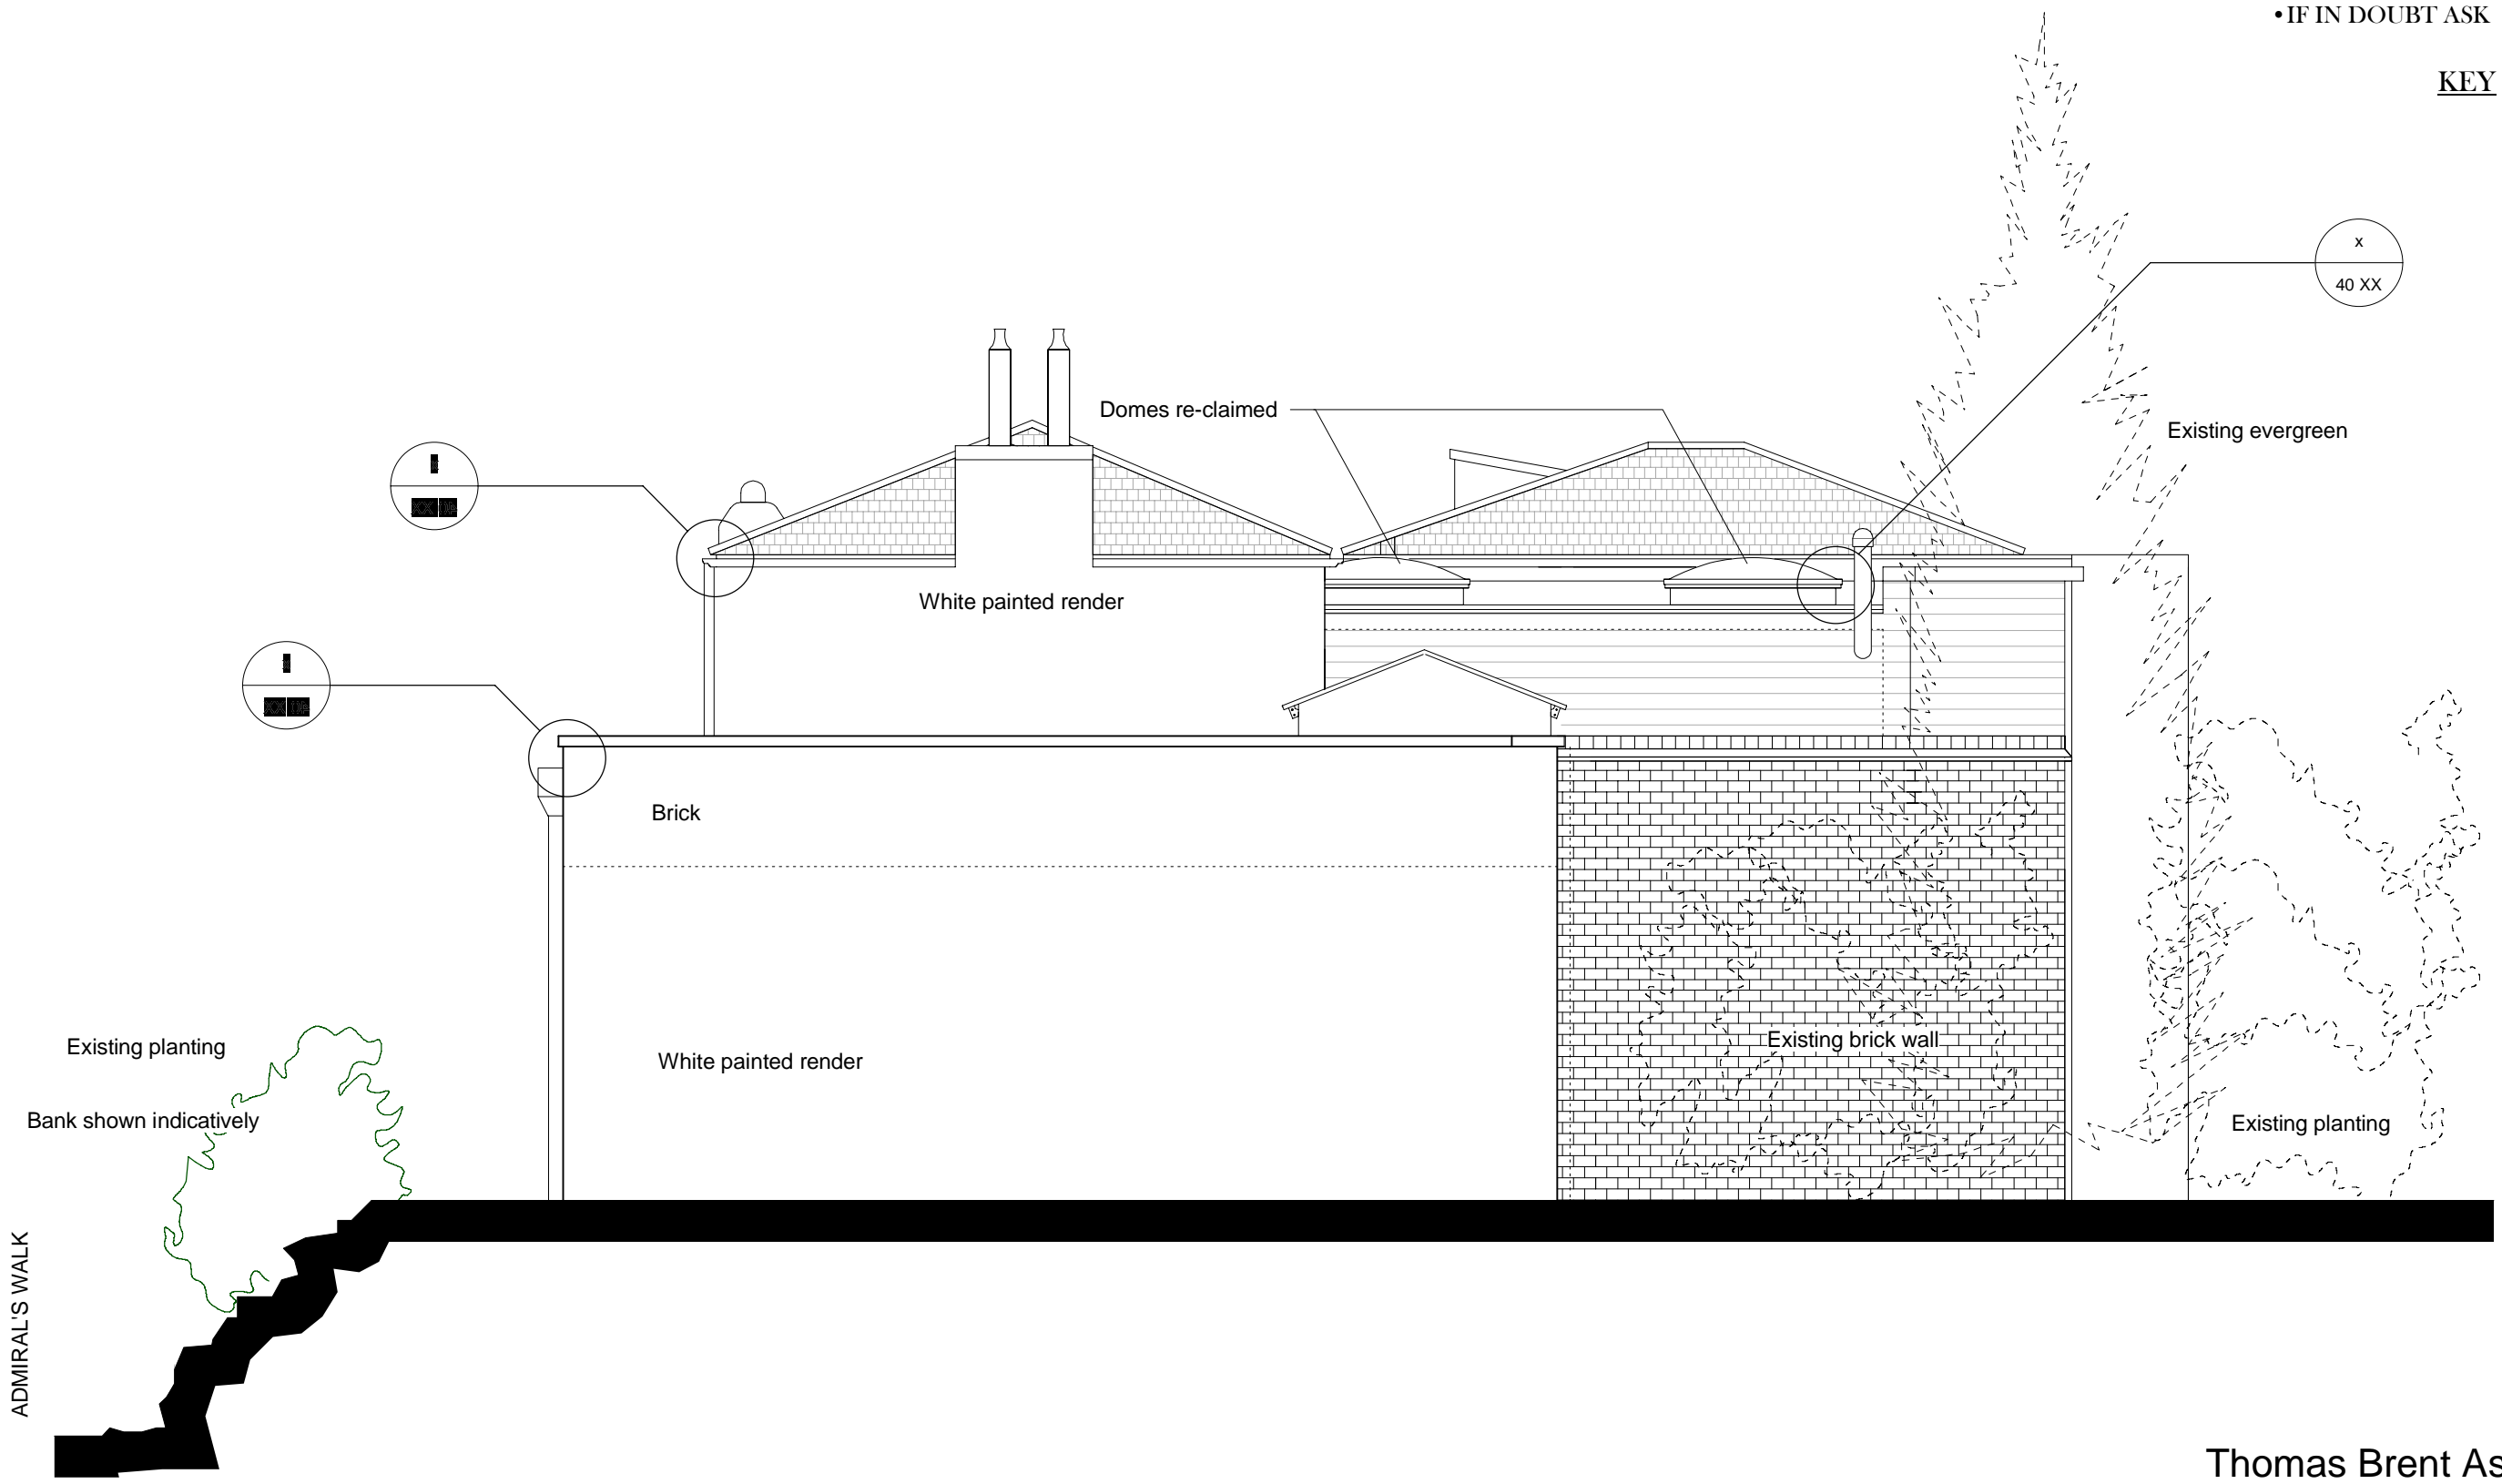

Thomas Brent Associates Ltd.

Seaton House

Terrace Lodge, Admirals Walk,
Hampstead, NW3
East Elevation - EXISTING / AS BUILT

Scale 1:50 @ A3

Drawing Number 20 E1 A