


• DO NOT MEASURE FROM DRAWING  
 • IF IN DOUBT ASK

Notes

2 Wall build up - see 40 xx

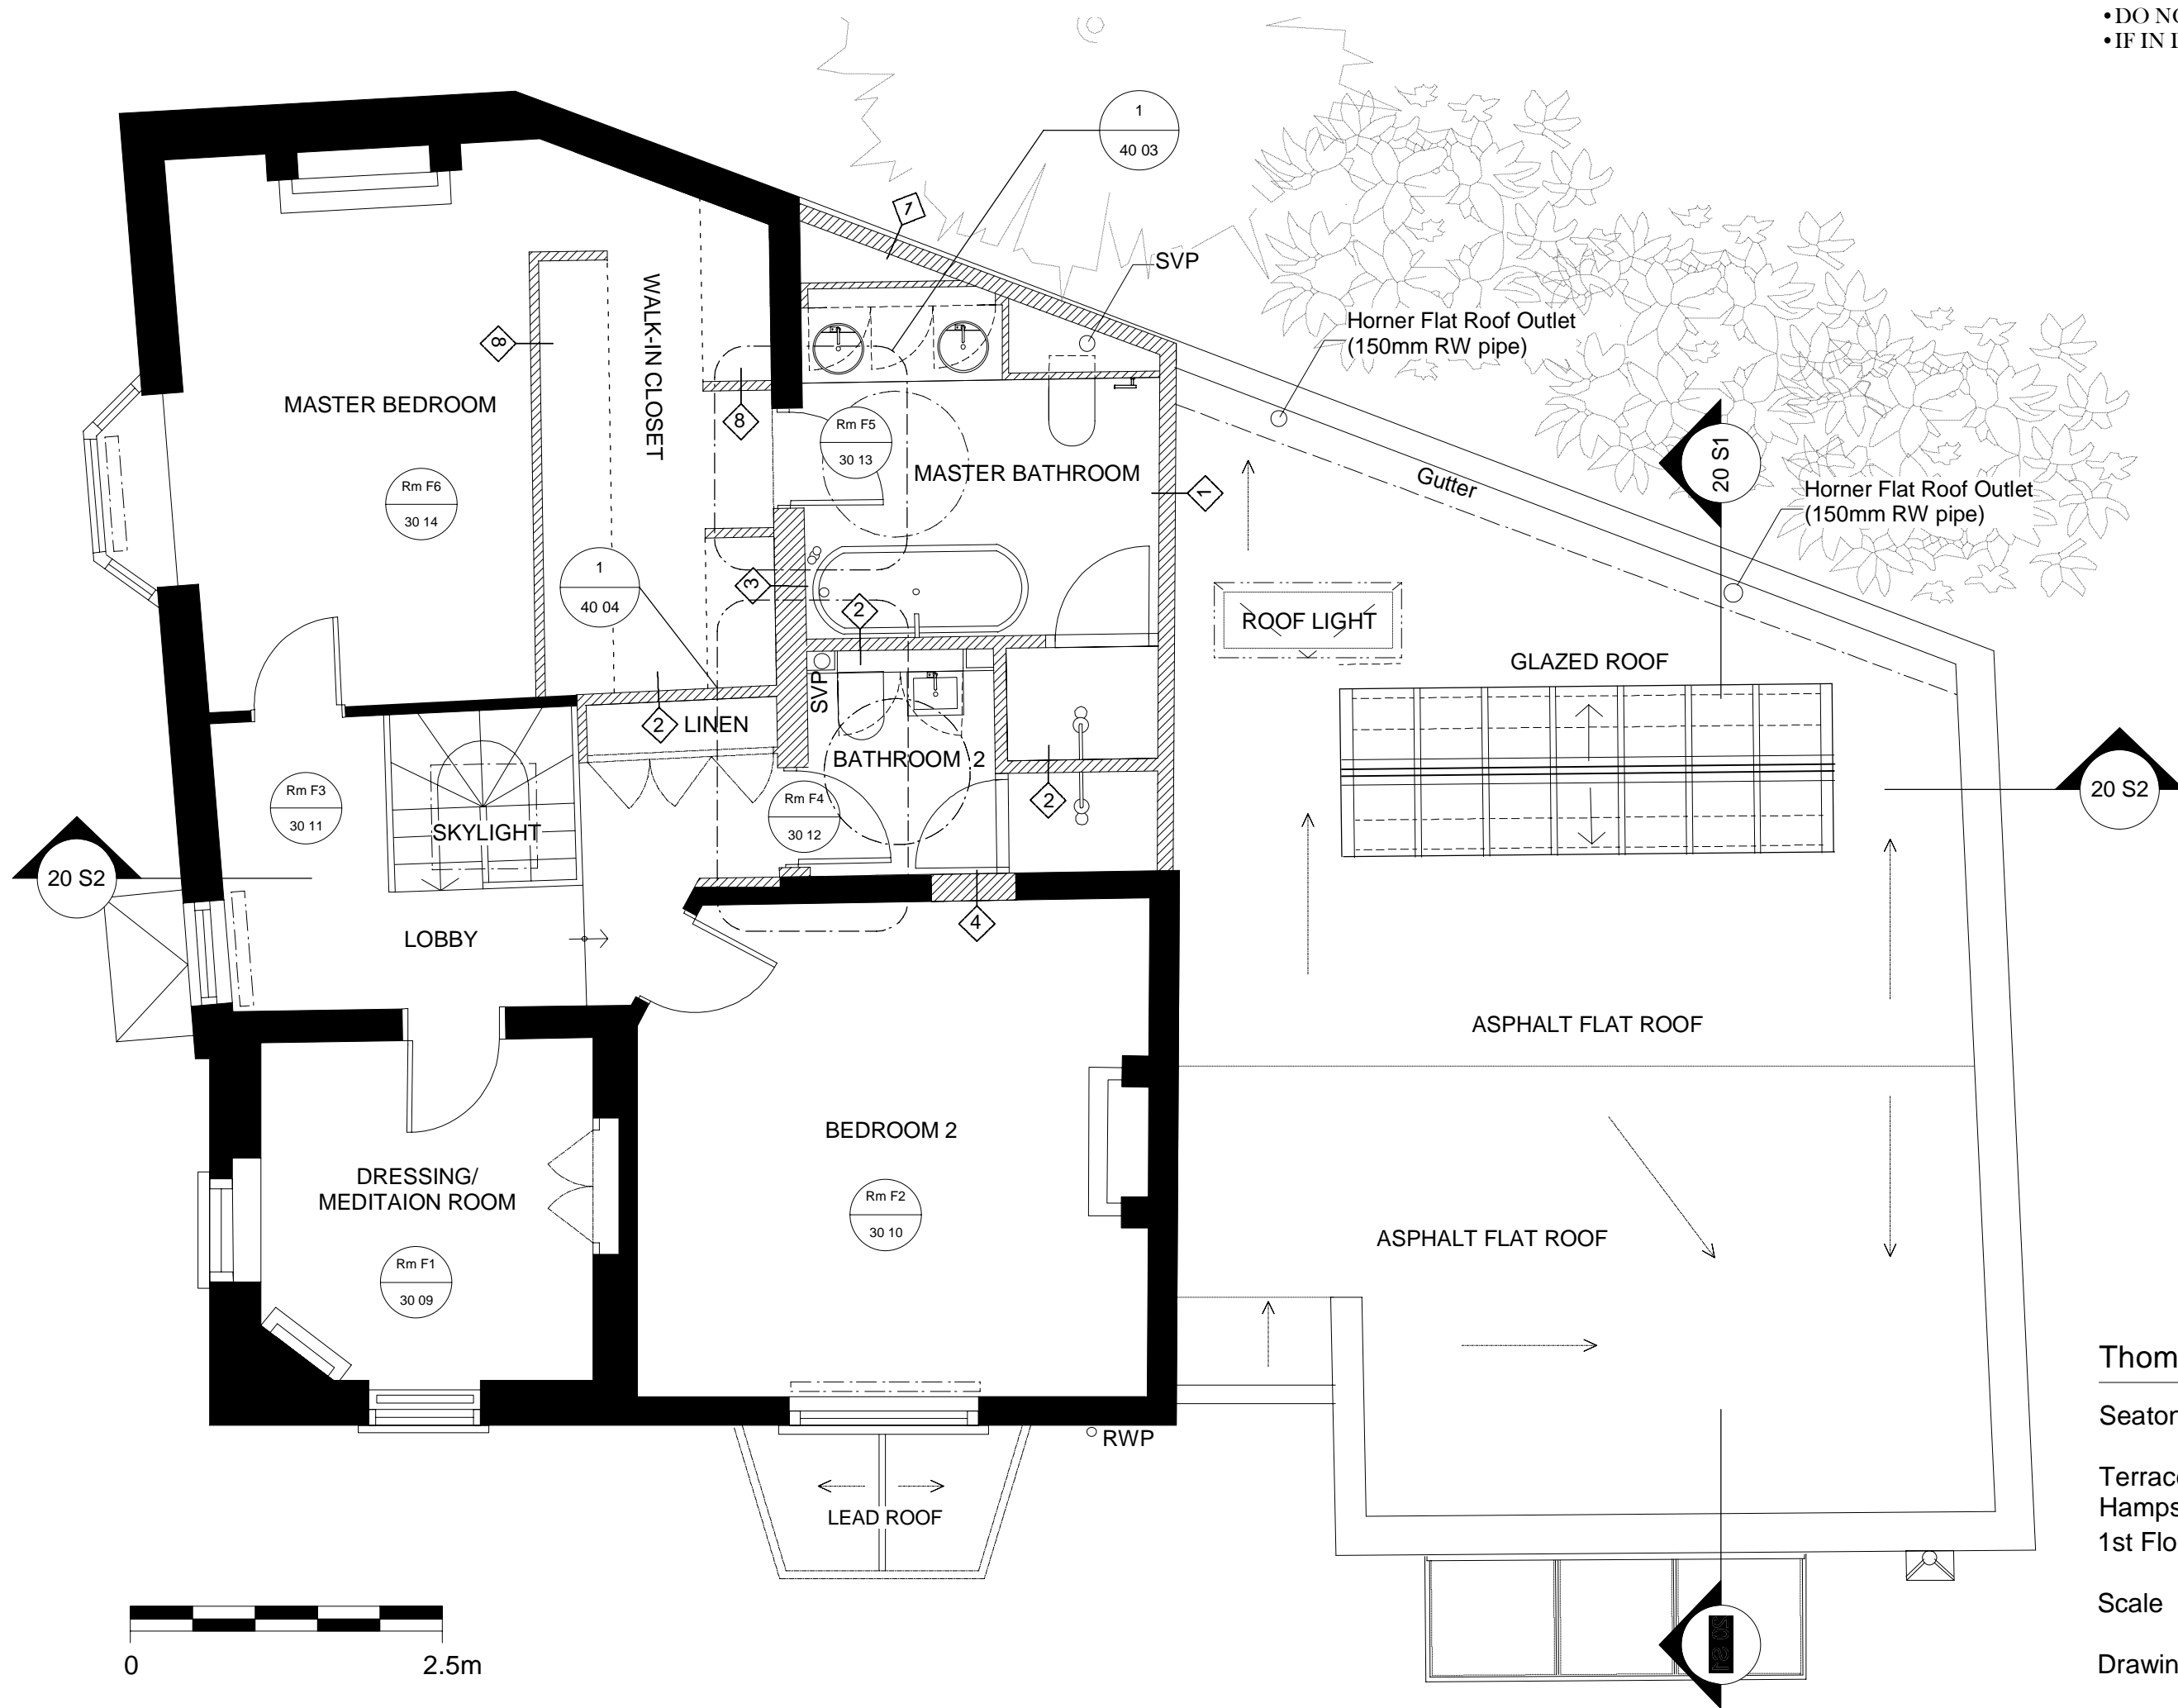

Thomas Brent Associates Ltd.

Seaton House

Terrace Lodge, Admirals Walk,  
 Hampstead, NW3  
 1st Floor - EXISTING / AS BUILT

Scale 1:50 @ A3

Drawing Number 20 03A