


• DO NOT MEASURE FROM DRAWING  
• IF IN DOUBT ASK

KEY

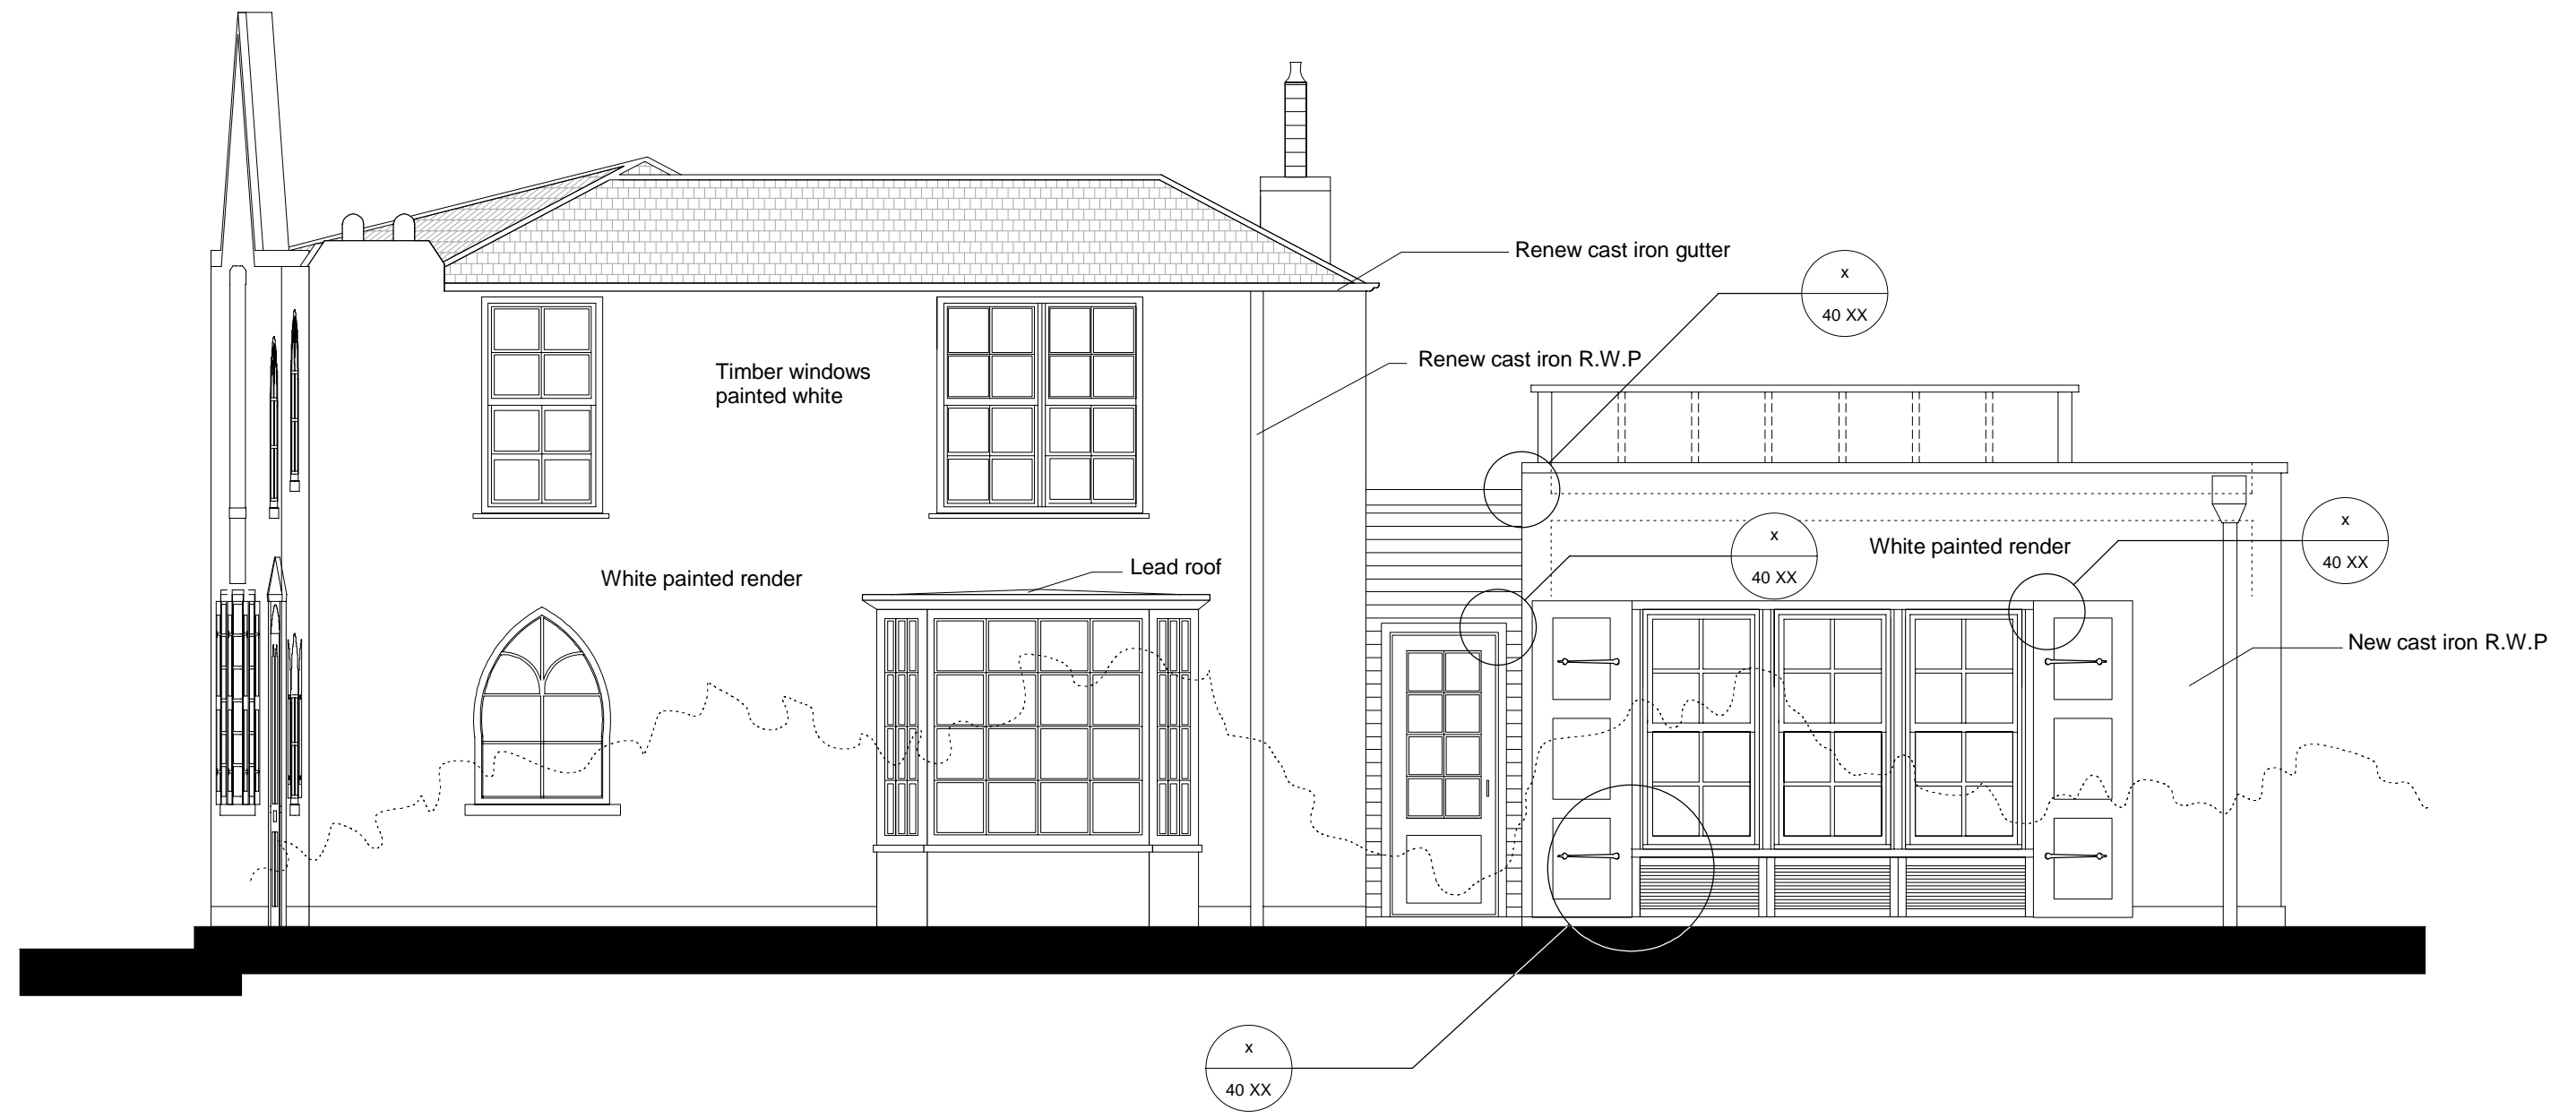

Thomas Brent Associates Ltd.

Seaton House

Terrace Lodge, Admirals Walk,  
Hampstead, NW3  
South Elevation - EXISTING / AS BUILT

Scale 1:50 @ A3

Drawing Number 20 E3 A