



Notes

1. Smoke Outlet From Basement.
2. Sign.
3. Bollard.
4. Bike Stand.
5. Lamp Post.

Furniture legend

 Pret outdoor seating: 8no. External aluminium frame (black) and teak slatted chair

 square tables: 2no. External 500x500mm black Trespa 12mm thick table top with aluminium base


note: external furniture to be brought into store outside of trading hours



exterior chairs and tables:



seating barriers:

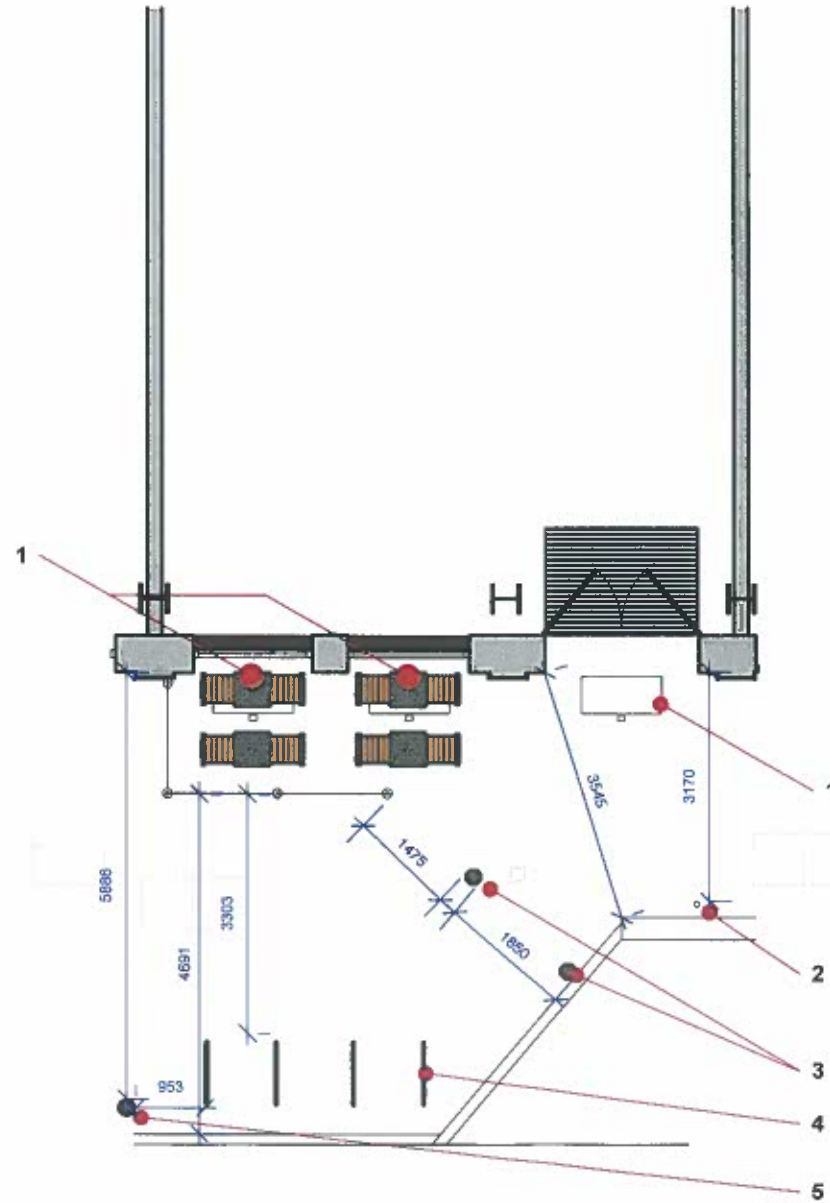

As Built

★ PRET A MANGER ★
1 Hudson Place, London, SW1V 1PZ

Site:
125 High Holborn

Page Title:
External furniture layout

Revision Note:
A: More Dimension added

Drawing No. HHB-Pret-01

Revised Date: 07.02.15 Revised No. A

Drawn Date: 19.12.14 Drawn By: FS

Scale: 1:100 @ A3

THIS DRAWING IS NOT TO BE SCALED
Figured dimensions only to be used. This drawing is subject to and protected by the provision of the copyright acts. Any discrepancies or queries to be notified immediately. All dimensions to be verified on site

© PRET A MANGER (EUROPE) LTD 2004