



4th FLOOR PLAN

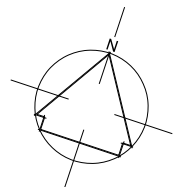


NOTE:

The application only relates to fourth floor and above (no changes to floors below).

The existing roof is retained/in-tact and there is no loss of historic fabric.

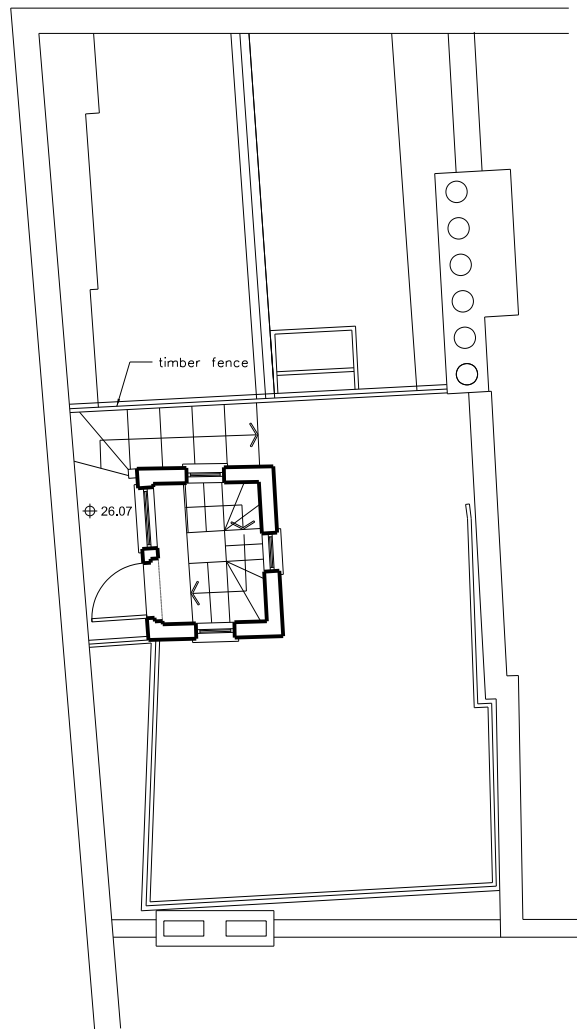


ROOF ACCESS PLAN

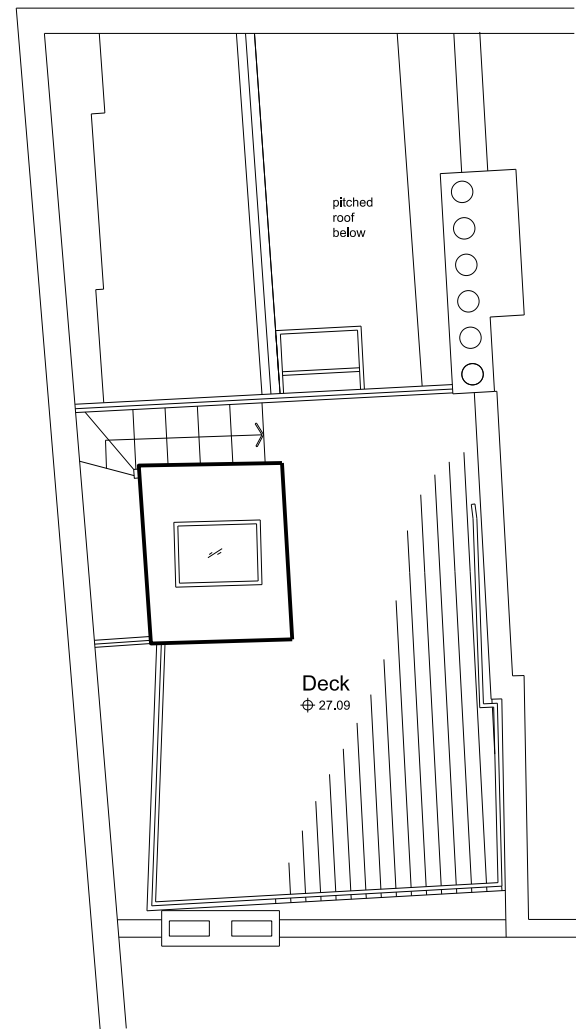

ROOF PLAN

NOTES	
1. Do not scale.	
2. Contractors to check dimensions of all Issued drawings on site.	
3. This drawing is copyright.	
Revised	Date

Drawing Status PLANNING	Client PAUL BENTALL Project 207 HIGH HOLBORN, LONDON WC1V 7BW	
Drawing Title EXISTING (AS BUILT) PLANS	Architecture & Design Battersea Studios 80 Silverthorne Road London SW8 3HE +44 (0)20 7436 4050 architecture@tectus.co.uk www.tectus.co.uk 	
Drawing No 1443 EX 001		Rev. -
Date OCTOBER 2015		Drawn
Scale 1:50 @ A1 / 1:100 @ A3		Checked