


ROOF ACCESS PLAN

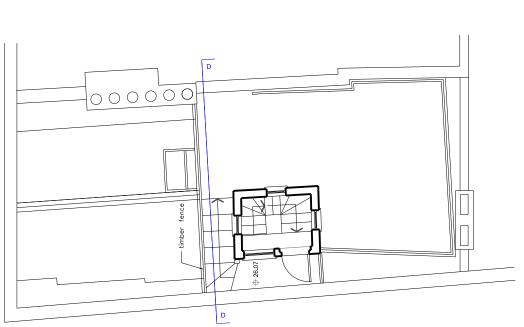

NOTES	
 Do not scale. Contractors to check dimensions of all issued drawings on site. This drawing is copyright. 	
Revision	Date

NOTE:

The application only relates to fourth floor and above (no changes to floors below).

The existing roof is retained/in-tact and there is no loss of historic fabric.

	EXISTING TIMBER FENCING & POSTS	
	EXISTING STRUCTURE	
EXISTING TIMBER TERRACE		
	EXISTING TIMBER STEPS	

SECTION DD - THROUGH NEWTON STREET

Drawing Status PLANNING		Client PAUL BENTALL Project 207 HIGH HOLBORN, LONDON WC1V 7BW	
Drawing Title EXISTING (AS BUILT) STREET SECTION		Architecture & Design	
Drawing No 1443 EX 004	Rev	Battel sed Studios 80 Silverthome Road London SW8 3HE +44 (0)20 7436 4050 architecture@lectus.co.uk www.tectus.co.uk	
Date OCTOBER 2015	Drawn	tectus	
Scale 1:50 @ A1 / 1:100 @ A3	Checked	า เยเนร	