

Drawn by: [blank] Date: [blank]

Notes

This drawing represents a performance guide upon which the contractor/subcontractor must base their working drawings & details. Include all necessary tolerances & details to manufacture and installation.

Contractor to must undertake a full survey of the area to establish all dimensions & ensure accurate set out.

Advise on suitability of all details shown to ensure structure stability, ease and economy of construction. Refer to digital master artwork in regard to all graphic work shown.

AS BUILT

bedrock

Bedrock Design Consultants Ltd
Adrian Gillingham, 1 Bedrock Way, 1st Floor, 1000
1 020 7713 0000
info@bedrockdesign.co.uk
john@bedrockdesign.co.uk

Client: Caffe Nero

Project: Hampstead - refurb

Preparation:

Merchandise: G.A

Scale: 1/50


Drawn by: JB

Date: 30/10/14

Revision:

Revision 1: CND094/001

This drawing is the copyright of Bedrock Design Consultants Ltd. It is to be used for the project only and is not to be reproduced or used for any other project without the written permission of Bedrock Design Consultants Ltd.

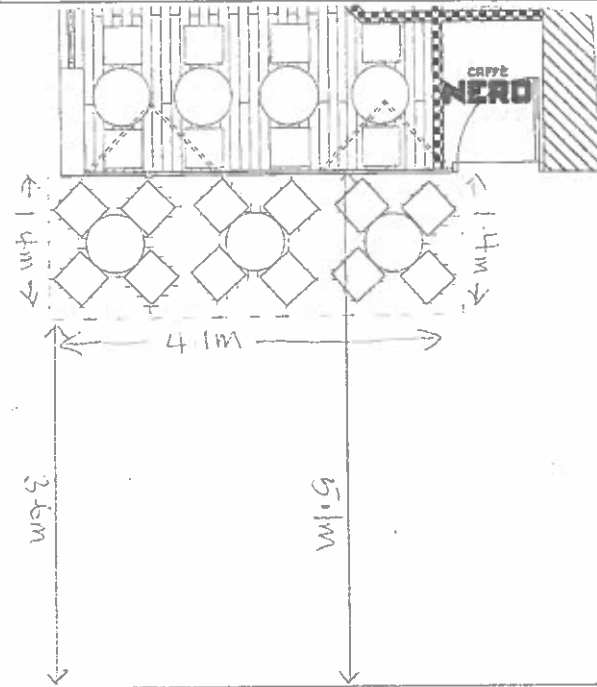

WIGS EDGE