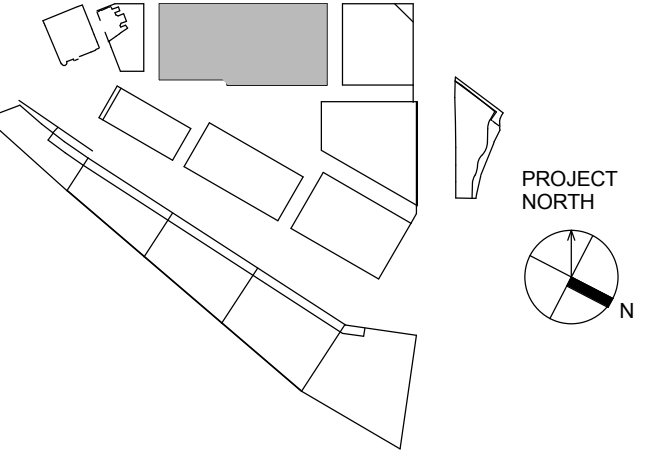


[illegible]

4	Record Set	19 Dec 2014
5	Stage F Updates	06 Aug 2014
2	Stage F Updates	20 Jun 2014
1	Stage F Updates	11 Jun 2014
5	Stage F Updates	31 Mar 2014
9	Stage F Updates	11 Mar 2014
3	Stage F Updates	08 Jan 2014
7	Stage F Updates	20 Dec 2013
3	Stage F	31 May 2013
5	Stage F Progress Issue	02 Apr 2013
3	50% Stage F Issue	10 Dec 2012
3	EA1005	20 Sept 2012
2	Issued for Stage E Updates	25 Jun 2012
3	Issued for Stage E	28 May 2012
3	Issued for Stage F Frozen Backgrounds	27 Apr 2012
10	50% Stage E Issue	30 Mar 2012
3	Issued to Building Control	13 Mar 2012
3	Issued for Contract Addendum	24 Jan 2012
3	Issued for Final Contractor Information	28 Oct 2011
	ISSUED	DATE

REVISIONS

DRAWING STATUS

RECORD SET

Discrepancies must be reported immediately to the Architect before proceeding. Only figured dimensions are to be used. Contractors must check all dimensions on site. This drawing is protected by copyright.

ALL DIMENSIONS ARE SHOWN IN METRIC.

CONSULTANTS

Design Architect
Wilmutte UK Ltd
33 Oxford Gardens,
London, W10 6NE

Executive Architect
Adamson Associates (International) Ltd
11th Floor, One Canada Square,
London, E14 5AB

Structural Engineer
AKT
100 St John Street,
London, EC1M 4EH

M&E
Hoare Lea
Glen House, 200-208 Tottenham Court Road
London, W1T 7PL

Quantity Surveyor
Gleeds
35 New Cavendish St
London, W1W 6XF

Fire Consultant
RECOM
Recom House, 63-77 Victoria Street,
St Albans, Hertfordshire,
AL1 3ER



DRAWING TITLE

GENERAL ARRANGEMENT PLAN LEVEL 1

RAWN Author	CHECKED FHB
SCALE @ A0 1 : 100	DATE 14 JUN 2011

PROJECT NO. 1050-00

DRAWING NO.

A1010

LOCATION B1

REVISION **14**