





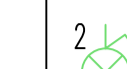


NOTES

1. Refer to Mechanical Contractor Drawings for Plant Modifications.

LEGEND

-  TWIN SWITCHED SOCKET OUTLET
-  13A SWITCHED FUSED CONNECTION UNIT
-  PANIC ALARM BUTTON
-  PANIC ALARM SOUNDER
-  INTRUDER PIR NEW LOCATION
-  TWIN DATA OUTLET

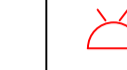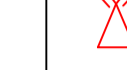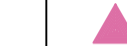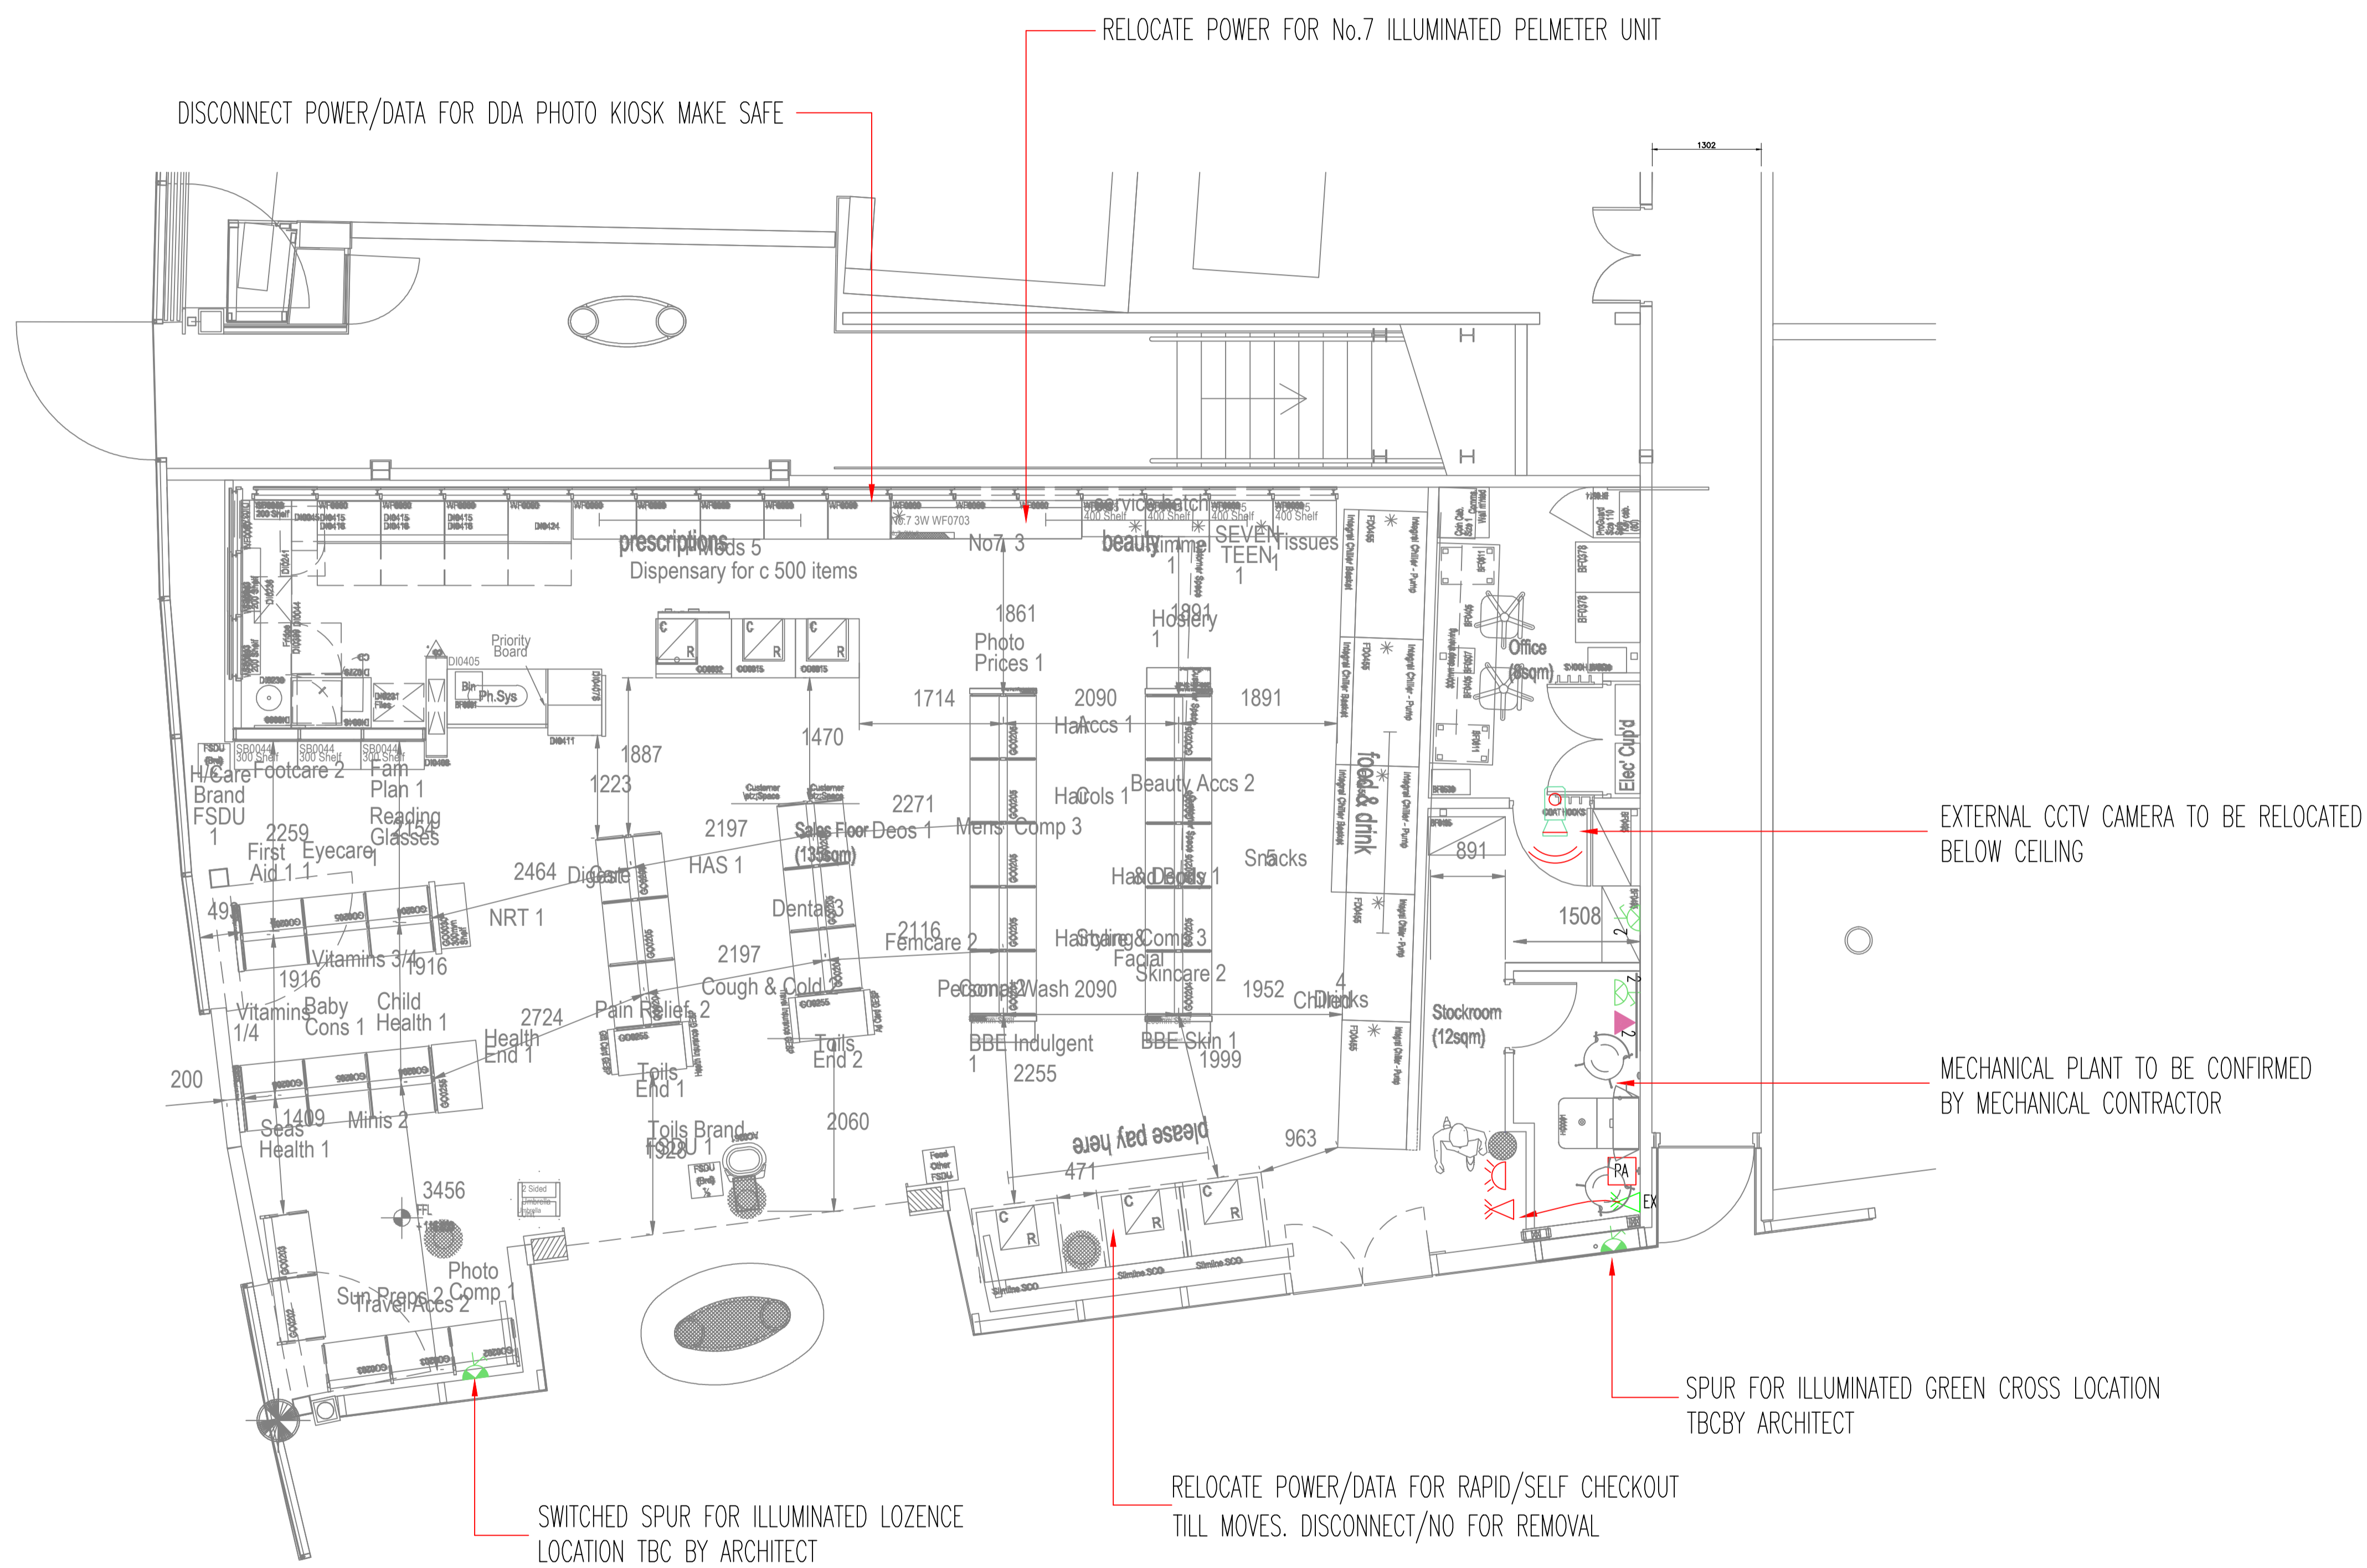

1	SEP.15	AS INSTALLED
Rev.	Date:	Description:

J.M.SCULLY Ltd

J M Scully Ltd
10, Wimborne Road,
Walford, Wimborne,
Dorset, BH21 1NN
Tel: 01202 843700
Fax: 01202 843727

Project:
**BOOTS STORE 1126
GROUND FLOOR
KINGS CROSS STATION**

Drawing Title:
**GROUND FLOOR
SMALL POWER & DATA MODS.
INTERVENTION 2015**

Scale: 1:50 @ A1 Date: 21.08.15

Drawn: JMS-TH Checked: JMS-CS

Drawing Status: FOR APPROVAL Revision: 0

Drawing No. JMS-1126-302