




BLOCK PLAN ~ 1:200

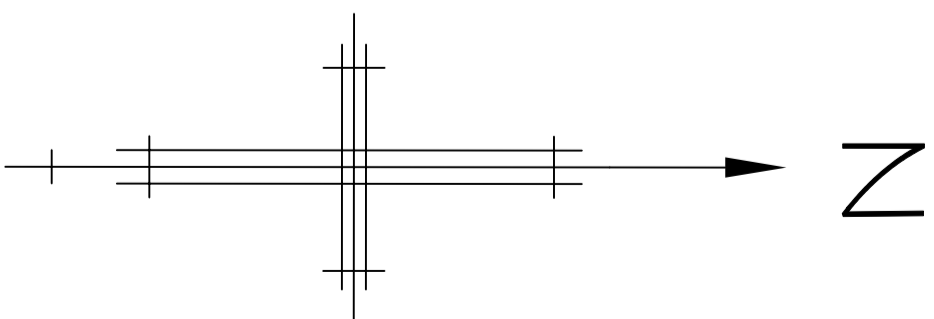

REV B - Ground floor depth reinstated as built
 REV A - Entire rear wall moved forwards 940mm
 REVISIONS
 14/02/2014
 13/02/2014
 DATE

Architectural
 Design & Planning

32 Grange Road
 Plymouth PL7 2HY
 t: 01752 341696
 f: 01752 342503

THE DESIGN WORKS

TITLE
 BLOCK PLAN

ADDRESS
 33c MILL LANE
 LONDON NW6 1NZ

CLIENT
 COBSTAR Ltd
 SCALE 1:200
 DATE FEBRUARY 2013
 DRAWING No. 121214/P/04
 REV. B