

DEMO LEGEND

Symbols shown are not to scale
some symbols may not appear on the layout plan

WALL STYLES



- Existing structural wall
- Existing internal partition
- Demolished Partition
- Demolished Window Module
- Demolished Silicon Glass
- Demolished Single Door
- Demolished Hospital Door
- Demolished Double Door



Proposal to RELOCATE EXISTING fan coil unit



Proposal to RELOCATE EXISTING fan coil units

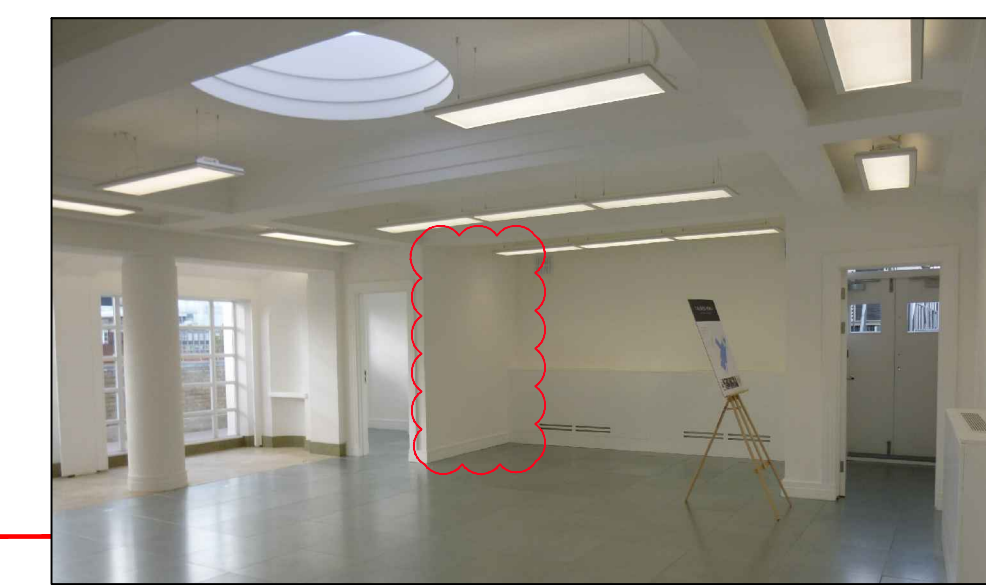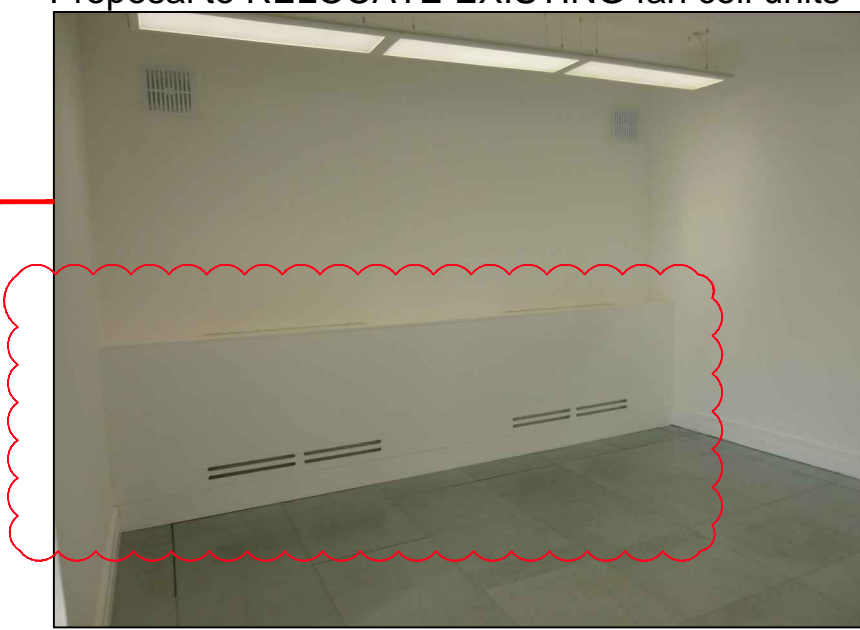

Proposal to DEMOLISH EXISTING partition



Proposal to BLOCK EXISTING Door

A	Drawing first produced	IK	08.12.15
Rev	Descriptive amendments	Drawn by	Date

Pre-Design - Construction - As Built
PRE DESIGN

Client
The Quarry

Client Contact
Site Address
**The Heals Building
1 ALFRED MEWS
W1T 7AA London**

Drawing Title
DEMOLITION LAYOUT
Account Manager
Craig Smith
Designer/ Project Manager
Lara Cohen

Scale	Drawn by	First Drawing Date		
1:100@A1	IK	08/12/15		
Contract Number	Building	Floor	Detail	Revision
55774	01	05	DEMO	A



Laser House
132-140 Goswell Road
London EC1V 7DY
T: +44 (0)20 7553 9500
F: +44 (0)20 7553 9501
www.oktra.co.uk

NOTES: This drawing is the exclusive Copyright of Oktra and may not be copied or handed to any Third parties without prior consent. All dimensions must be checked on site and not scaled from the drawing. All drawings and proposals are subject to approvals by statutory authorities