
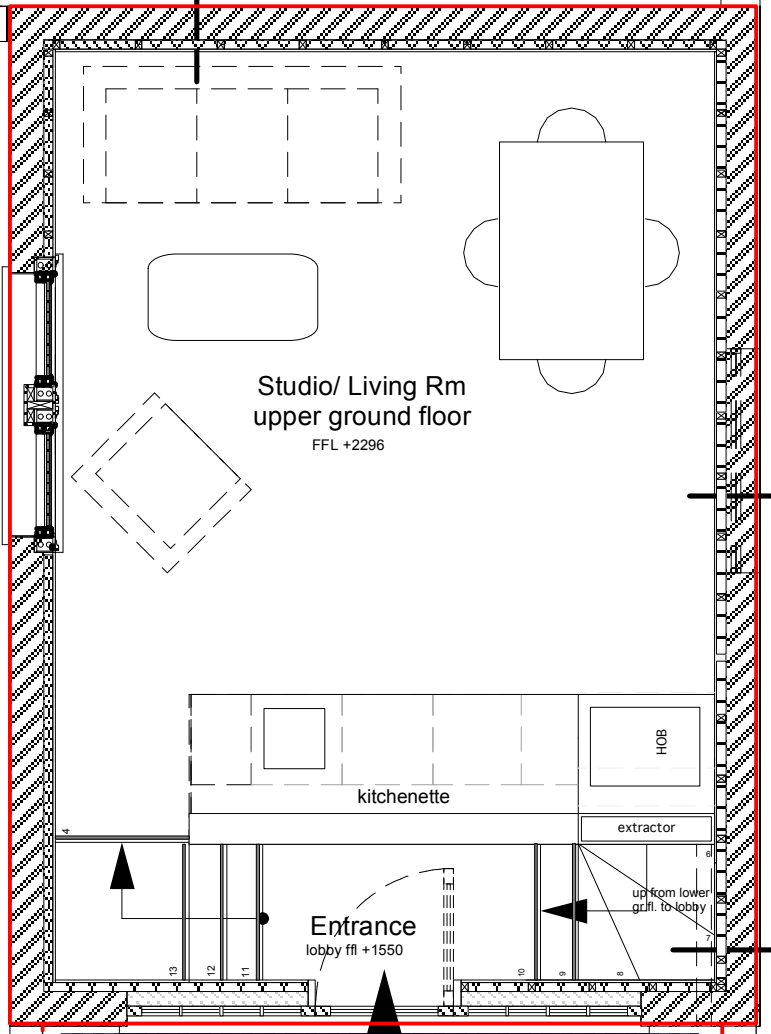


1 REGENTS PARK TERRACE
existing upper ground floor

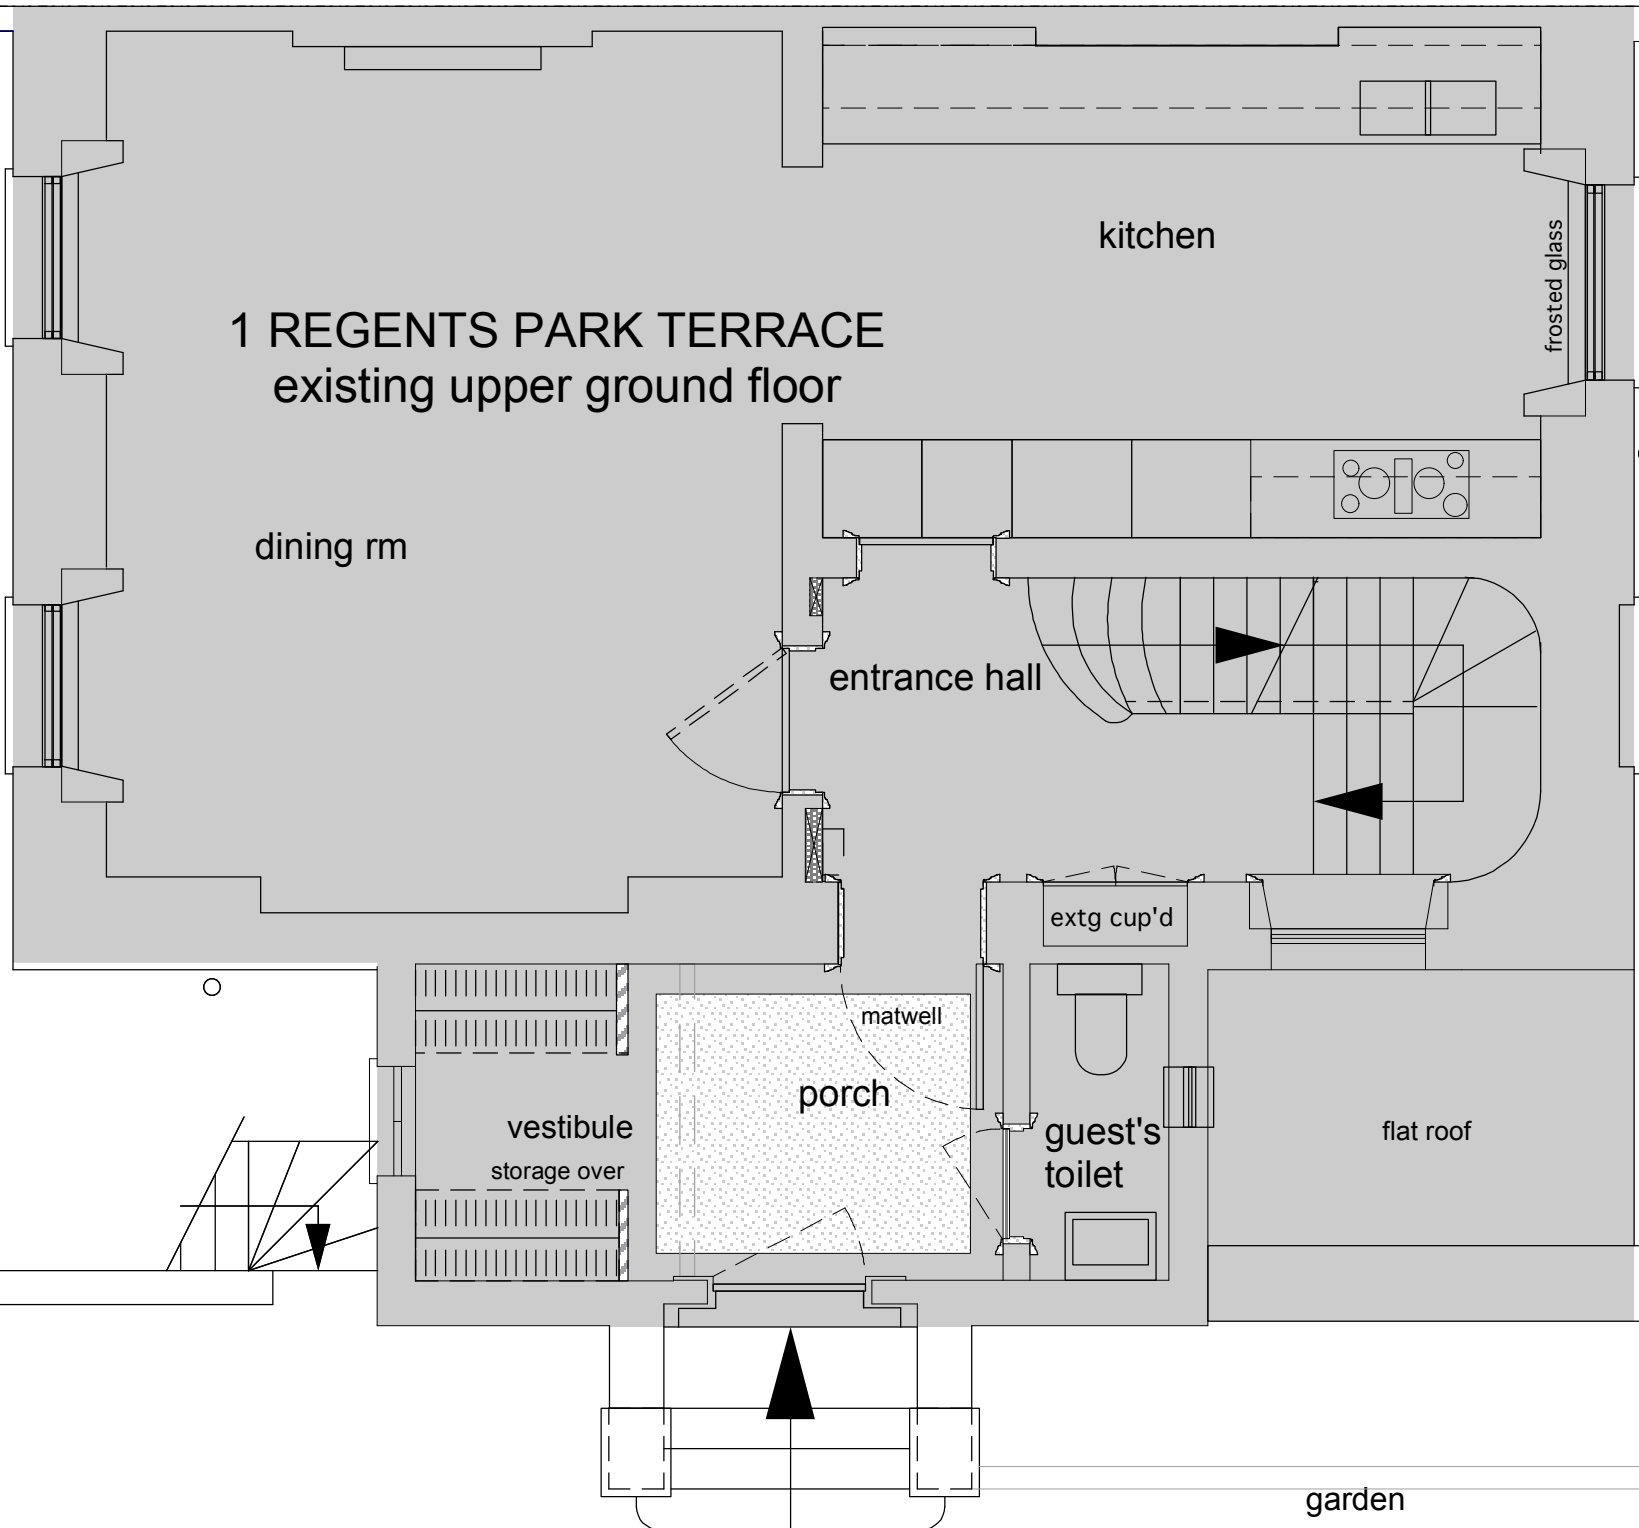

OFF STREET
PRIVATE PARKING

No	revisions	date
e	Change of Use Planning Submission	19/12/2015
d	Scale added	17/12/13
c	Section d - d indicated	12/12/13
b	Studio redesigned extg garage doors relocated	16/10/13
a	Final scheme	12/06/13

- project title
1 Rengent's Park Terrace
London NW1 7EE

- drawing title
Upper Ground Floor Plan
as built

- client
Dr K. A. Miszkjel

- scale
1 : 50 @ A3

date
20May:13

drwg no : 1107 - 613 - 02

miltiadou design associates ltd
27 Wyatt Road, Highbury, London N5 2JU
t: +44(0)20 7704 0299 & (0)7873 314 733
e: msmda@blueyonder.co.uk

notes :
* all dimensions must be checked on site
* inform miltiadou design of any discrepancies prior to construction.
* the drawing and any details therein remain the copyright of miltiadou design associates ltd

