



PLANNING DRAWINGS


SCALE: 1:50 @A1

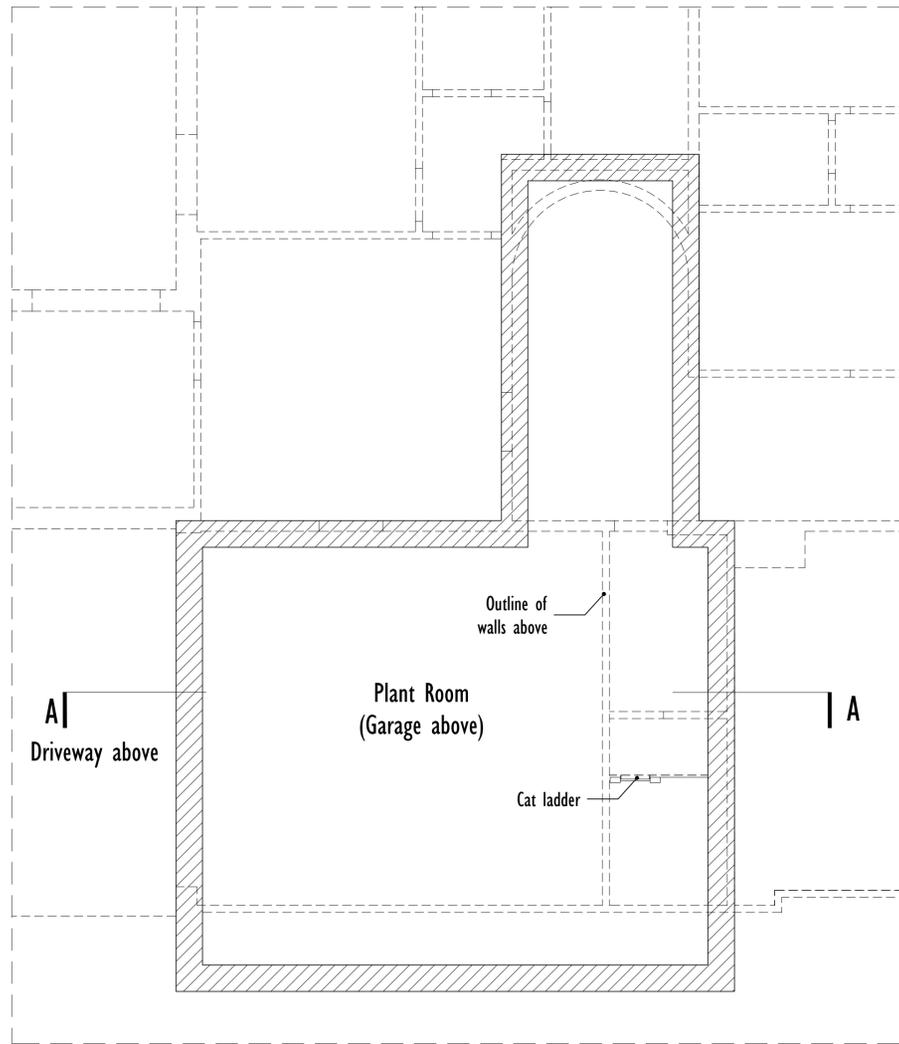

AS BUILT BASEMENT FLOOR

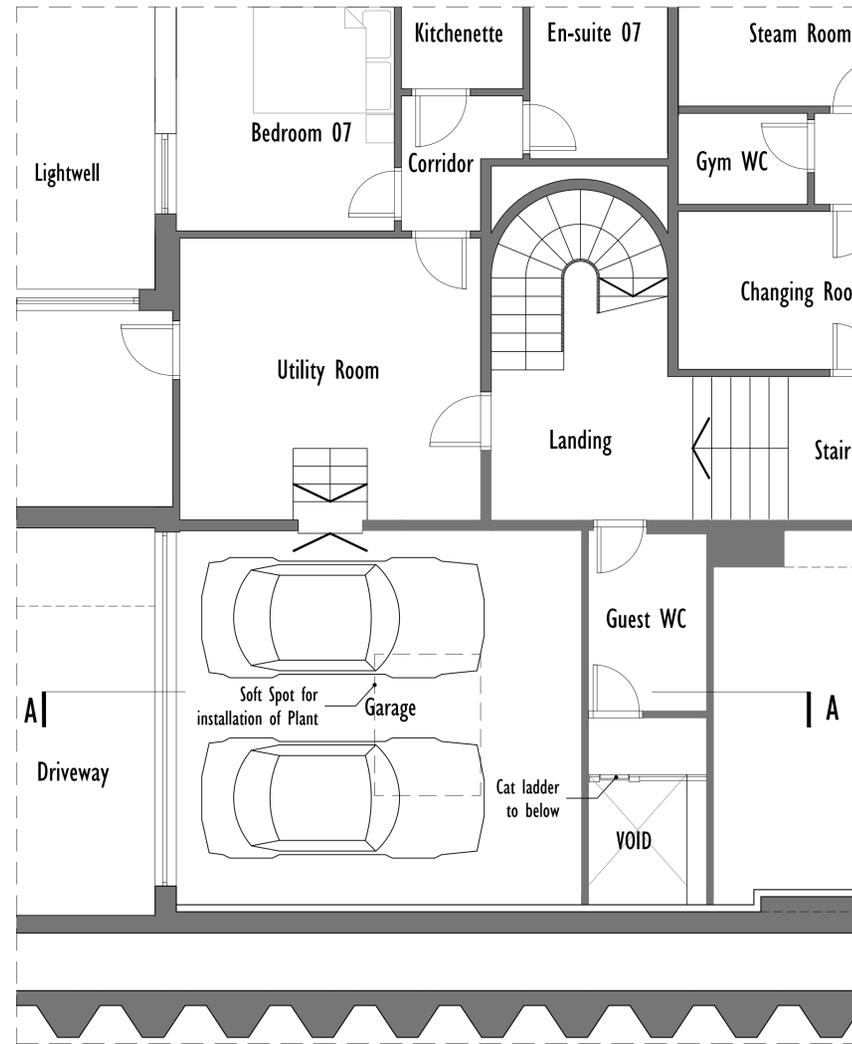

AS BUILT LOWER GROUND FLOOR

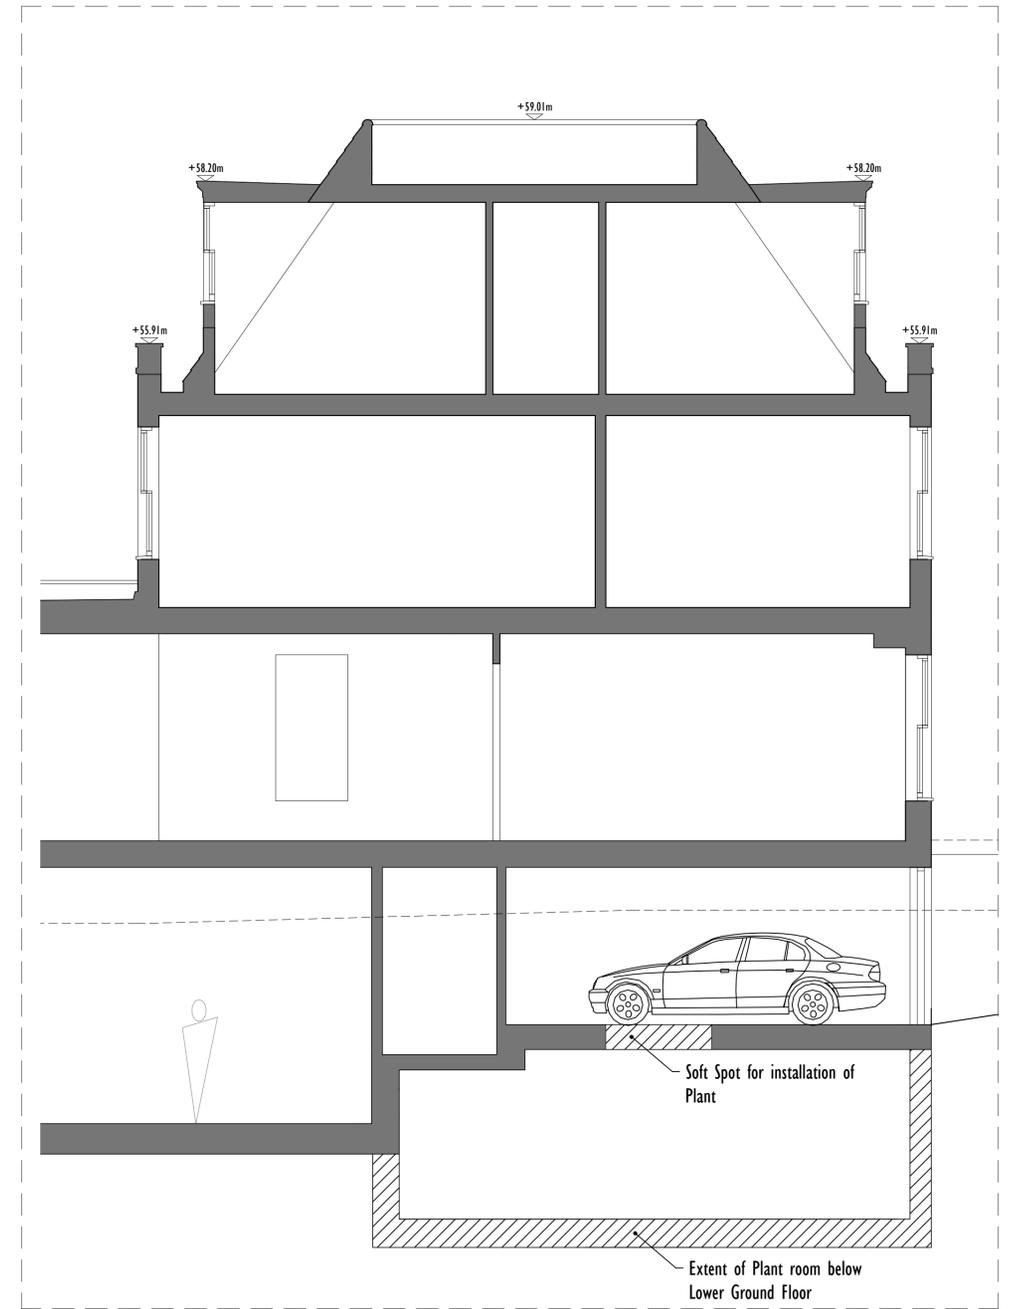

AS BUILT SECTION A - A



w o l f f
ARCHITECTS

16 lambton place
notting hill
london w11 2sh
t e l 0 2 0 7 2 2 9 3 1 2 5
f a x 0 2 0 7 2 2 9 3 2 5 7
i n f o @ w o l f f a r c h i t e c t s . c o . u k

NOTES:
This drawing is protected under Copyright and at no time should any portion of this drawing be reproduced or copied without the permission of the Architect. (Design Copyright Act 1988).
This drawings must not be used for purposes other than that for which it is provided. It is supplied without liability for any errors or omissions.
Do not scale from this drawing, all dimensions to be checked on site. All drawings subject to Statutory Authority Approval.

no: 0
rev: A
First Issue
Minor Amendments

date: 18.12.15
21.12.15

no:
rev:
date:
date:

status: **PLANNING**

project: 41 Queen's Grove, St Johns Wood, London, NW8 6HH
date: 14.12.15
scale: 1:50 @A1
drawing title: As Built Plans: Lower Ground Floor & Section A-A
dvg no: 0601-PL-591

rev no: A