

H & D PARTNERS

Structural Engineers, Planning & Design

Project

267 Eversholt Street
London NW1 1BA

Element

Extg & Proposed (As-built) of
Garden Boundary Wall to 267/269

Sheet No.


SE/SK-01

Eng.


DCM

Date.


09-01-2016

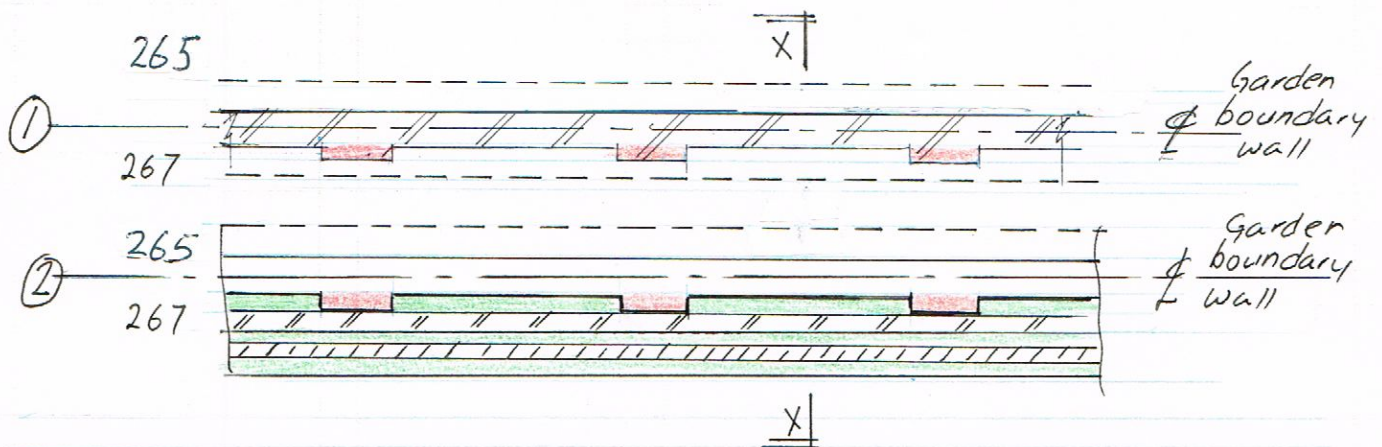

① Existing Condition & ② Proposed Condition.

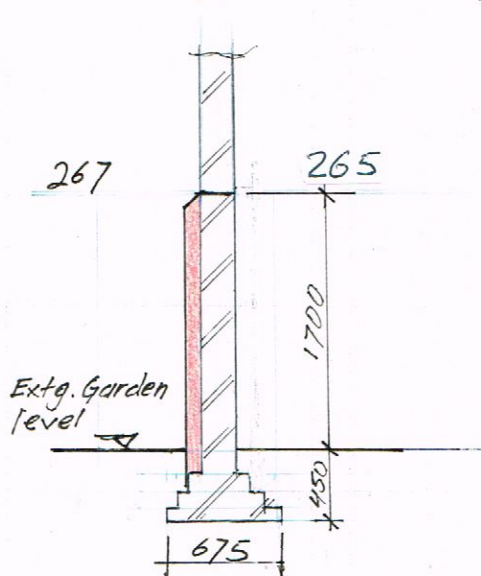

Section X-X (Extg).

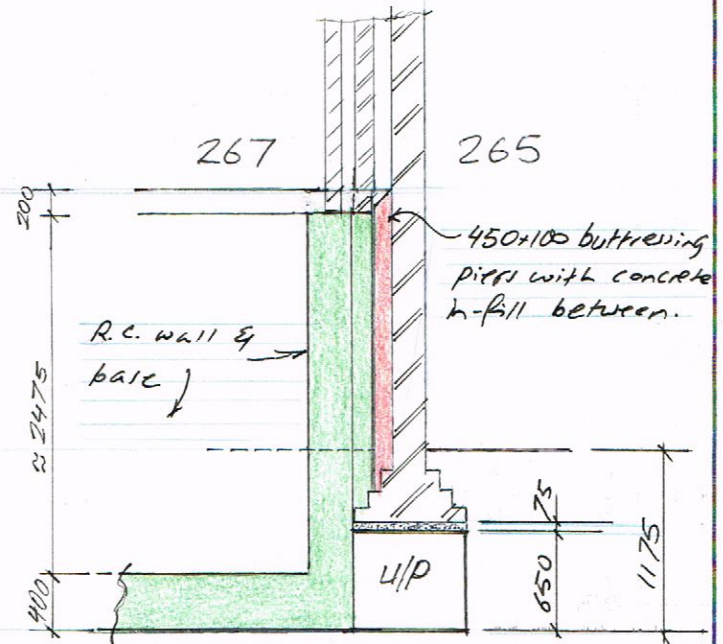

Section X-X (Proposed)

Notes

The above diagrams represent existing & proposed (as-built) works based on information provided by builder/owner, Hasan Yaman. It is retrospective information as required by Local Authority's Planning Department. It will be seen from above diagrams that the boundary walls dividing nos. 267/269 Eversholt St, London, NW1 1BA, were nothing but free-standing brick garden walls at about 1.70m ht. above garden level. For further details/notes see information provided by Architect & elsewhere.