


SECTION B



SECTION C

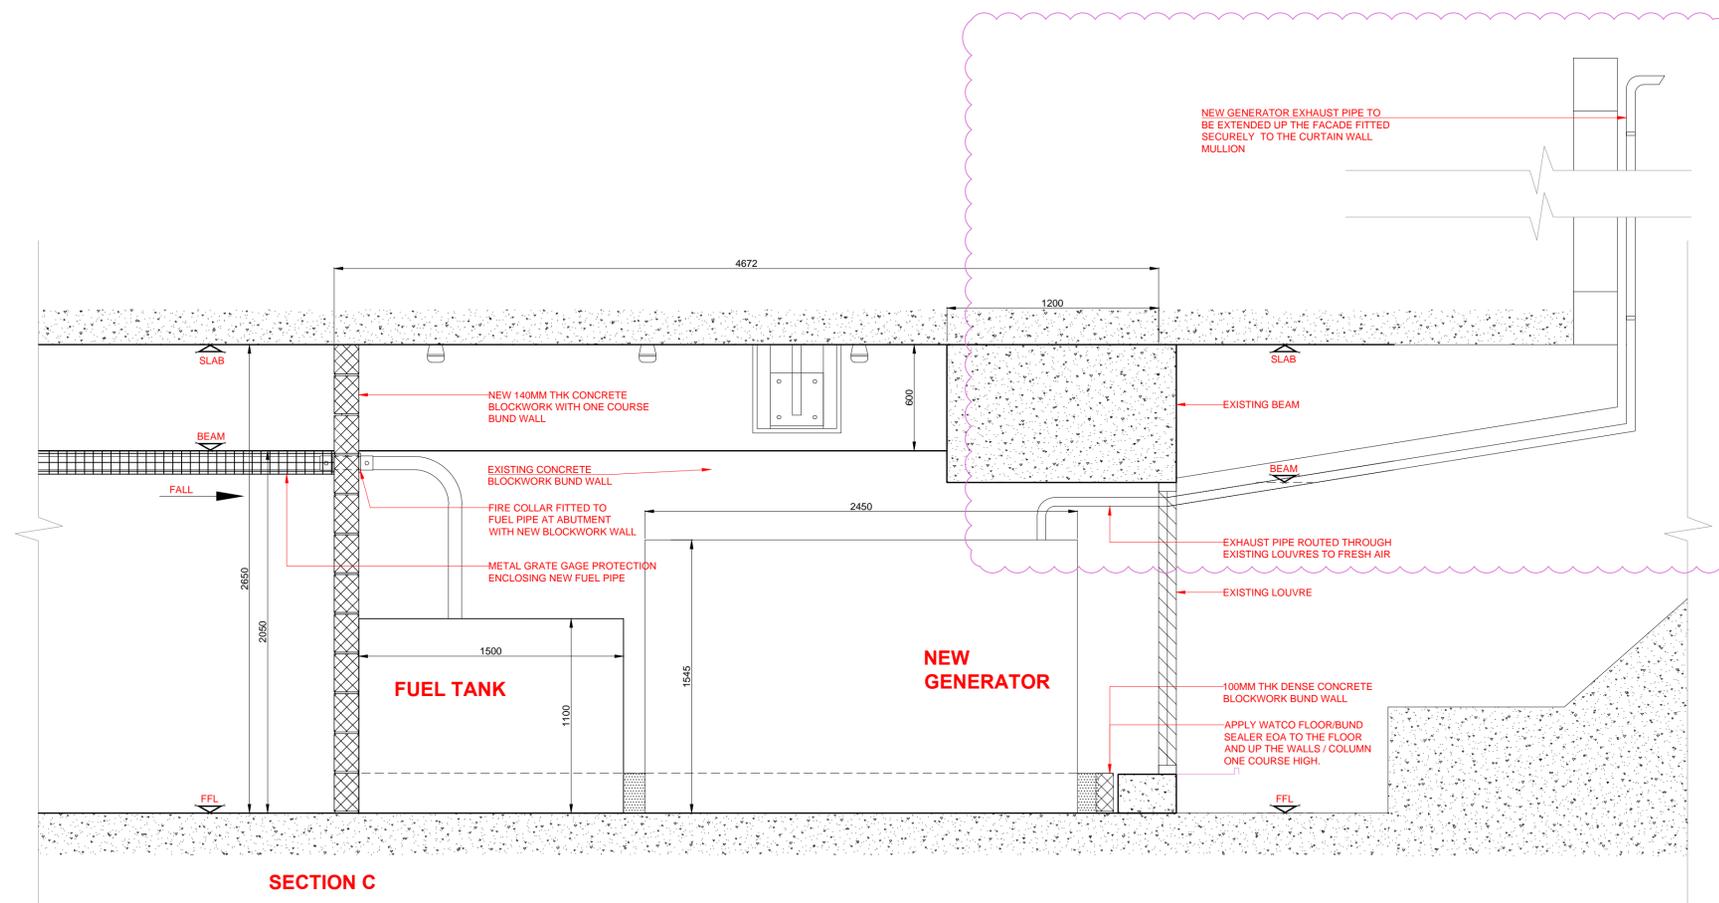

DRAWING STATUS

PRE CONSTRUCTION

PRE CONSTRUCTION / APPROVAL / CONSTRUCTION AS BUILT

Notes: This drawing must be signed otherwise it will be invalid
Building parameters taken from as built drawings provided
Check survey undertaken only, subject to statutory approval
All dimensions shown are in millimetres unless otherwise shown

QUALITY CONTROL

MARIS

CREATED BY: _____

DESIGNED BY: _____

TECHNICAL DIRECTOR: _____

DATE: _____

CLIENT

PROJECT: _____

PROJECT NAME: _____

DATE: _____

REVISION SCHEDULE

NO.	REVISION	DATE
1	Revised to reflect client comments	MH 09/11/2015
2	Drawing first produced	MH 22/10/2015

Descriptive amendments By Date

Ted Baker

Ground Floor - Sections B & C

21250 01 GRD S2 A
Project No Building Floor Detail Rev

Project Address: Site address 1
6A St Pancras Way
London NW1 0TB

Drawing Produced by: MH/TH

Amended Date: 22/10/2015

Scale: 1:20@A1