




AS BUILT ELEVATION OF NO 46.

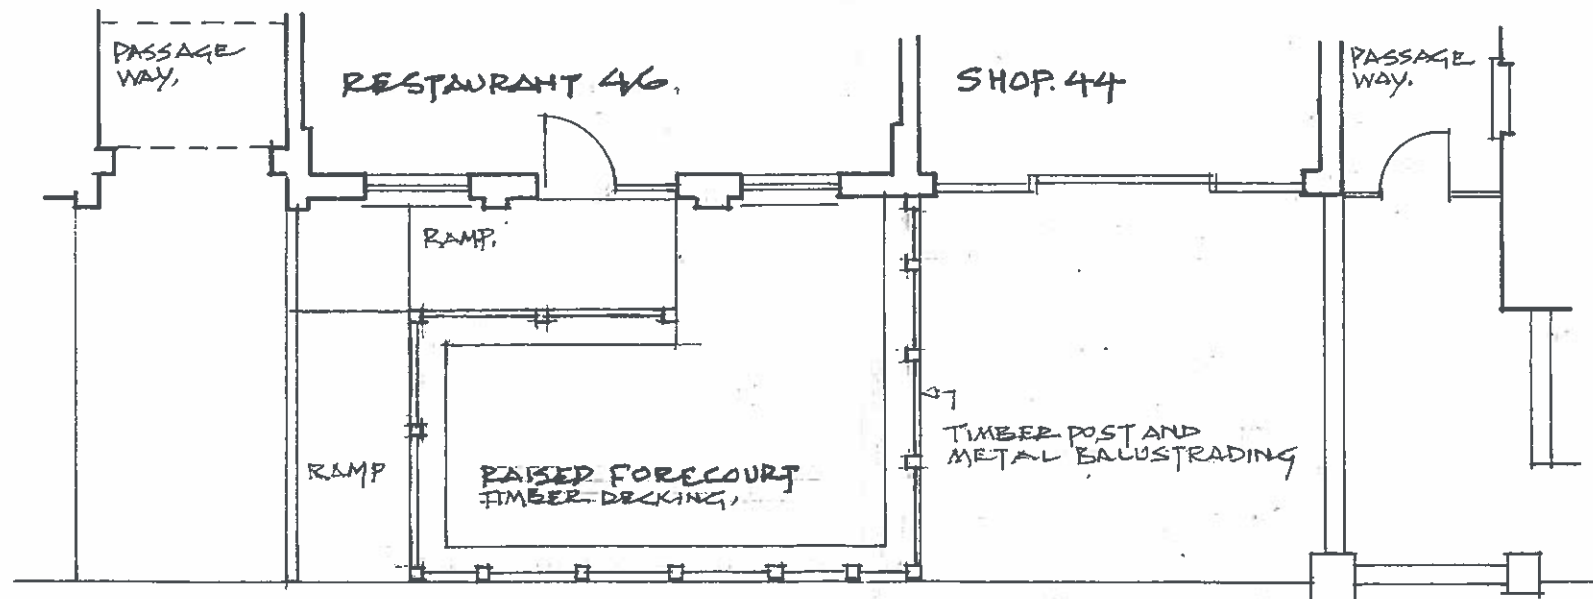

AS BUILT PLAN OF FRONTAGE NO 46

CL45A


NO 46. BIRCHINGTON ROAD
KILBURN. LONDON NW6 4LJ

PLAN AND ELEVATION OF AS BUILT
SHOPFRONT AND FORECOURT.
SCALE 1:100 DATE JANUARY 2016





EXISTING ELEVATION TO NO. 46 & 44.

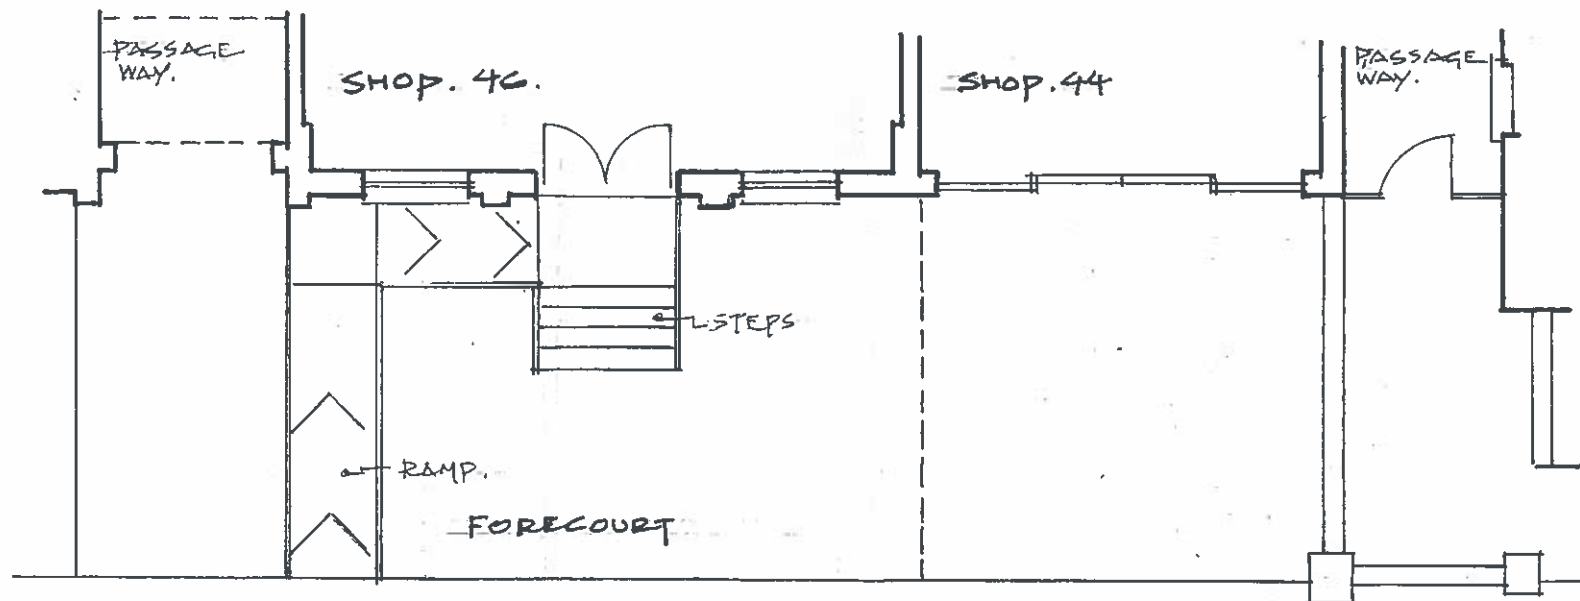

EXISTING PLAN OF FRONTAGE TO NO. 46 & 44

CL45B

NO. 46, BIRCHINGTON ROAD
KILBURN, LONDON, NW6 4LJ

PLAN AND ELEVATION OF EXISTING
SHOPFRONT AND FORECOURT
SCALE: 1:100 DATE: JANUARY 2016.