




AS BUILT ELEVATION OF NO 46.

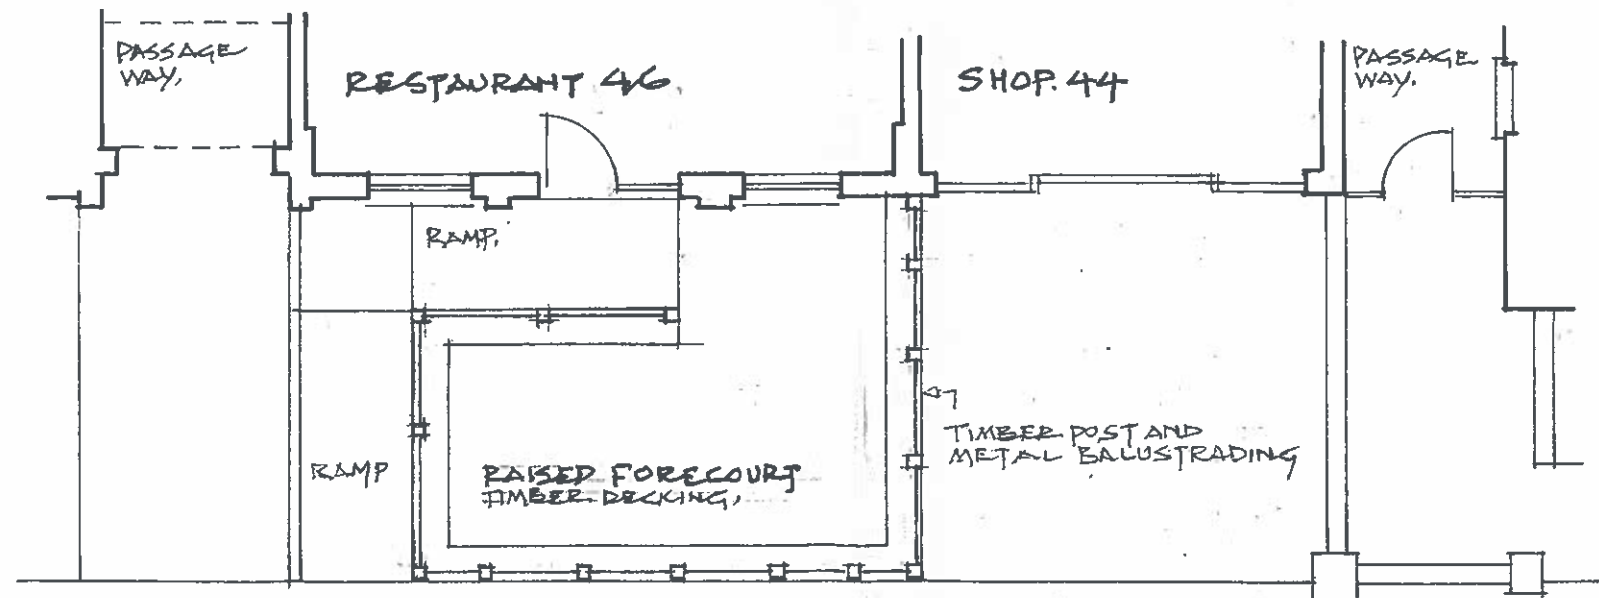

AS BUILT PLAN OF FRONTAGE NO 46

NO 46. BIRCHINGTON ROAD
KILBURN. LONDON NW6 4LJ

PLAN AND ELEVATION OF AS BUILT
SHOPFRONT AND FORECOURT.
SCALE 1:100 DATE JANUARY 2016

