




Proposed Basement Plan
Scale 1:100

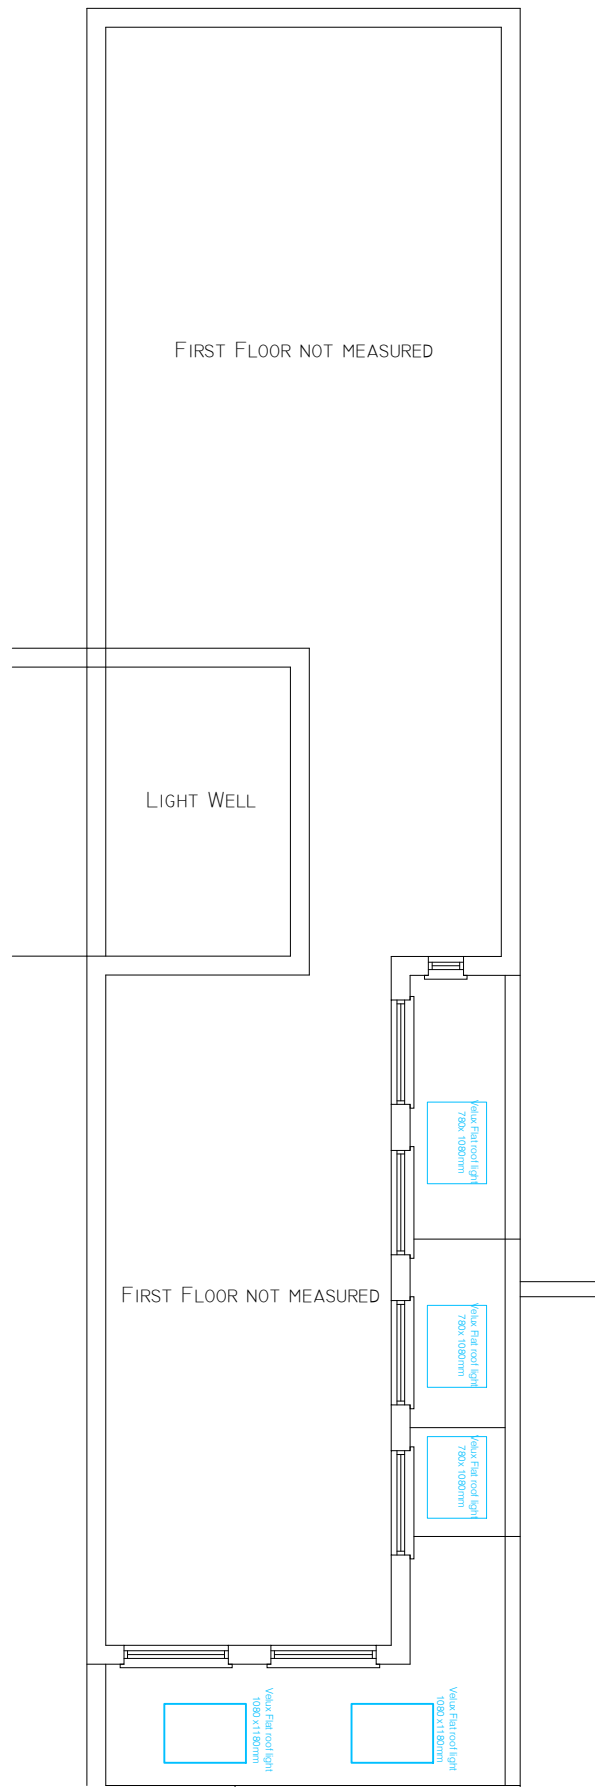

EXISTING FIRST FLOOR PLAN
AS BUILT
SCALE 1:100

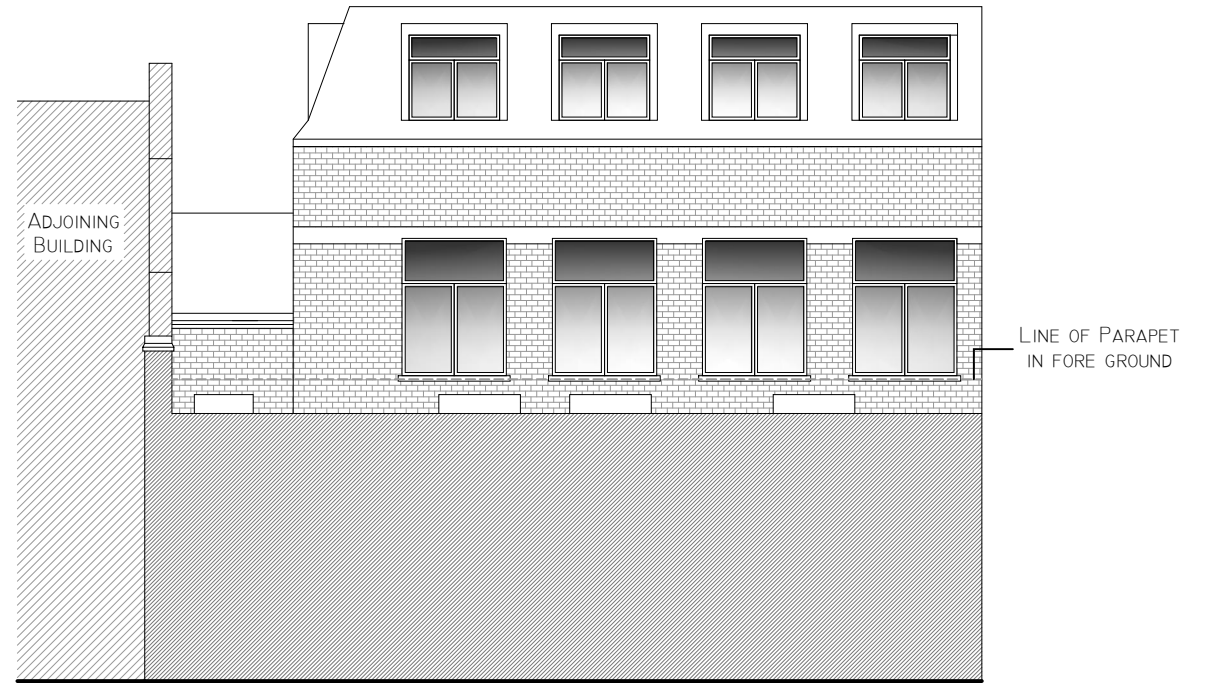


ELEVATION A-A
SCALE 1:100

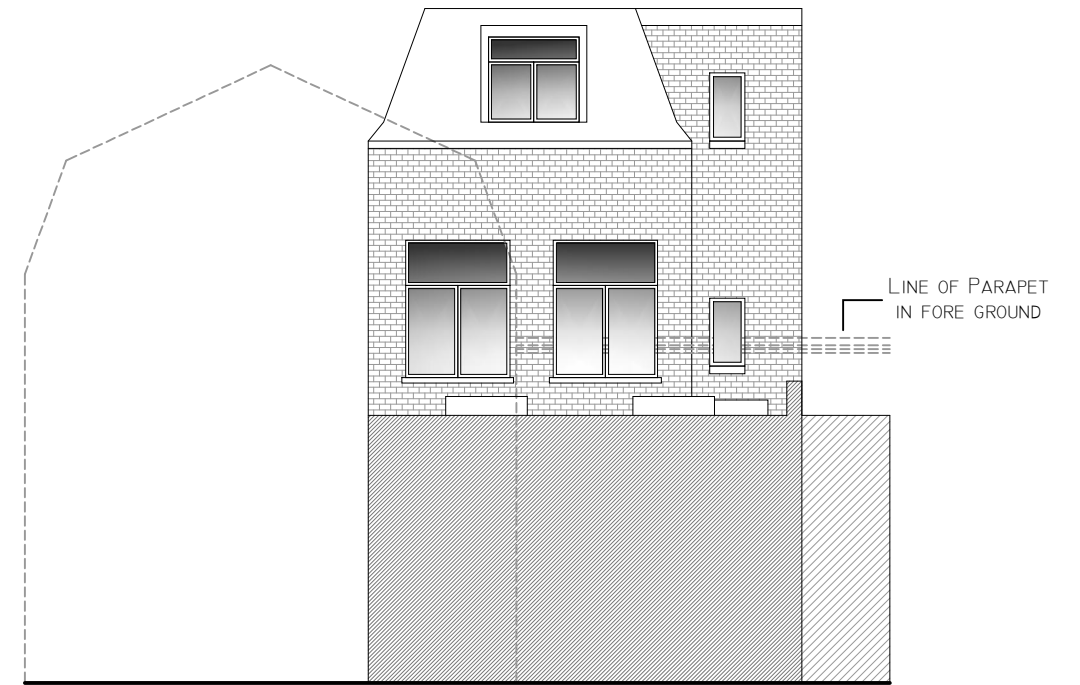

ELEVATION B-B
SCALE 1:100

EXISTING GROUND FLOOR PLAN
AS BUILT
SCALE 1:100

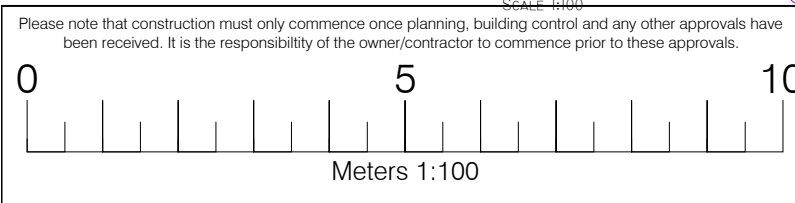

Legend	
Walls Removed	
New Walls	
Existing Walls to Remain	
Roof Structure	
Sound Separating Walls	
Boundary	

IMPORTANT GENERAL NOTE
The specification is to be read in conjunction with the plans/section details, and other associated Structural details as may be provided.
All work is to be carried out to the Local Authority Planning and Building Regulations Approval, and the Codes of Practice and British Standards as necessary.
All dimensions, levels, sizes, positions and locations of particulars as indicated on drawings are to be verified by the appointed Contractor on site prior to engaging in works. Any discrepancies must be reported to the Architect/Surveyor/Engineer or responsible person's immediately.
The Contractor is responsible for ensuring compliance with the CDM Regulations, and appropriate Health & Safety on site precautions.
The Client/Building Owner must obtain any necessary PARTY WALL AGREEMENTS, prior to engaging in the works on site.

Revision	Date	Description

Paper Size
A3

Scale
1:100

Revision
1st

Jan-16

Drawn By/Checked By
HW

Construct 360 Ltd. Trading as:
DontMoveExtend®
info@construct360.co.uk
Tel: 0208 206 0011
Site Address
19 St. Cross Street,
Hatton Garden,
London EC1N 8UN

Planning Permission Specialists

Existing Plans & Elevations
As Built

Drawing Number
SCS19-2002

COPYRIGHT ©