



PLANNING DRAWINGS


SCALE: 1:50 @A1

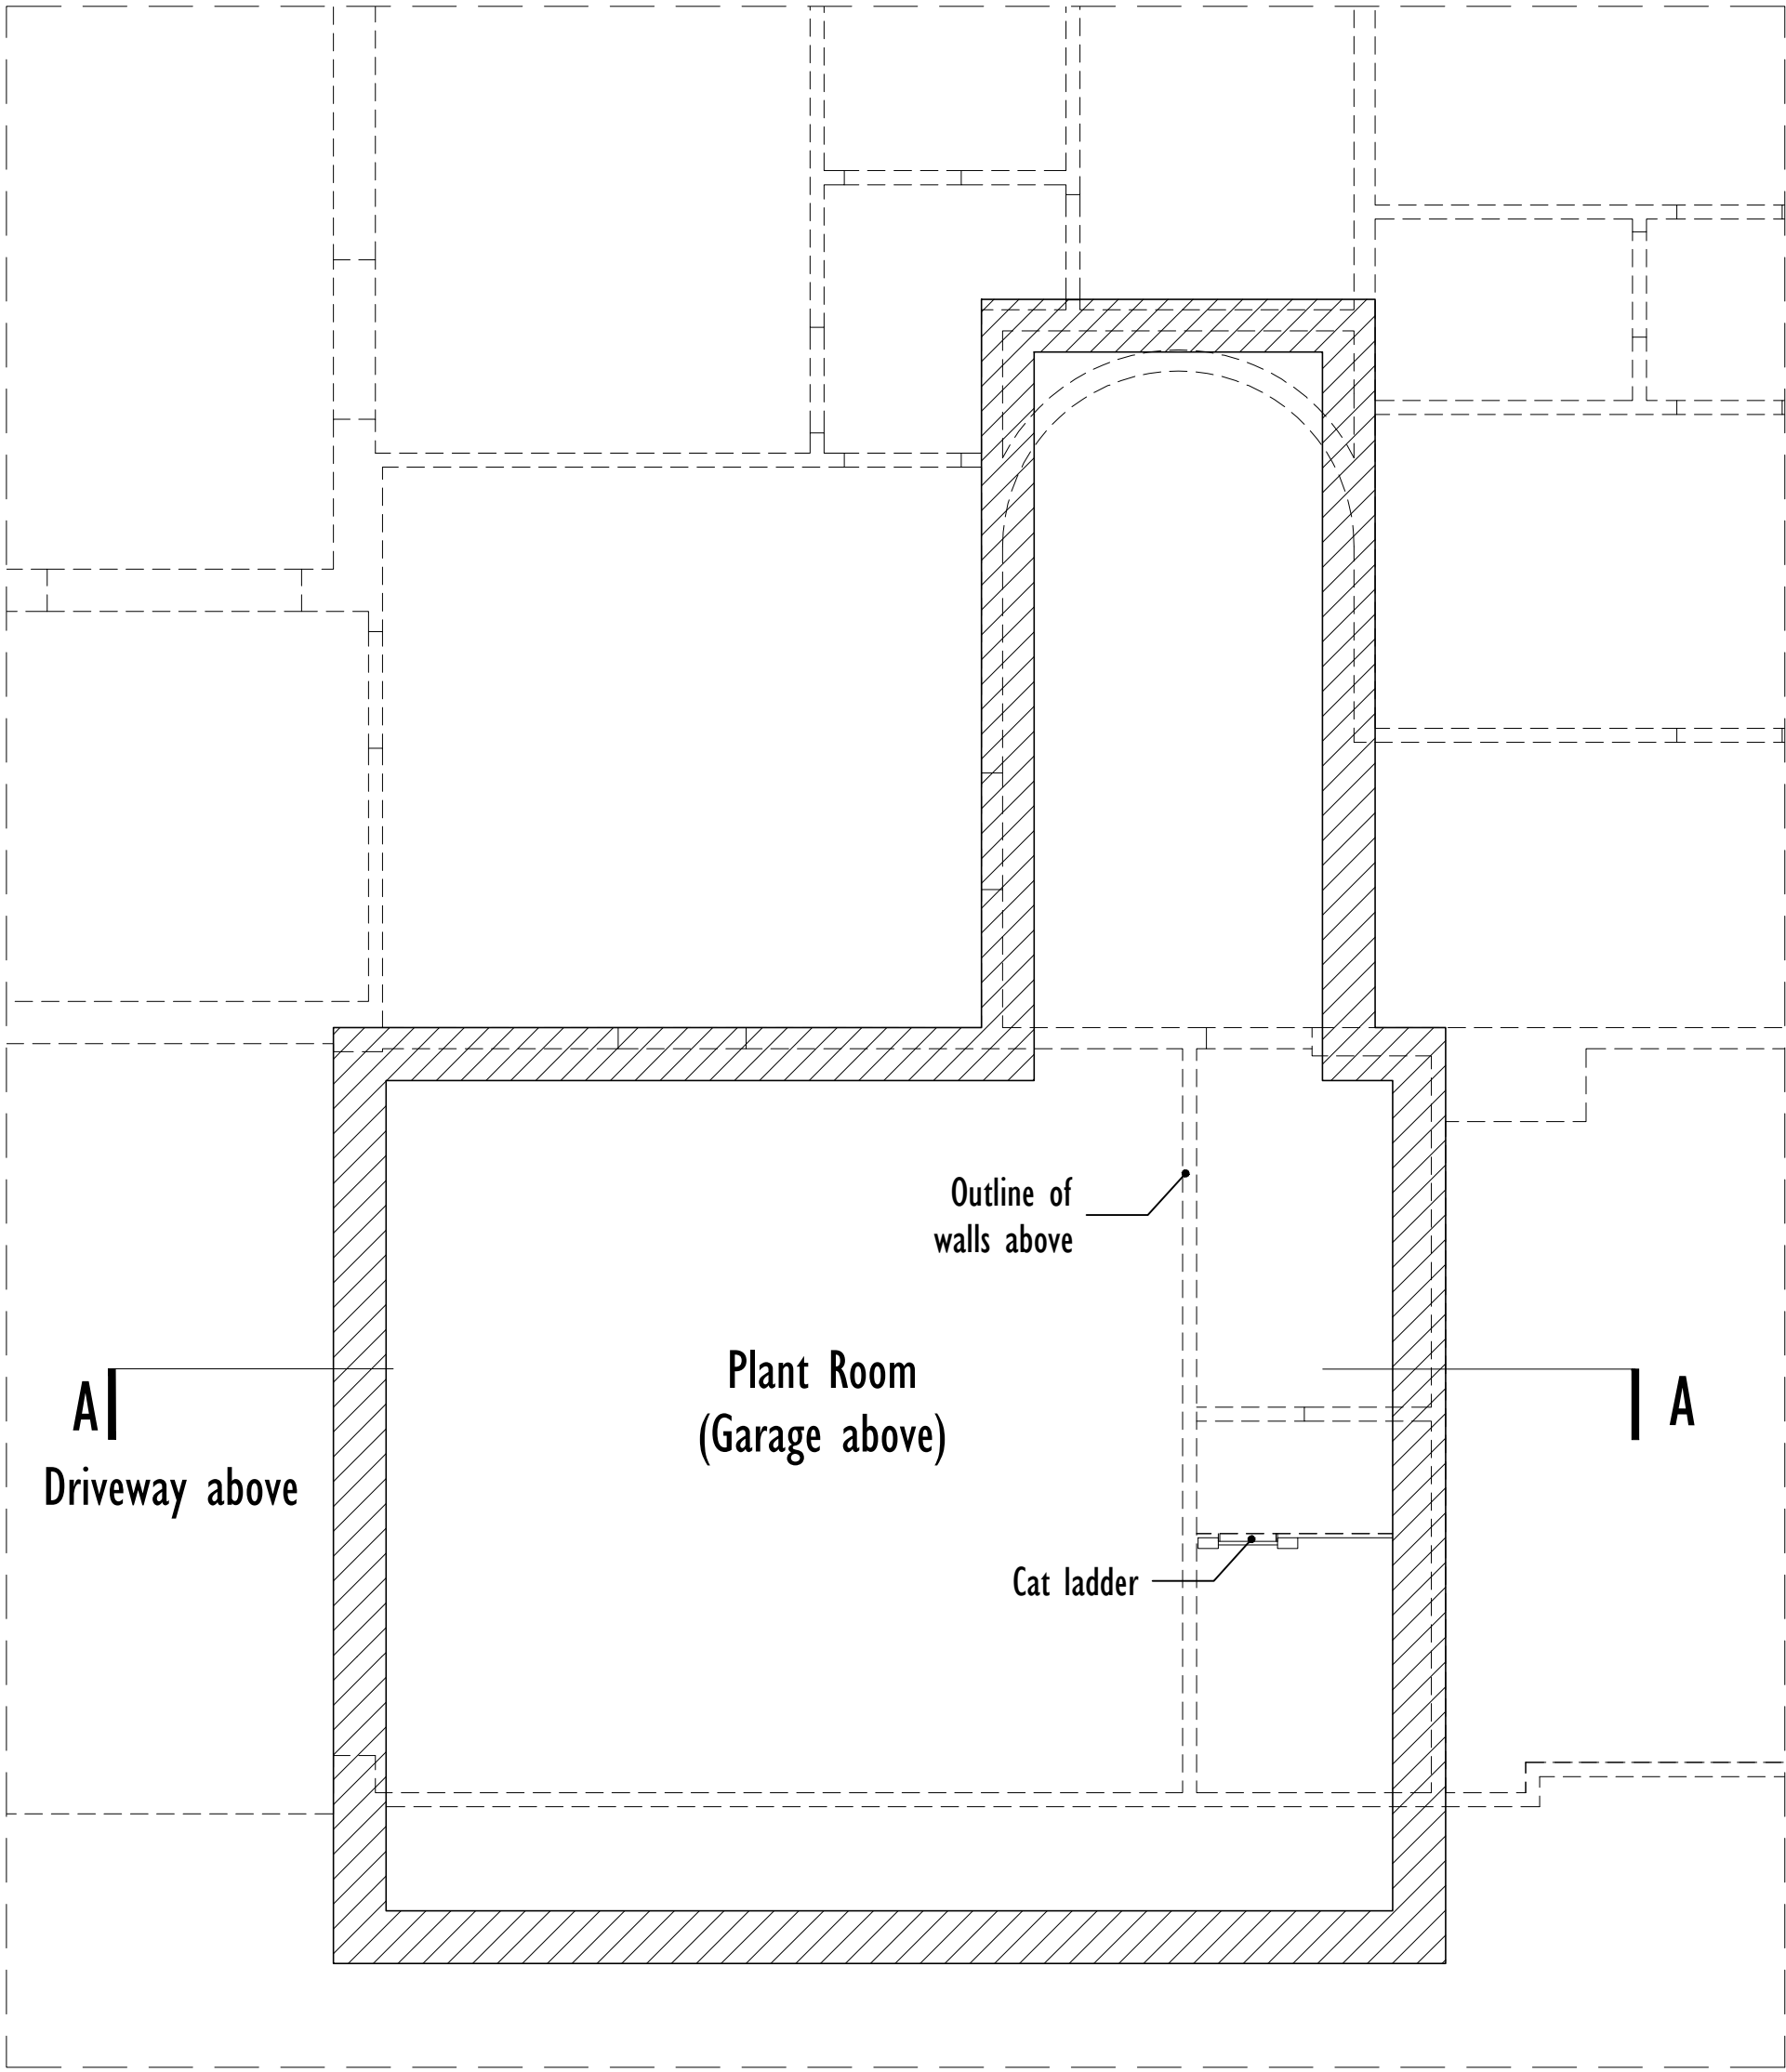

AS BUILT BASEMENT FLOOR

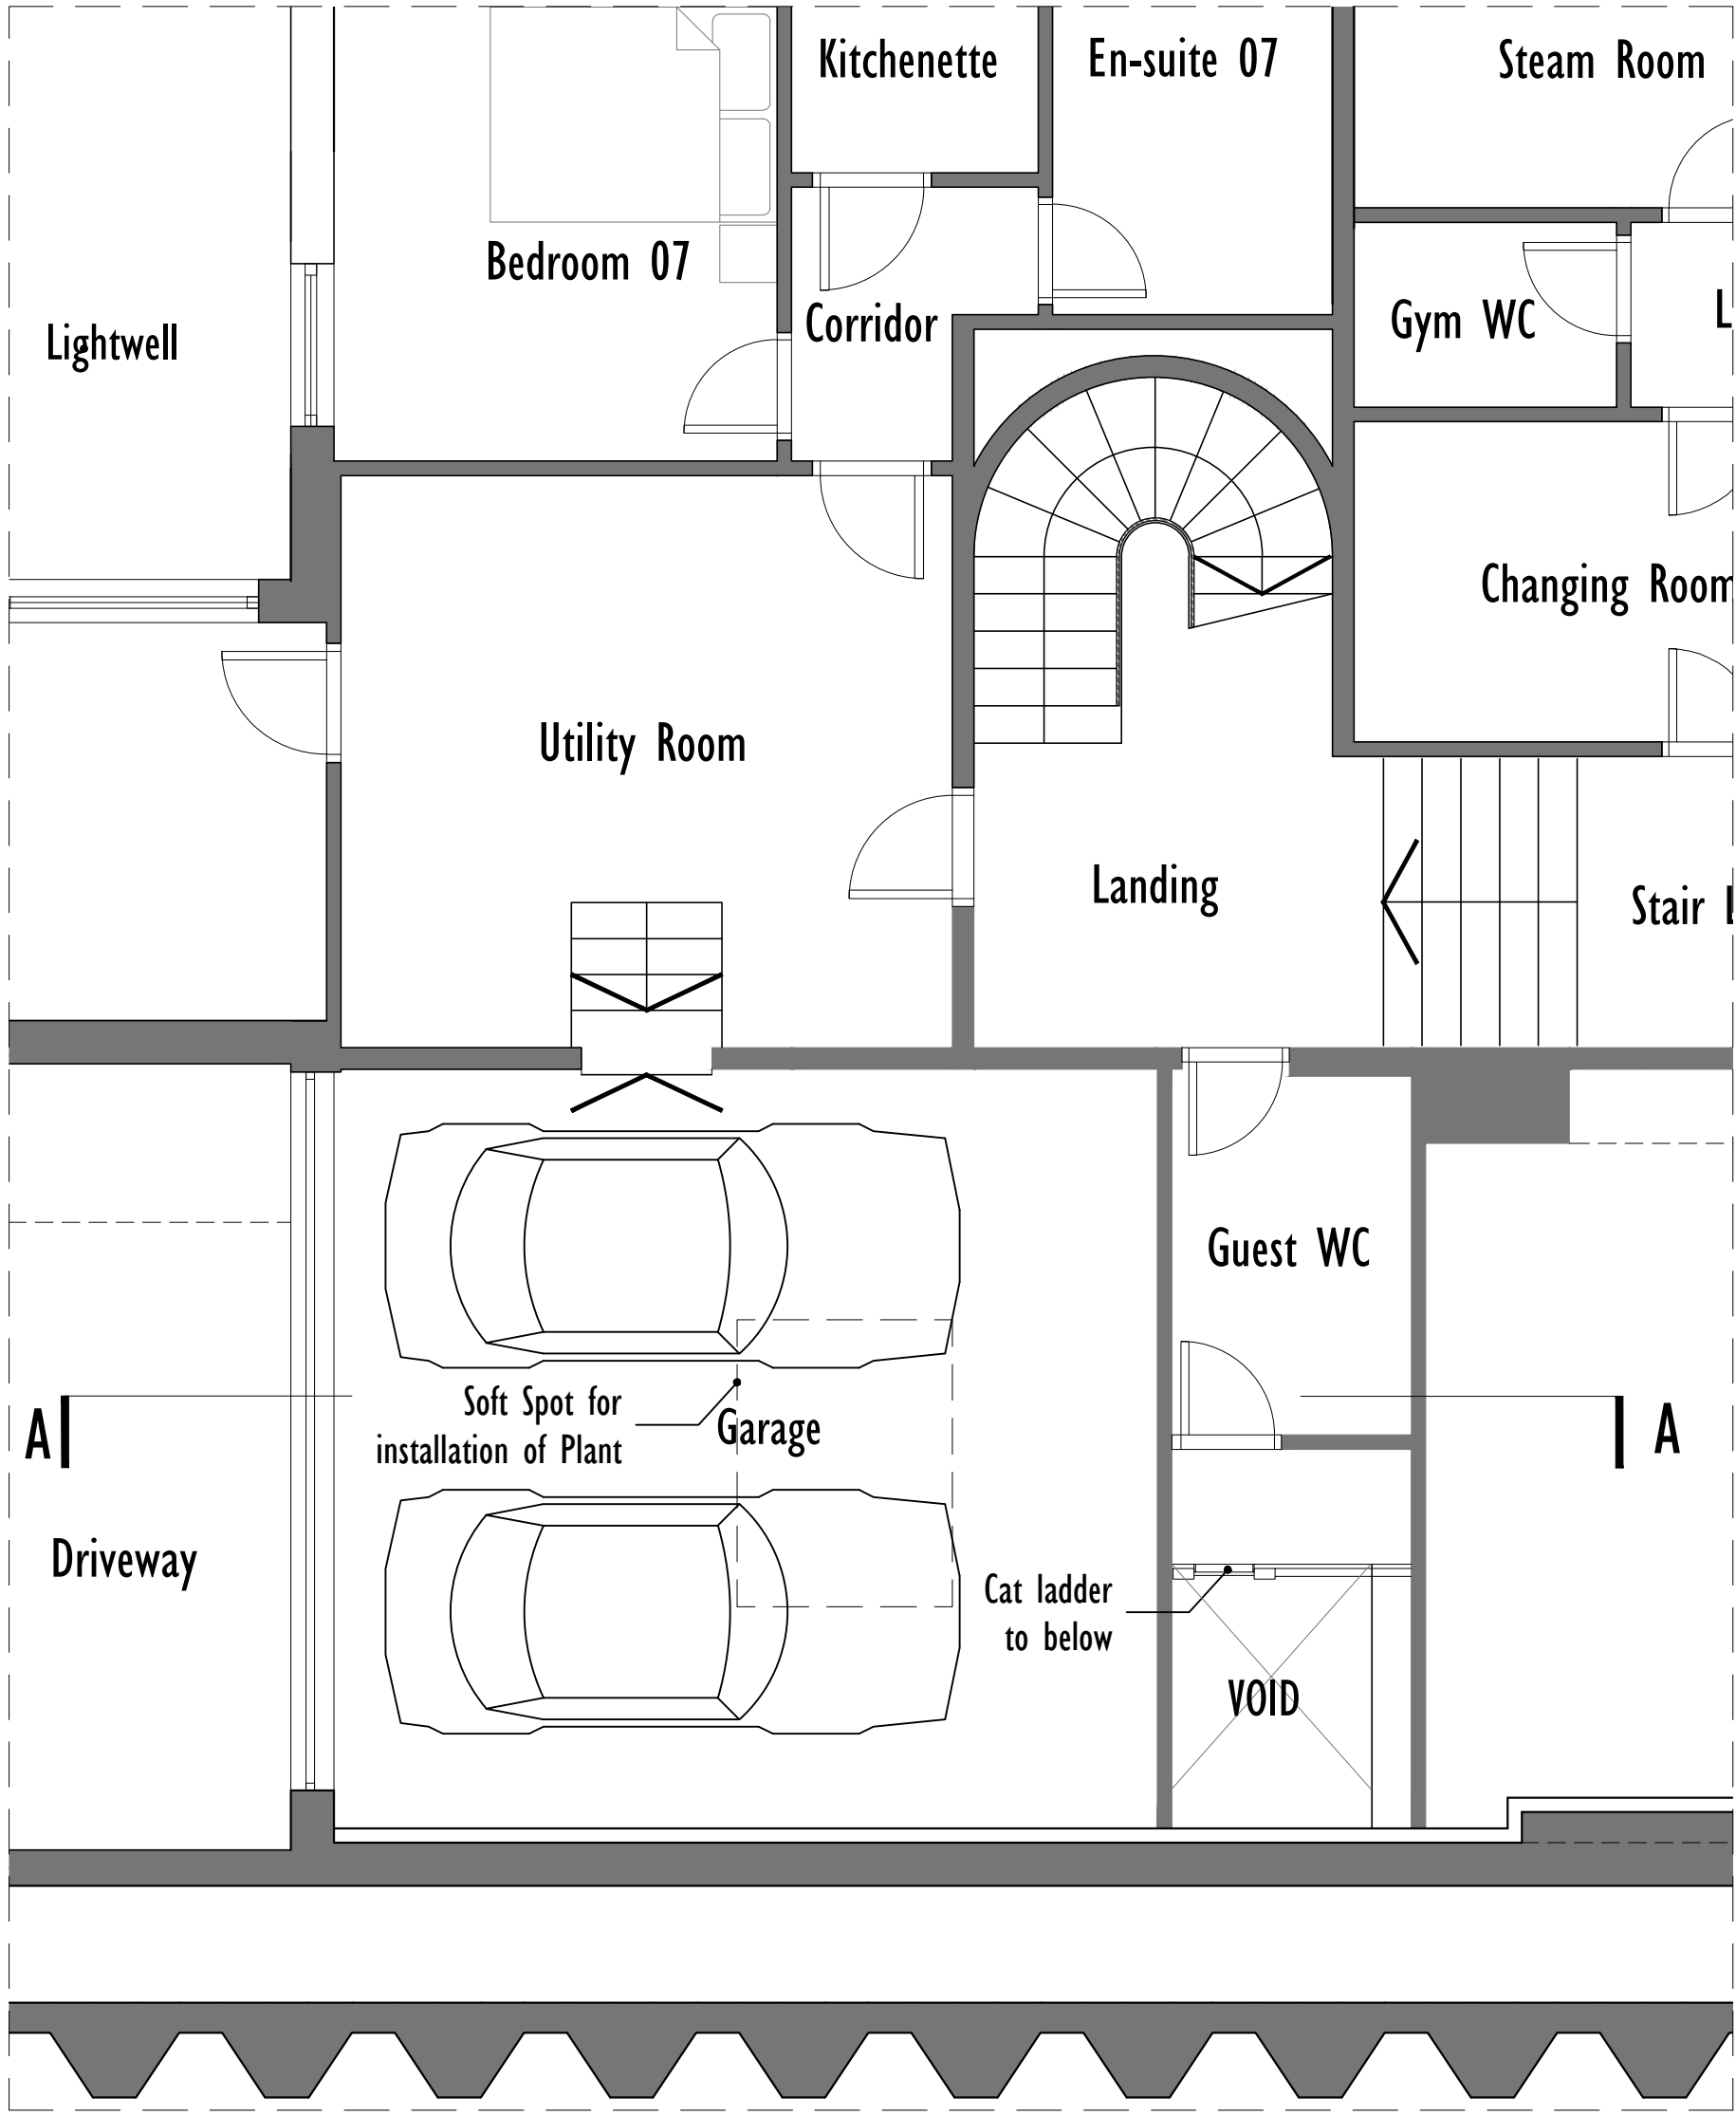

AS BUILT LOWER GROUND FLOOR

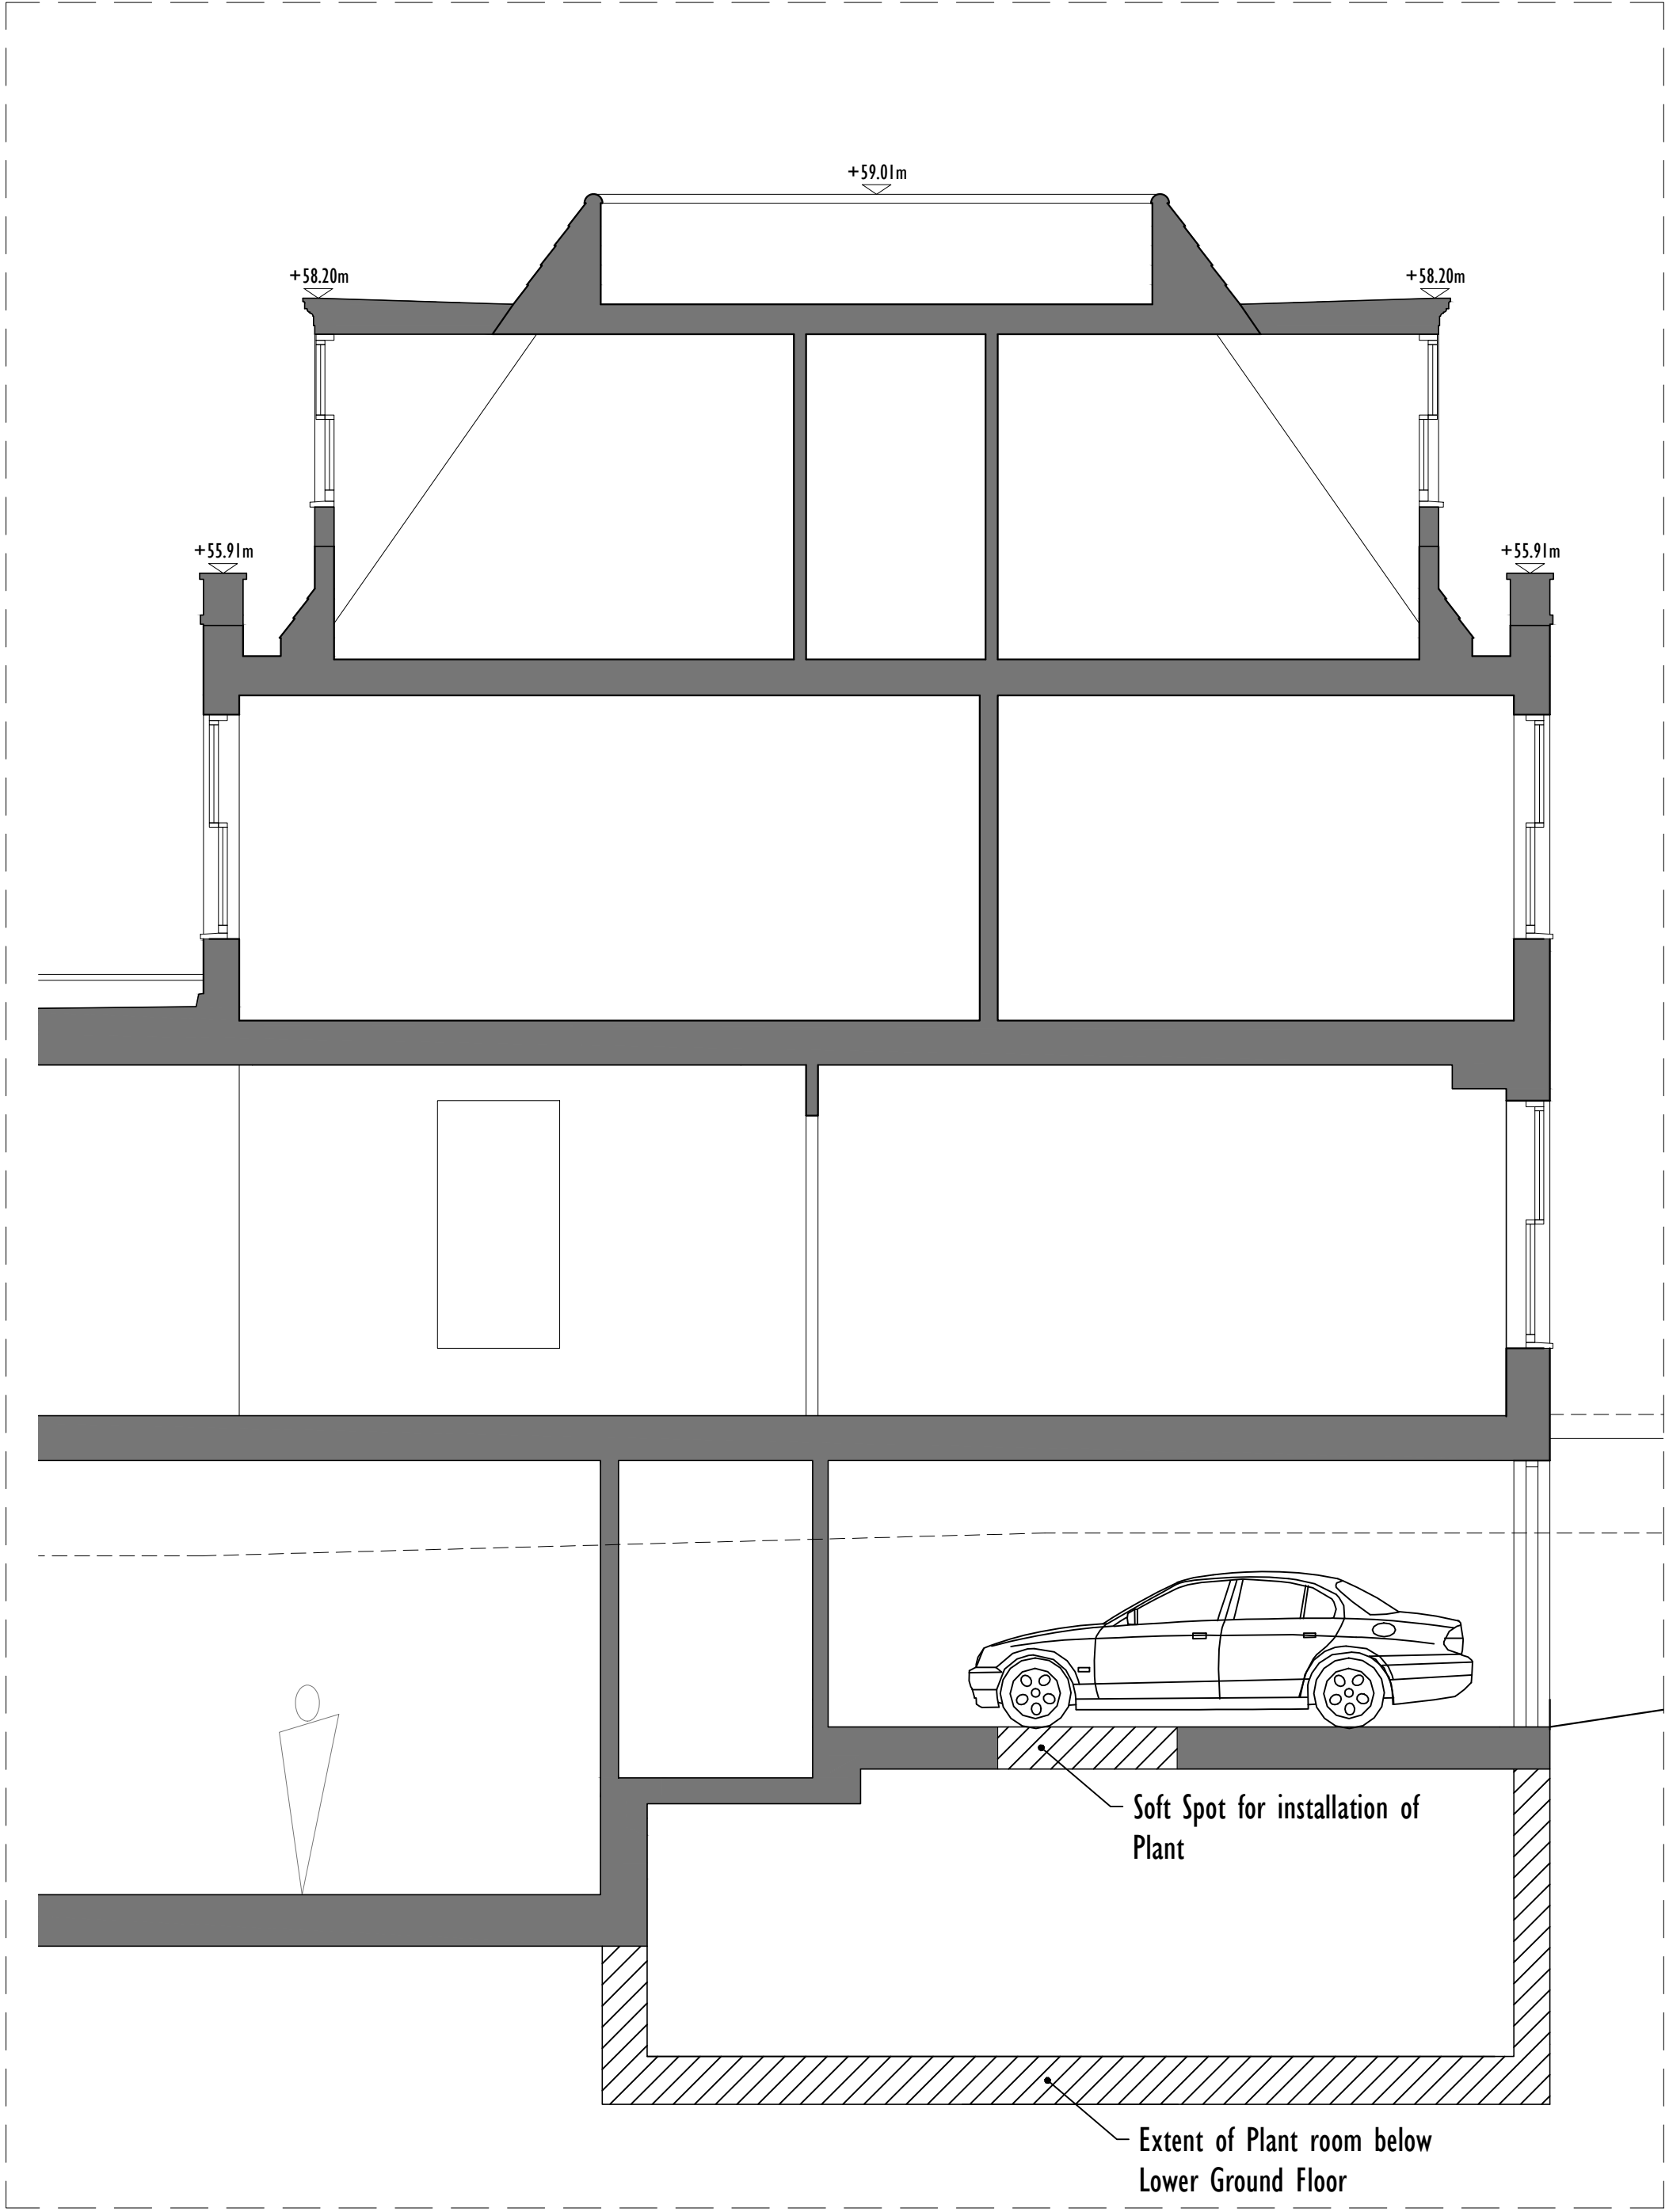

AS BUILT SECTION A - A

