


1. Refer to Scale Bar & Title Block for drawn Scale.  
2. Check all dimensions on site before work is commenced.  
3. All goods, materials and workmanship to conform with current building, fire and safety regulations. All specified products installed to manufacturers' specifications.

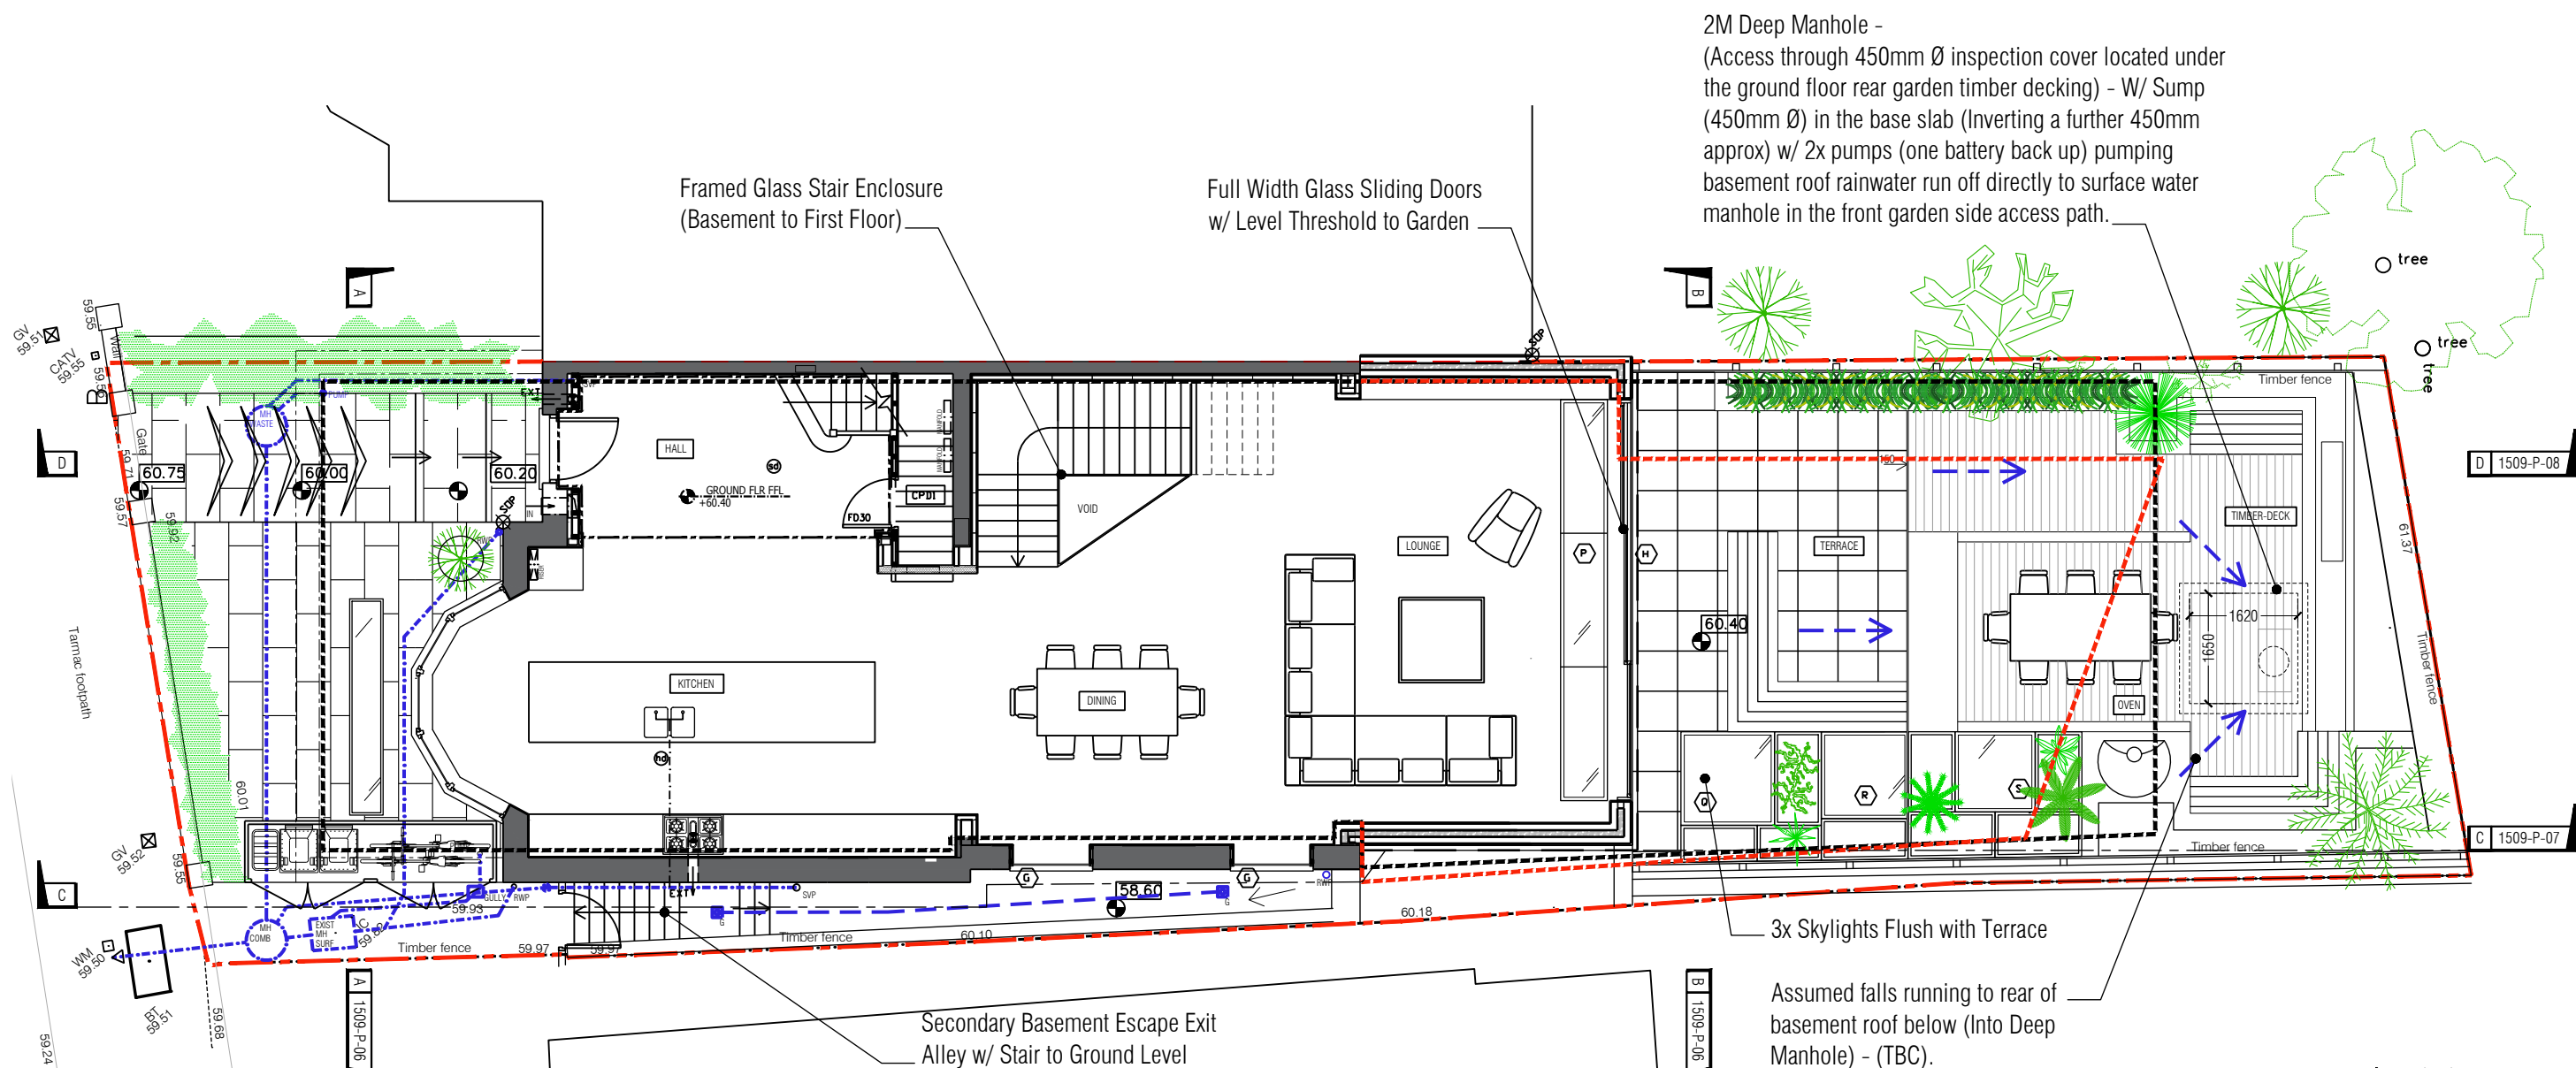

30/11/15	B	Agreed Planning Basement Outline Added	DT
26/11/15	A	Issued as Information	DT
30/10/15	D	Issued as Information	DT
Date	Rev	Revision details	Initial

DT360 Design & Architecture

27 Hibbert Rd, Walthamstow, London, E17 8HB  
+44 (0)7818 008225 - dornitucki@gmail.com

Client  
Mr. Mario Garcia

Project  
8 Antrim Grove  
Belsize Park  
London  
NW3 4XR

Drawing  
As Built - Ground Floor Plan

1509-P-02

Scale 1:100 @ A3  
1:50 @ A1

Date 16/09/15

Rev B  
Draw DT

Suspected discrepancies must be reported to designer for clarification.  
© DT360 Design & Architecture Ltd 2015



1 Ground Floor Plan  
1:50 @A1 - 1:100 @A3

2 Line/Hatch Key  
NTS

Scale @ A3 = M