



1. Refer to Scale Bar & Title Block for draw Scale.
 2. Check all dimensions on site before work is commenced.
 3. All goods, materials and workmanship to conform with current building, fire and safety regulations. All specified products installed to manufacturers' specifications.

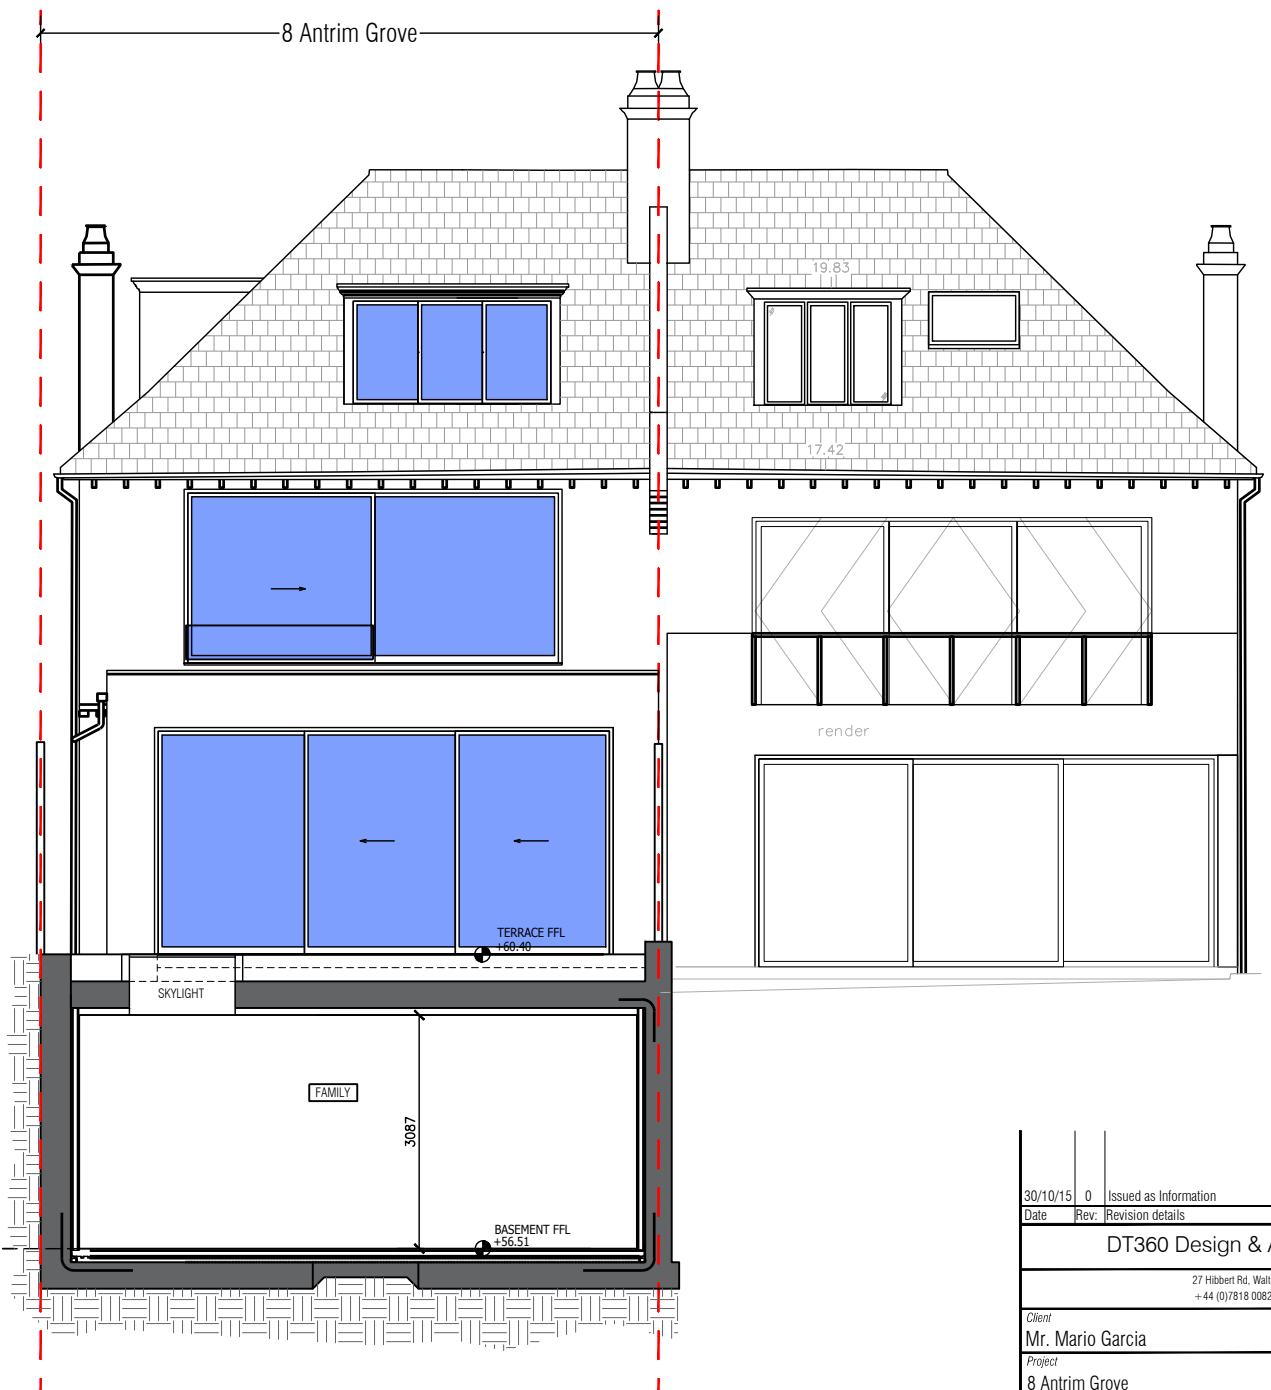

1 Front Elevation/Section - A
 1:50 @A1 - 1:100 @A3

1 Rear Elevation/Section - B
 1:50 @A1 - 1:100 @A3

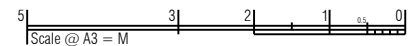

30/10/15	0	Issued as Information	DT
Date	Rev	Revision details	Initial
DT360 Design & Architecture			
<small>27 Hibbert Rd, Walthamstow, London, E17 8HB +44 (0)7818 008225 - domtucki@gmail.com</small>			
<i>Client</i>			
Mr. Mario Garcia			
<i>Project</i>			
8 Antrim Grove Belsize Park London NW3 4XR			
<i>Drawing</i>			
As Built - Elevation A & B			
1509-P-06			<i>Rev</i>
Scale 1:100 @ A3			0
1:50 @ A1			<i>Draw</i>
Date 16/09/15			DT
<small>Suspected discrepancies must be reported to designer for clarification. ©DT360 Design & Architecture Ltd 2015</small>			