
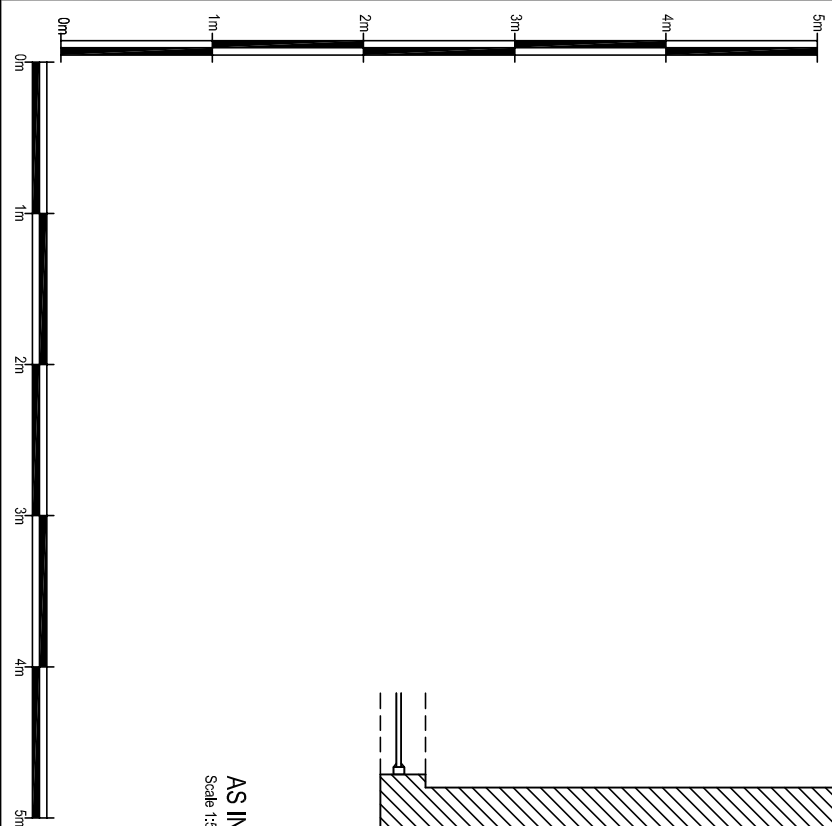


- STEEL ROLLER SHUTTER TO BE CUT TO ALLOW 24HR ACCESS TO ATM
- NEW MULLION & SHUTTER GUIDE RAIL INSTALLED TO ALLOW SHUTTER TO BE CUT.
- NEW ATM INSTALLED THROUGH EXISTING WINDOW OPENING. GLAZING TO BE REPLACED WITH NEW COMPOSITE PANEL COLOUR: WHITE
- NOTE: ATM FASCA C/W PRIVACY MIRRORS INSTALLED AT SHOULDER LEVEL.

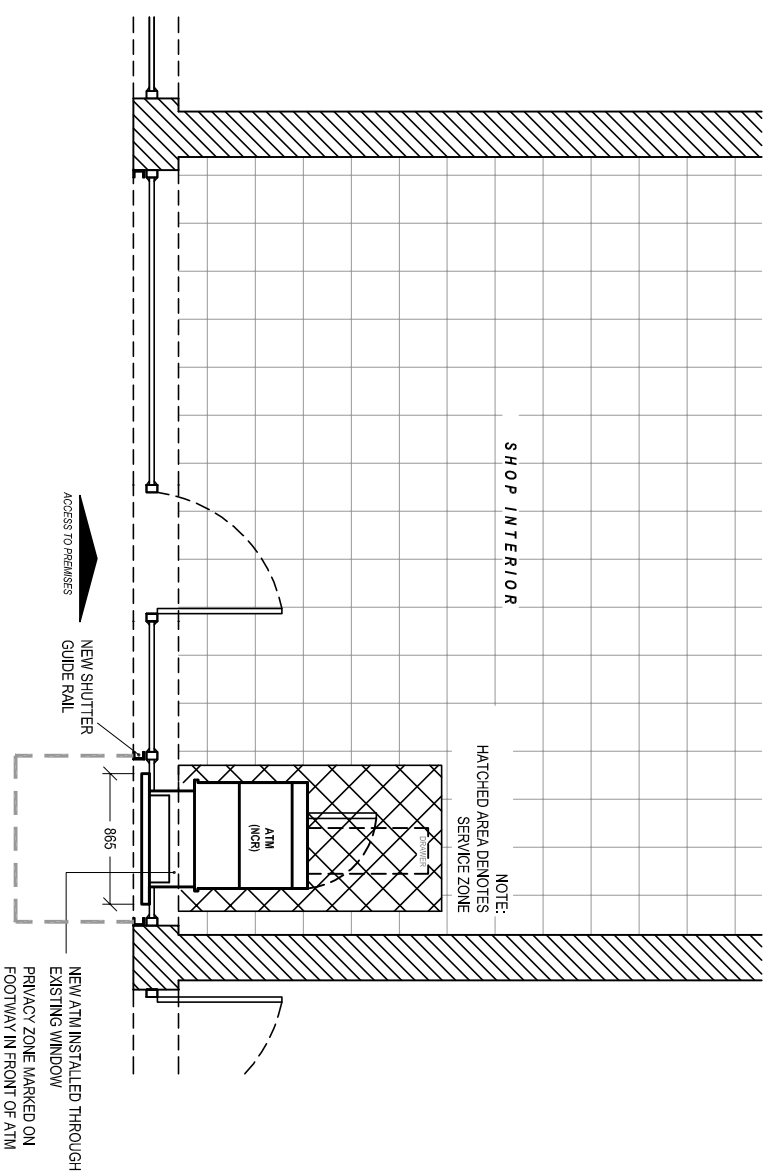

Date:	Comments:	By:
29-02-16	Security mirrors and Privacy zone added.	CM

GENERAL NOTES:
1) All dimensions in millimeters unless otherwise stated.

Site:
EXPRESS FOOD & WINE
379 Kentish Town Road,
London,
NW5 2TJ

Drawing Title:
As Installed Elevation and Plan

Ref:	Date:	Rev:
NM-11-2015-96-2	16-11-2015	A
Scale:	Paper:	Date Rev:
1:50	A3	29-02-2016