



2 Floor - Existing Open space Office
 2-Bedroom Flat Area 106.0 Sqm- Planning Permission Granted - variation in floor layout.

Second Floor Footprint
 Area=286.76 Sqm

2

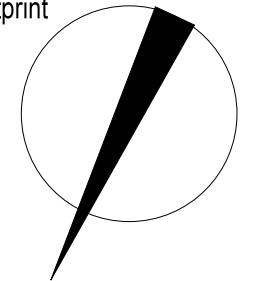

Note:
 All dimensions must be checked on site before any
 design and/or construction activities.
 Progress drawings for further design and development.

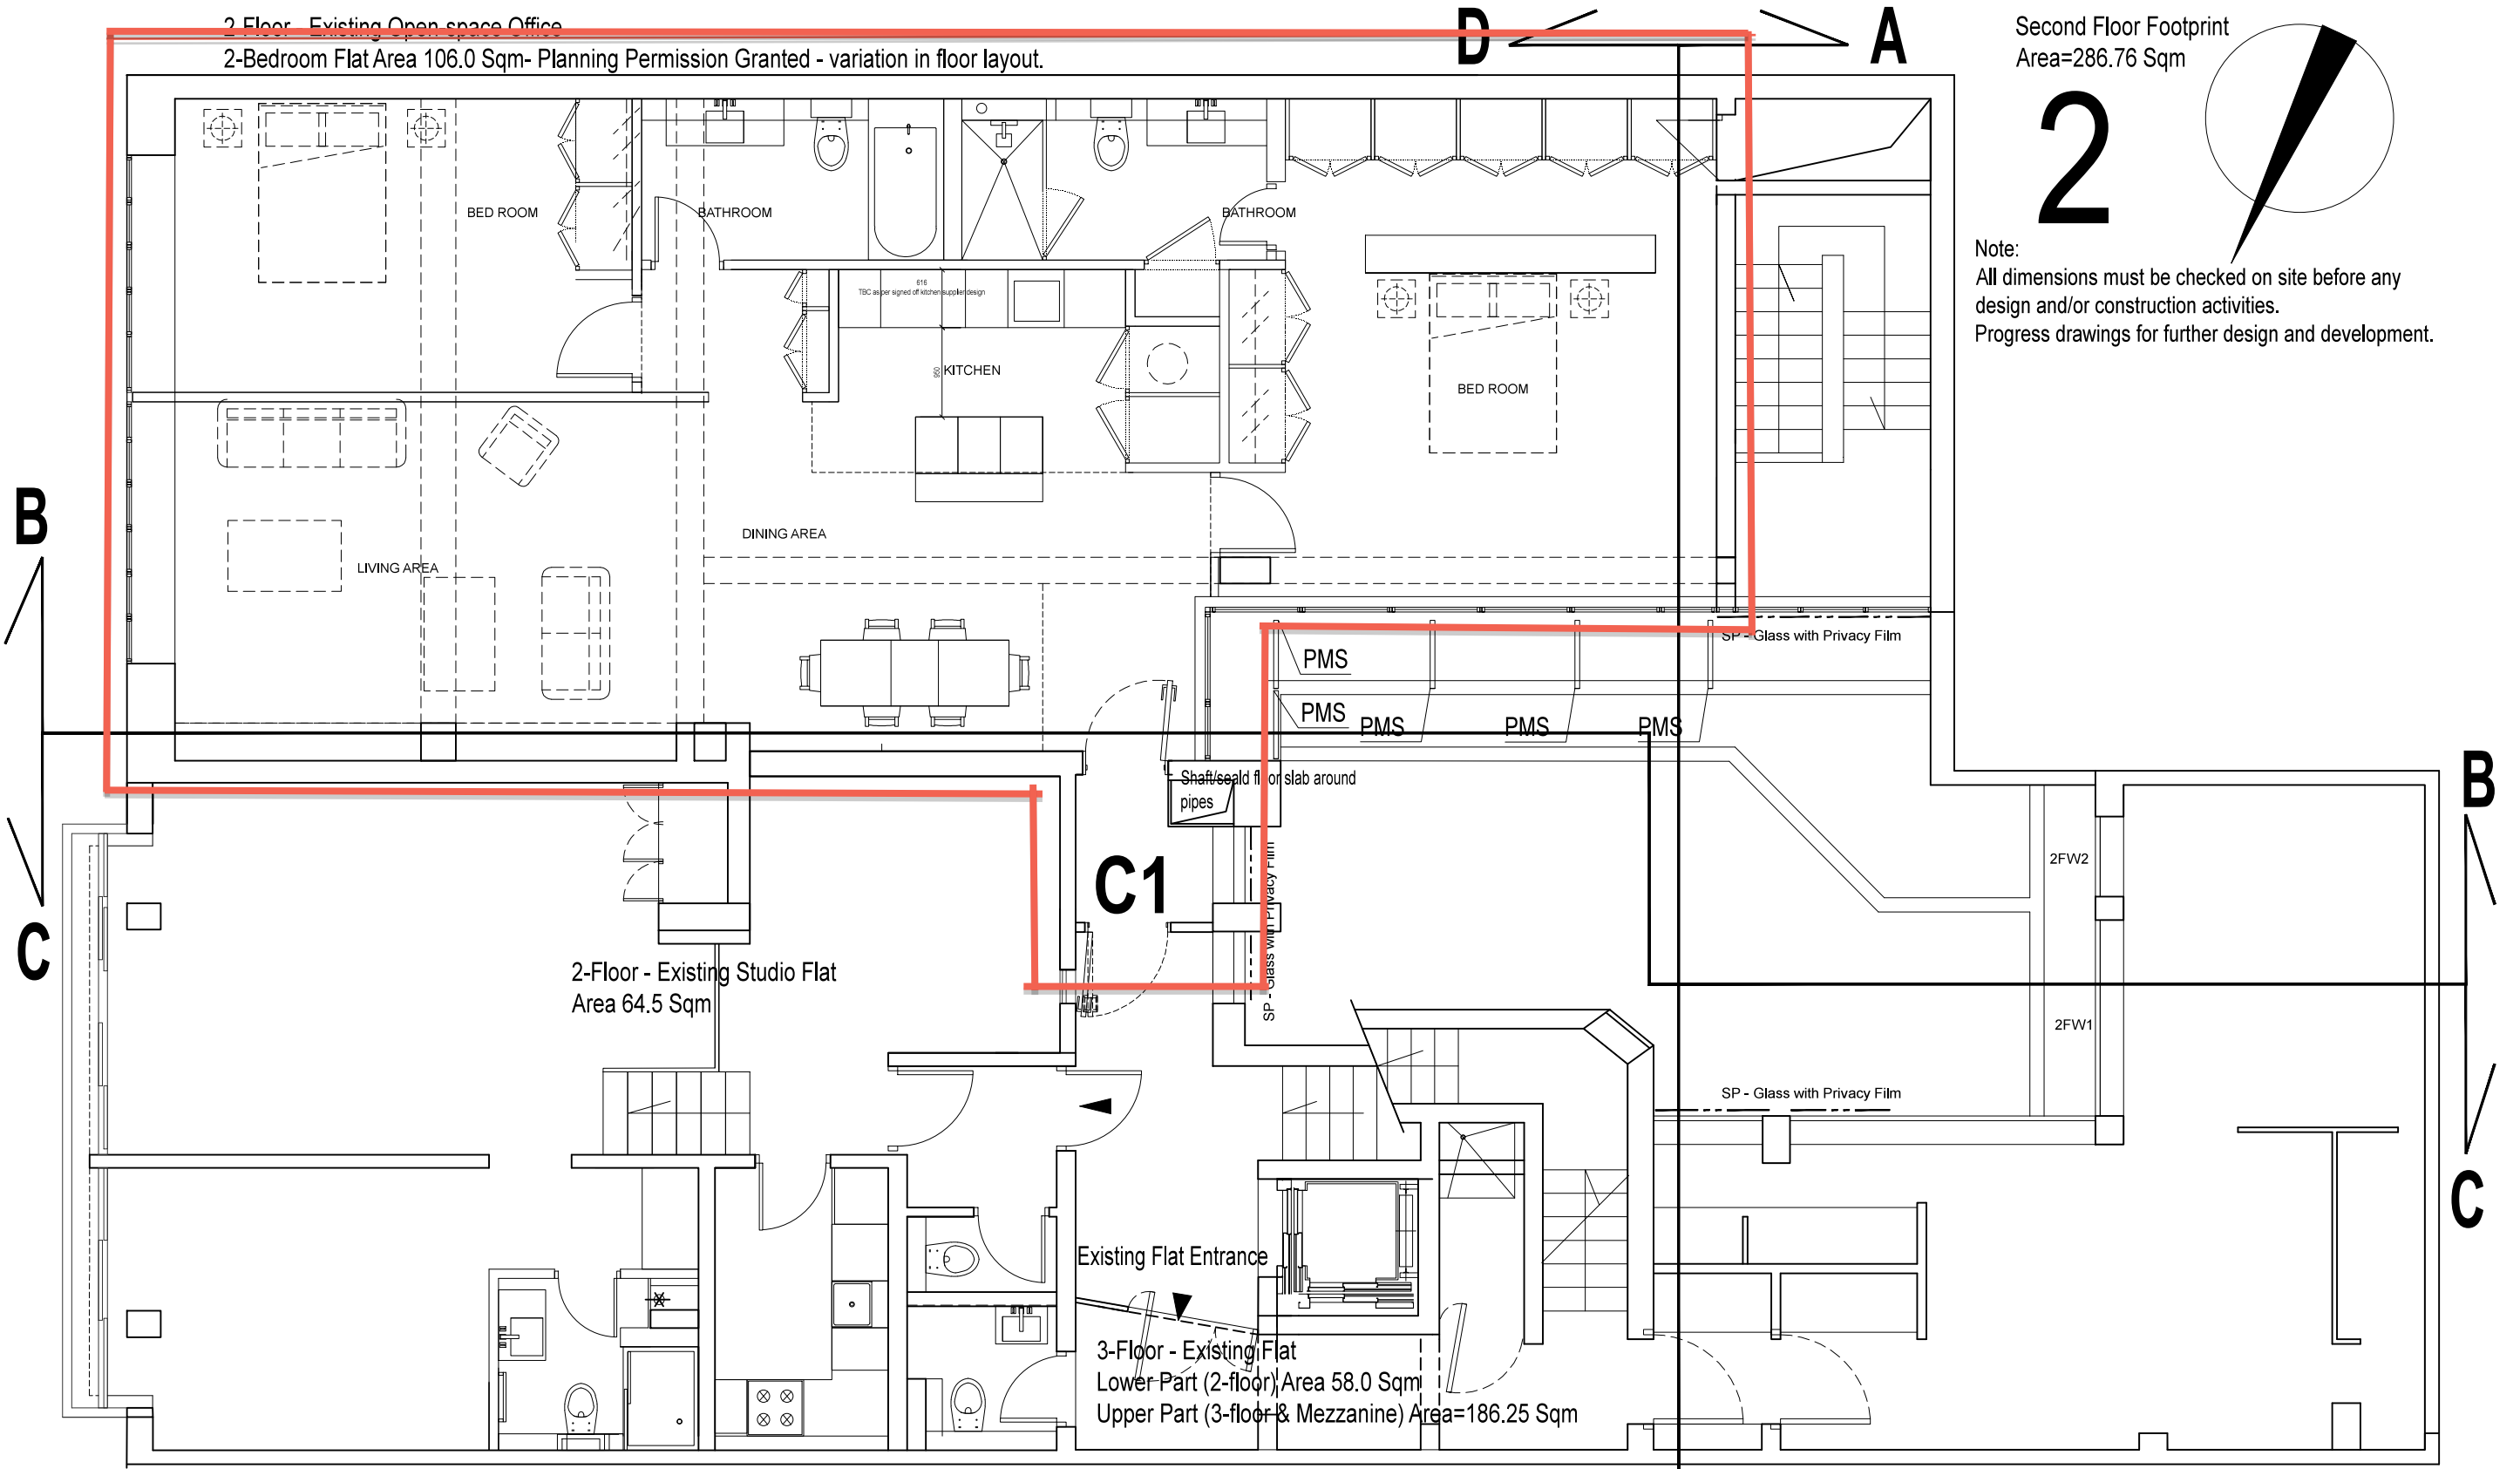

2-Floor - Existing Studio Flat
 Area 64.5 Sqm

Existing Flat Entrance
 3-Floor - Existing Flat
 Lower Part (2-floor) Area 58.0 Sqm
 Upper Part (3-floor & Mezzanine) Area=186.25 Sqm

Proposed Drawing 2Floor Update Sep 2015
 Drawing No: PD1-F2-PL-220
 Substituted Drawing No.: PL-220 Approved Development:2009/5380/P
 Annotation of amendment marked in Red
 Date 5 February 2016