



2-Floor - Existing Open-space Office
 2-Bedroom Flat Area 106.0 Sqm- Planning Permission Granted - variation in floor layout.

Second Floor Footprint
 Area=286.76 Sqm

2

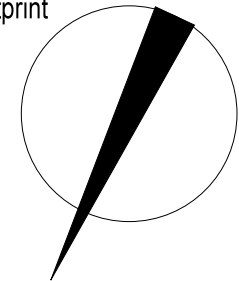

Note:
 All dimensions must be checked on site before any
 design and/or construction activities.
 Progress drawings for further design and development.

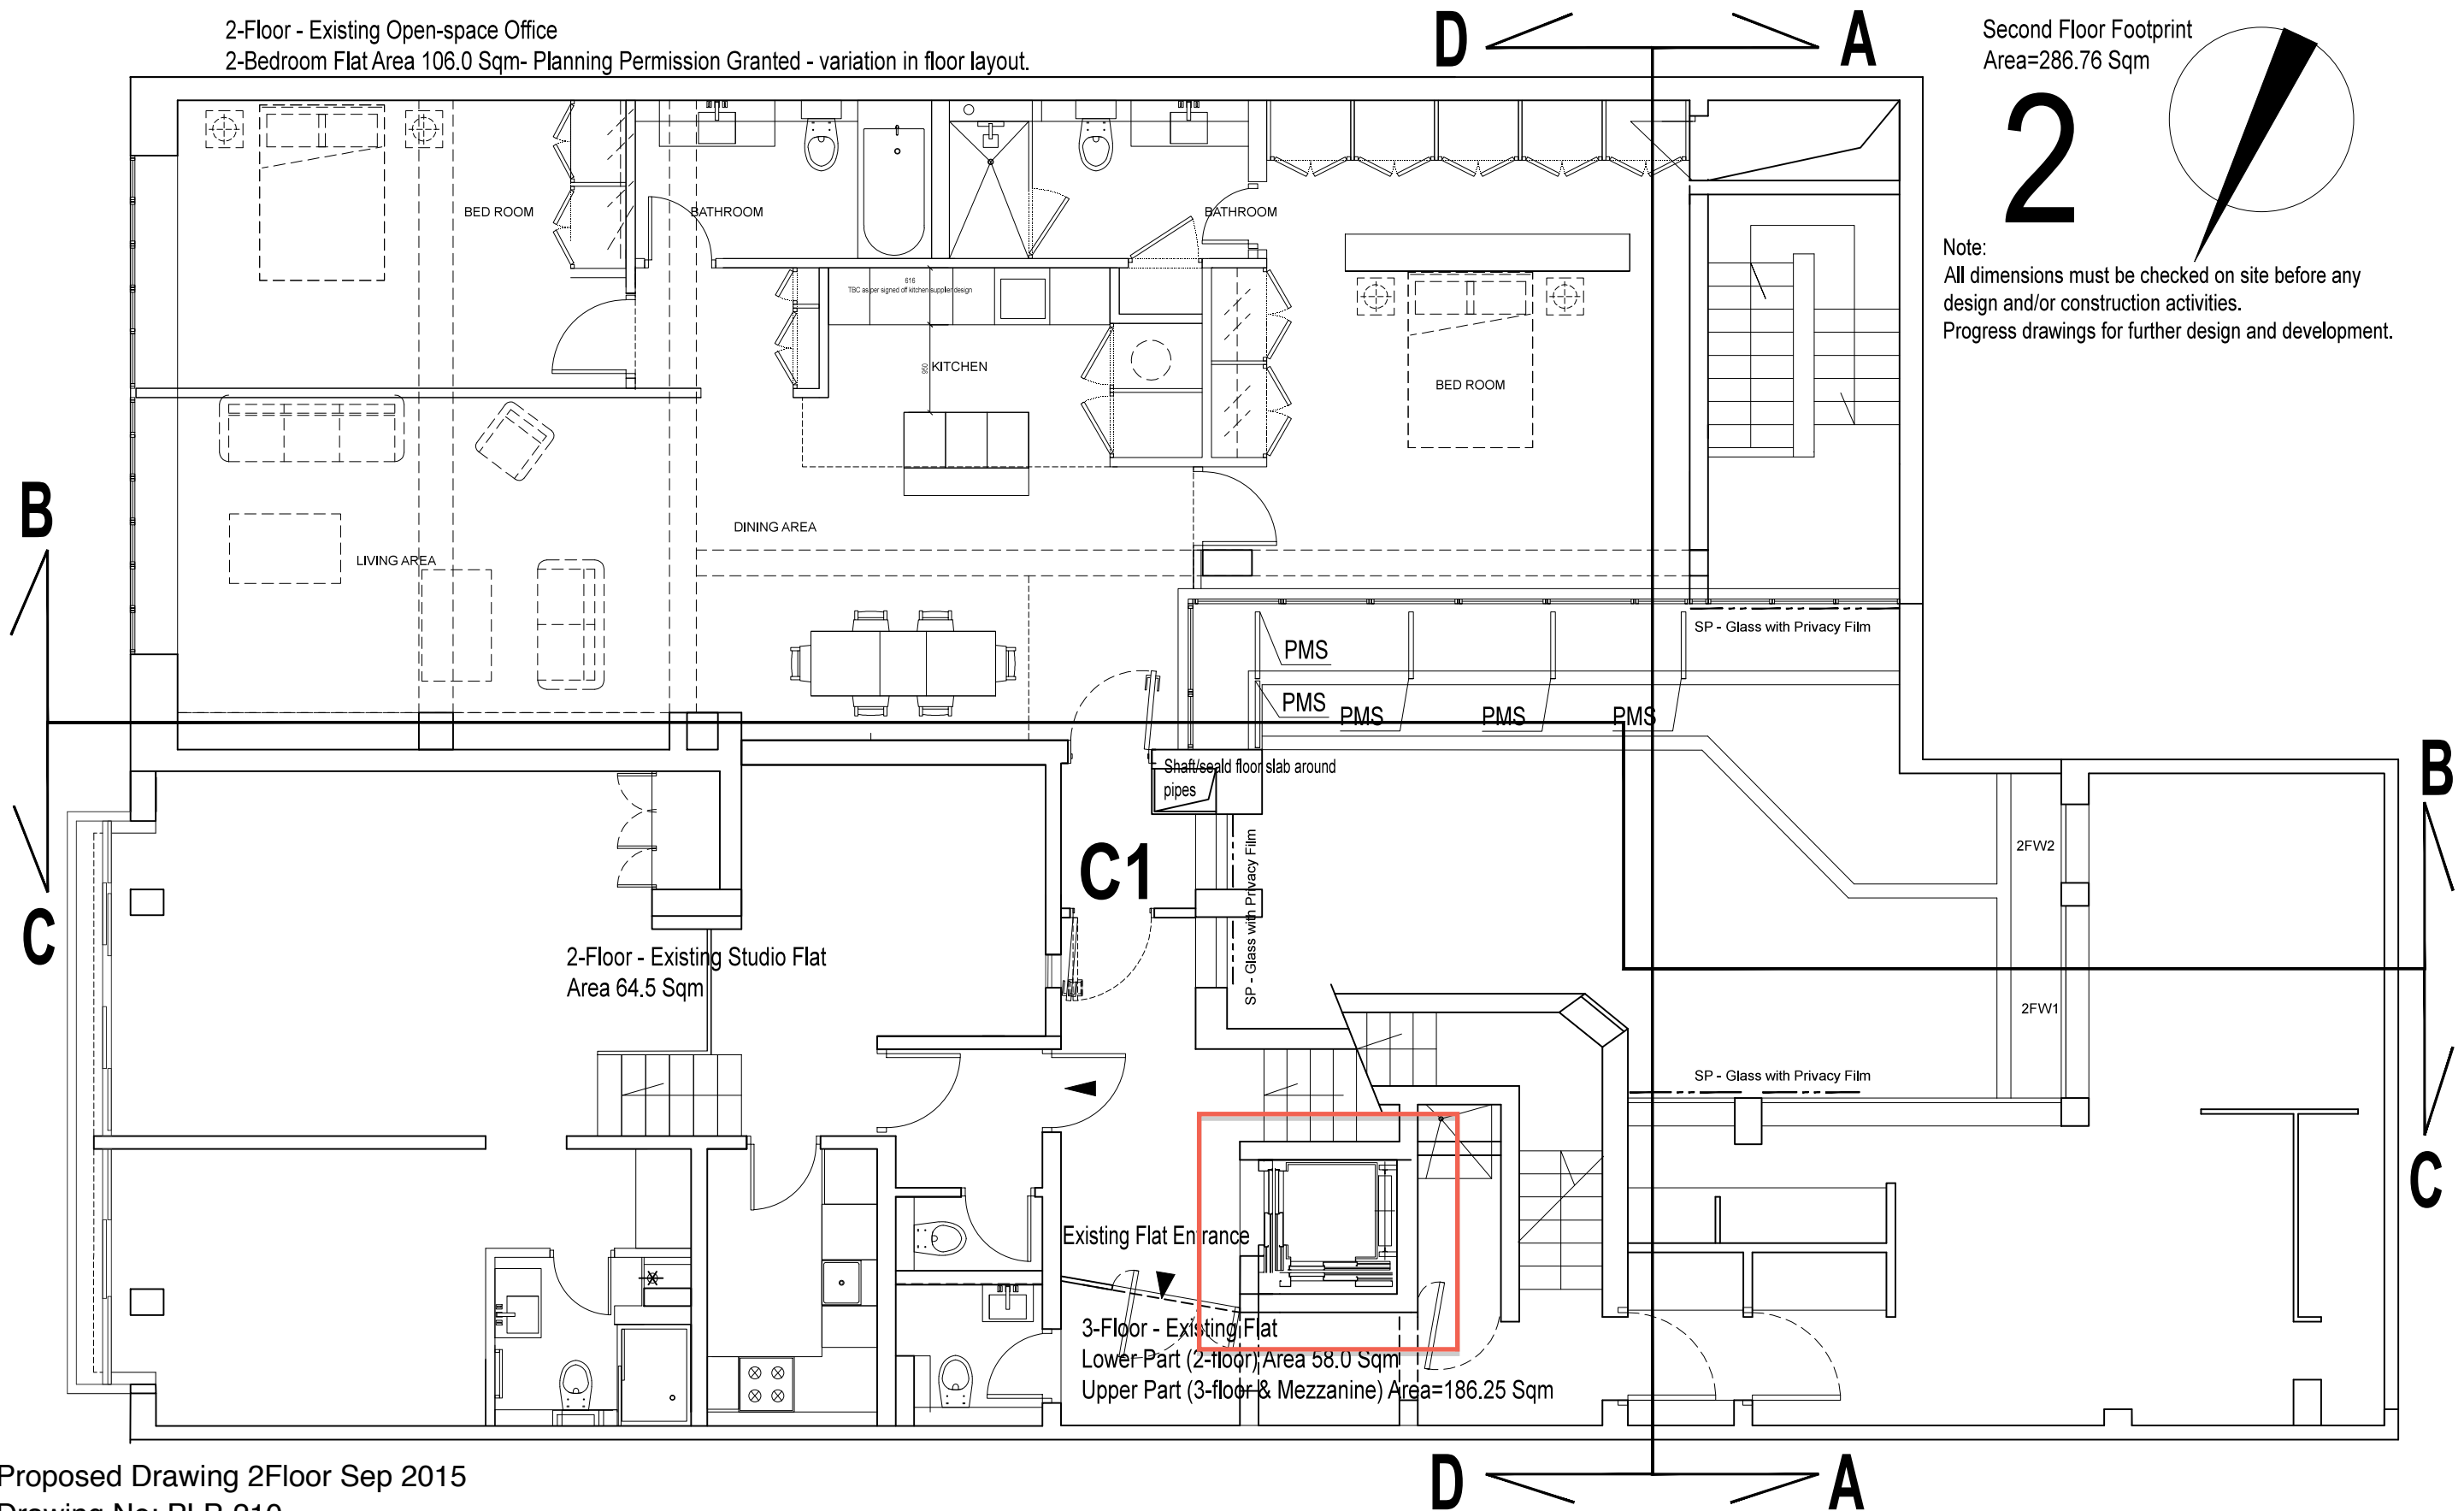

Proposed Drawing 2Floor Sep 2015
 Drawing No: PLP-210
 Approved Development Ref.: 2013-2993/P
 Annotation of proposal marked in red
 Date 5 February 2016