

5.7mtrs to Railings

4.3m


6m

5.1mtrs tables chairs to Railing

2.52mtr. (to post box)

192mm from T+C to post box.

POST BOX

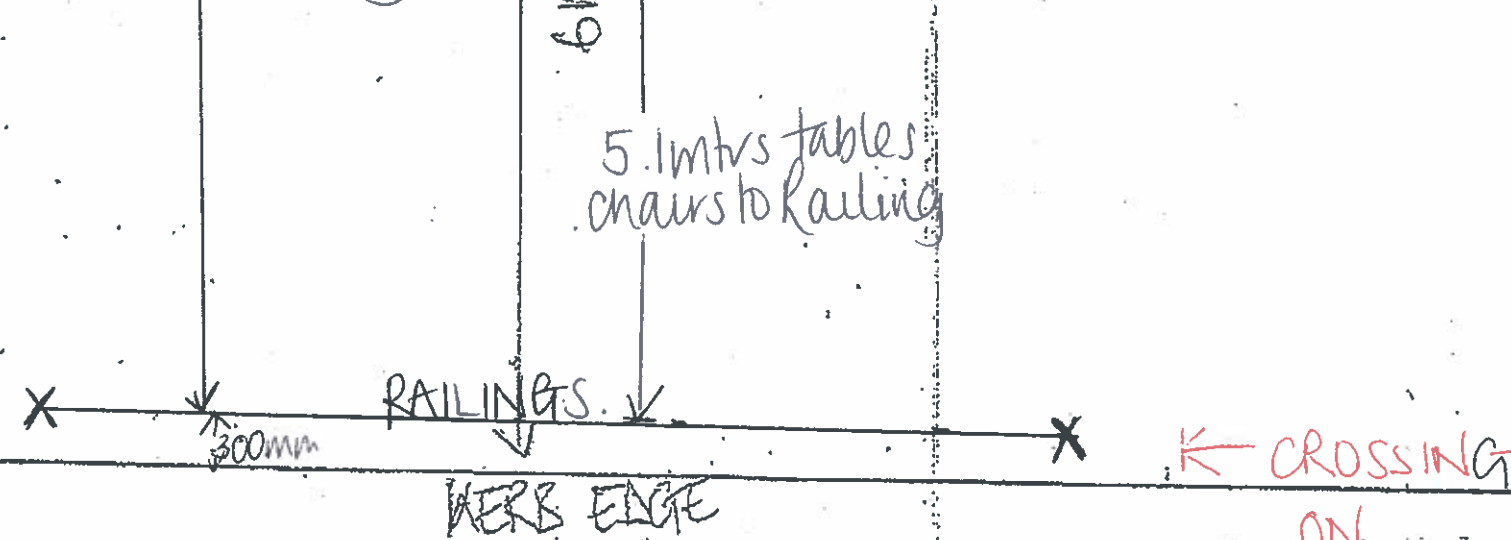

49 Seats

Rev	Description	Date
A	Bar moved back by 150mm into existing baring - 500mm space retained for ductwork.	06.12.07
B	Blocked up existing fire escape moved bar in the light by 1250mm added extra furniture moved position of barquette seat added extra V.C. raised new wall with rectangular cut out - refer to elevations increased size of Bed Bar area	06.12.07
C	Bed added to accommodate milk bar	10.12.07

Notes

This drawing represents a performance guide upon which the contractor/subcontractor must base his/her working drawings & details. Include all necessary tolerances prior to manufacture and installation.

Contractor to must undertake a full survey of the area to establish all dimensions & ensure accurate setting out.

Advice on suitability of all details shown to ensure structural stability, ease and economy of construction.

Refer to digital master artwork in regard to all graphic work shown.

AS BUILT

bedrock

Bedrock Design Consultants Ltd
4th Floor, 57 Falcon Garden, London, E6 9NH
T: 020 8118 0120
F: 020 3118 0121
Info @ bedrockdesign.co.uk

Client: Caffe Nero

Project: Theobolds Road

Description: Proposed Merchandising GA

Scale: 1/50
Drawn by: Nb
Date: 18/12/07

Drawing No: CN341_001
Revision: D

This drawing is the copyright of Bedrock Design Consultants Ltd. This drawing can not be copied, reproduced, retained or disclosed to any unauthorised person without prior permission in writing from the designer.

CROSSING ON EDGE OF DEMISE