
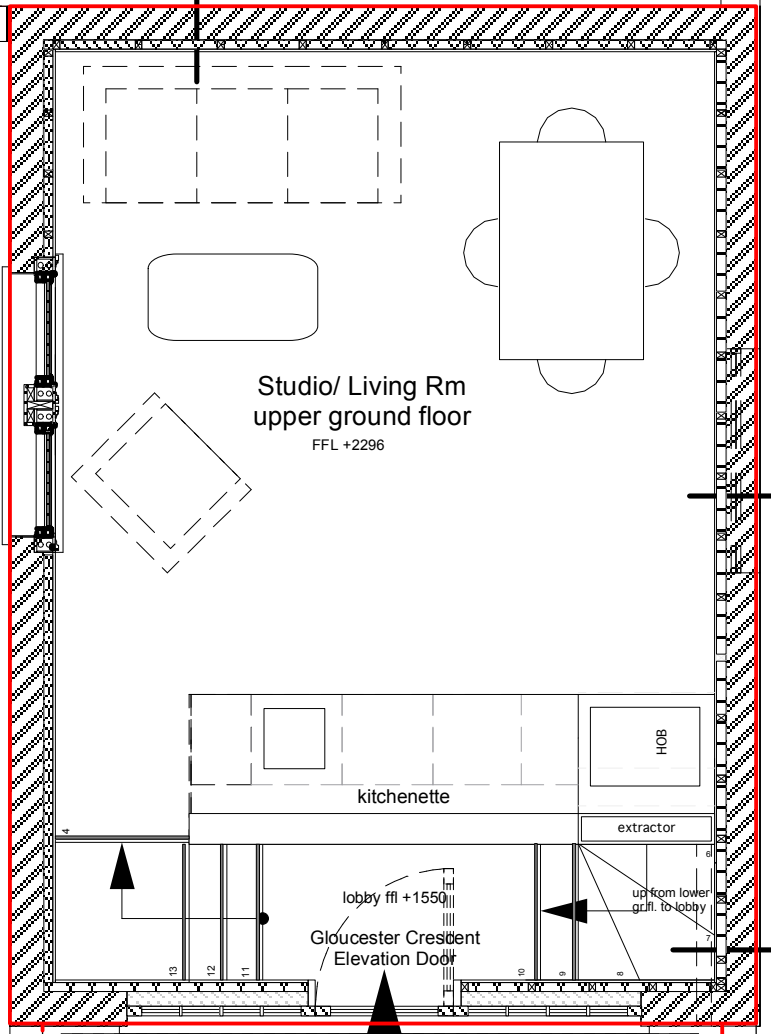


1 REGENTS PARK TERRACE
existing upper ground floor

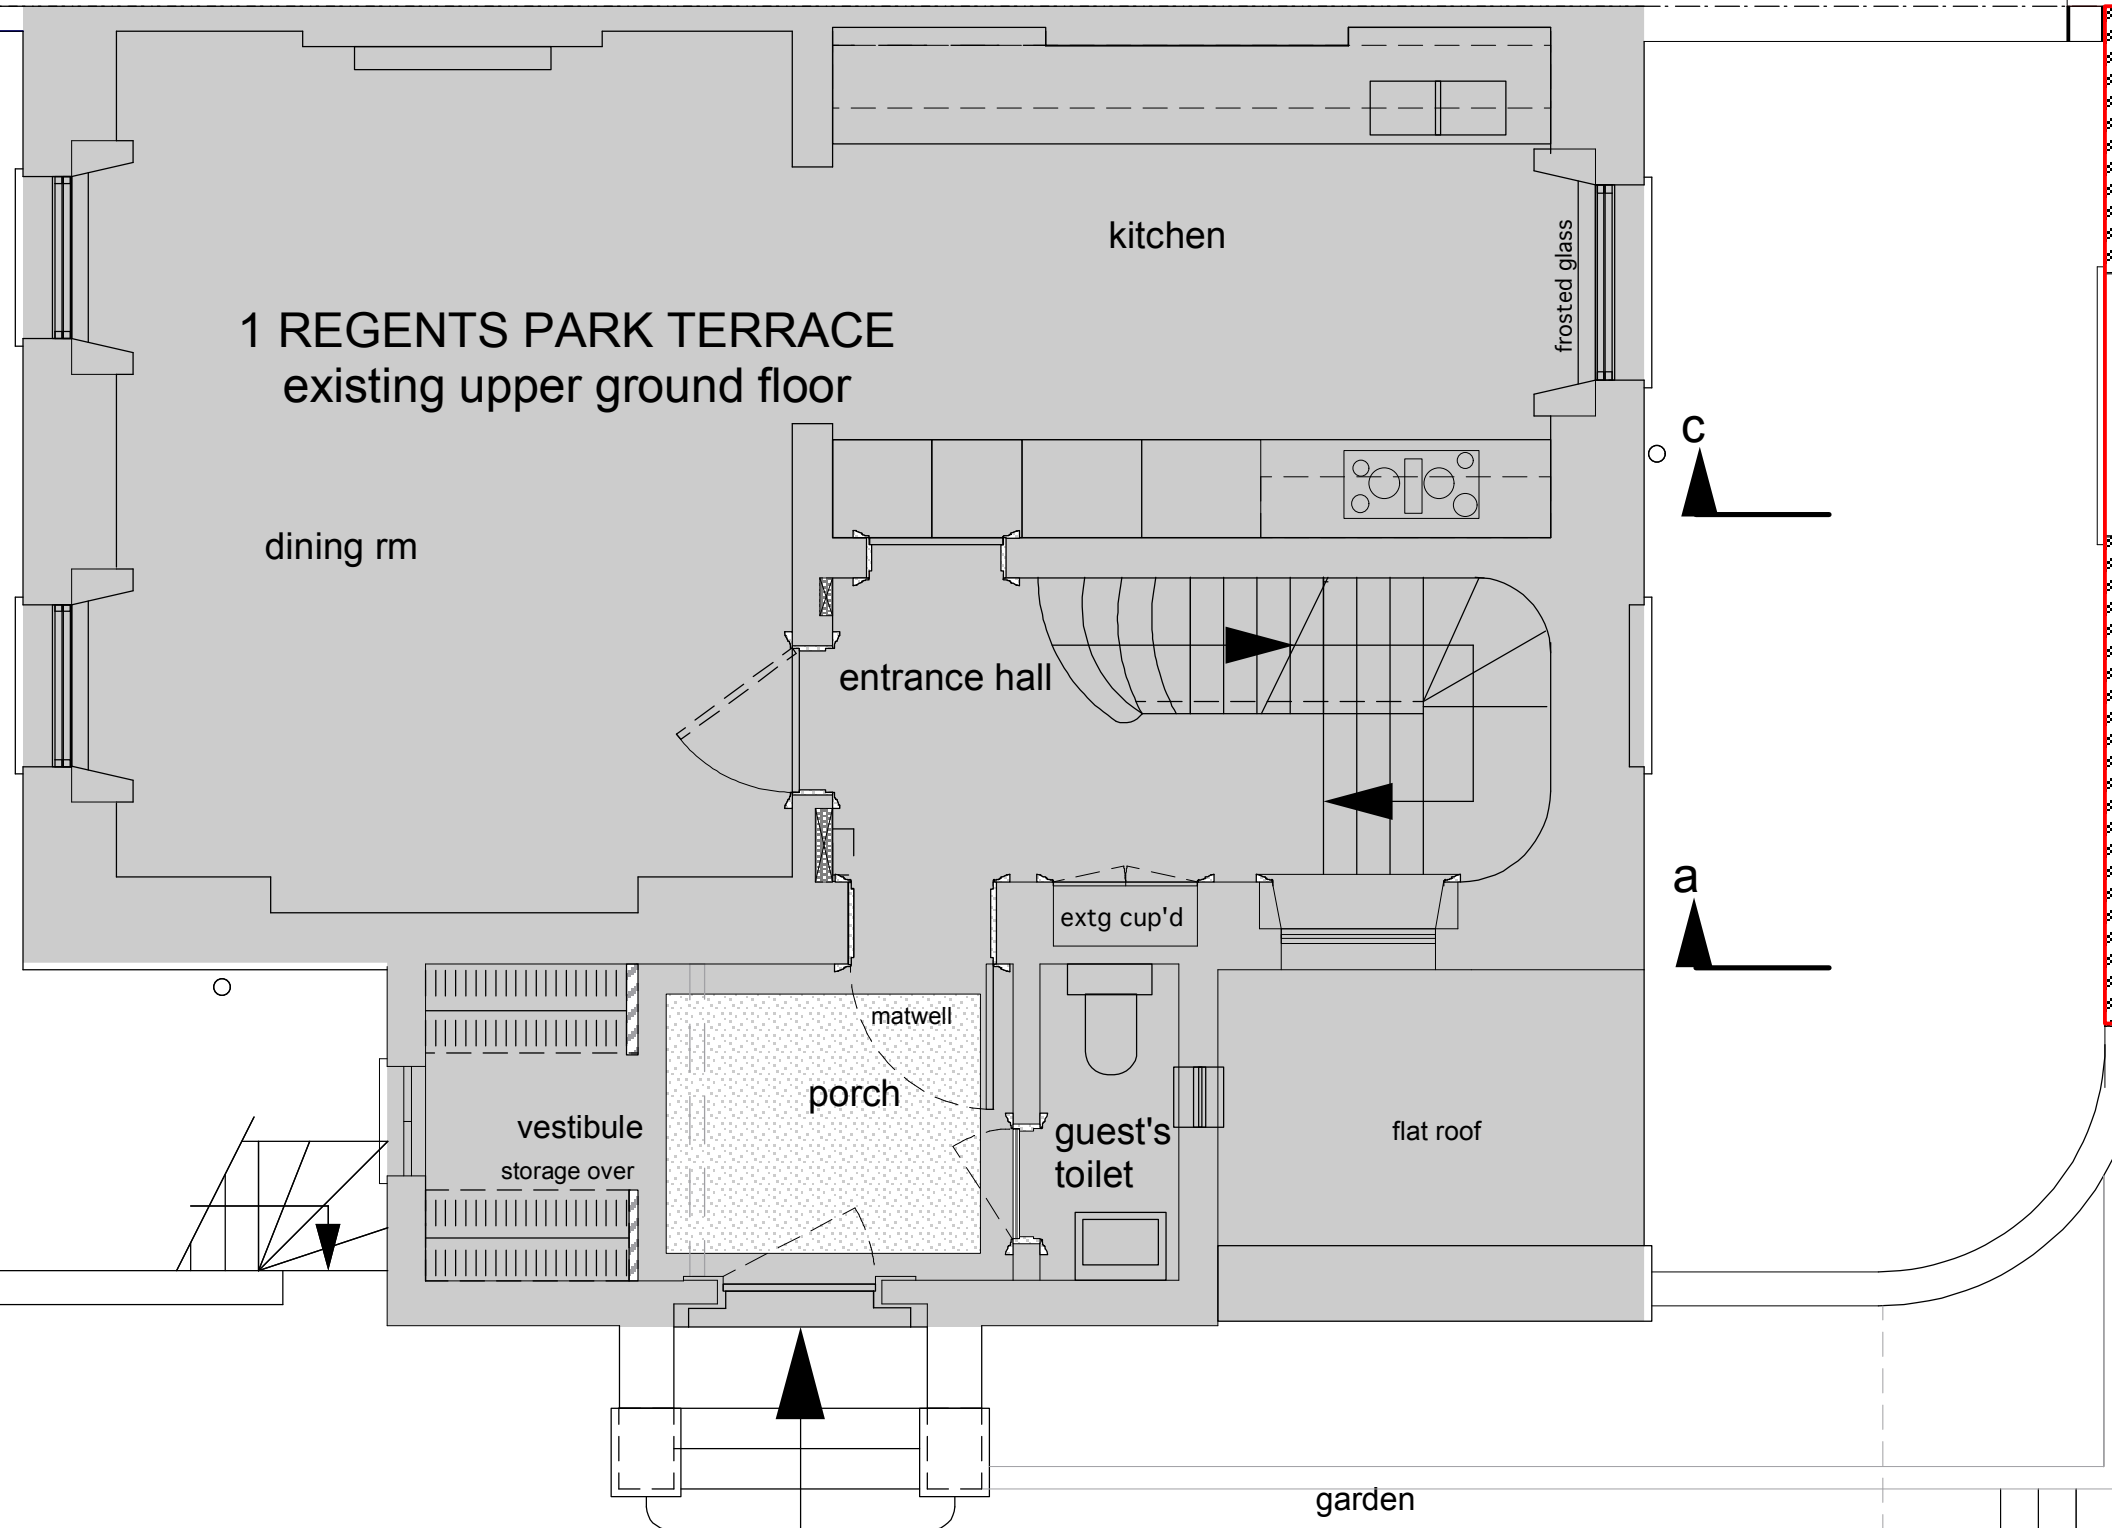

OFF STREET PRIVATE PARKING

No	revisions	date
- project title		
1 Rengent's Park Terrace London NW1 7EE		
- drawing title		
Upper Ground Floor Plan as built		
- client		
Dr K. A. Miszkjel		
- scale		
1 : 50 @ A3		date
		20May:13

drwg no : 1107 - 613 - 02

miltiadou design associates ltd
27 Wyatt Road, Highbury, London N5 2JU
t: +44(0)20 7704 0299 & (0)7873 314 733
e: msmda@btinternet.com

notes :
* all dimensions must be checked on site
* inform miltiadou design of any discrepancies prior to construction.
* the drawing and any details therein
© remain the copyright of miltiadou design associates ltd

Paper Scale in 1:50

