


Main Building

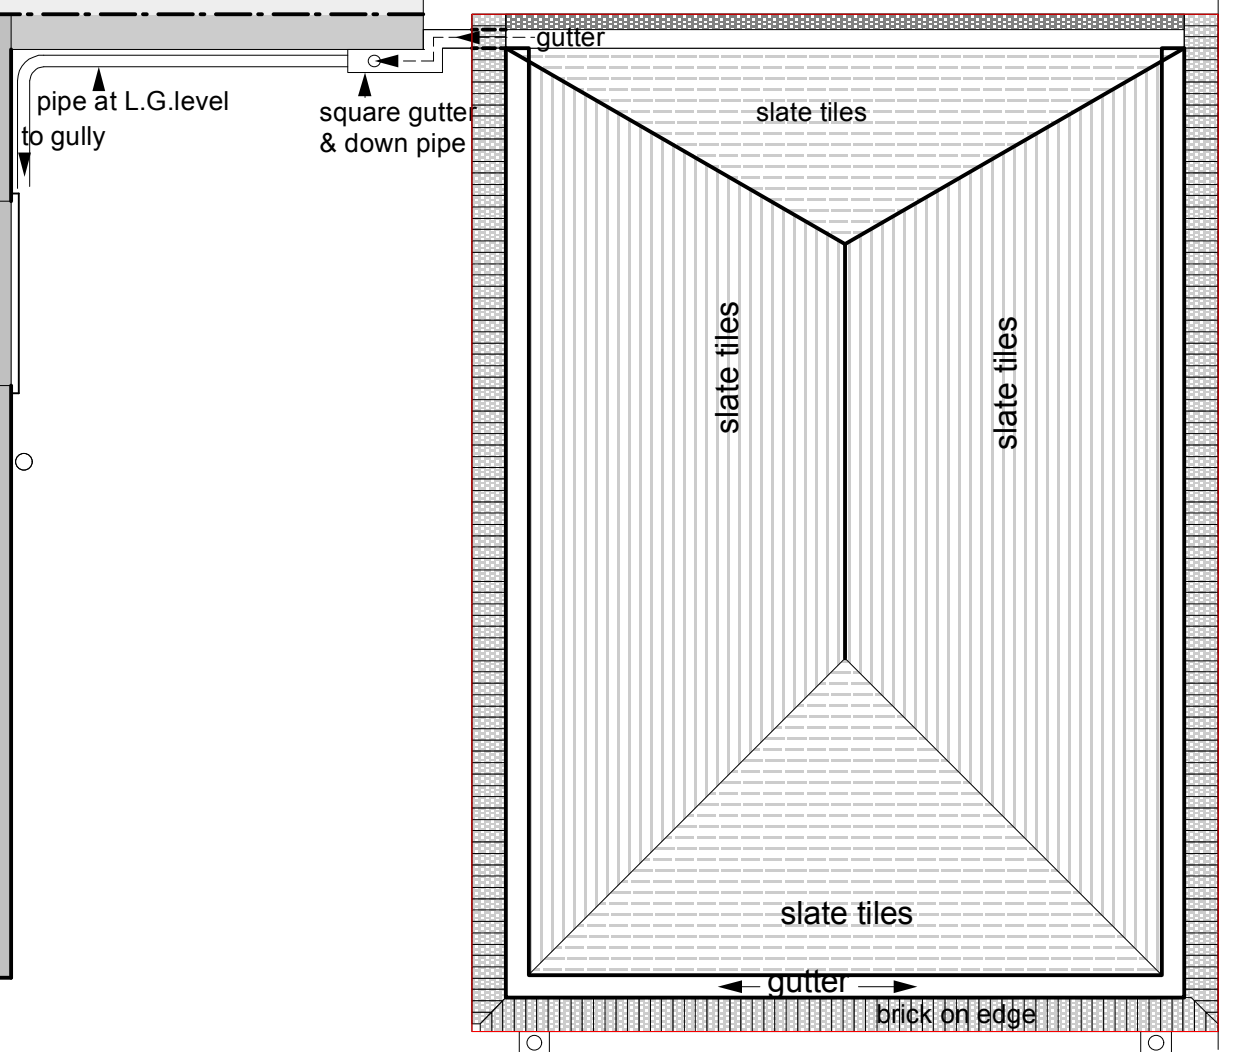

Annex

g	As-built submission for variation to condition 3 attached to Planning Application Ref 2013/7124/P	21/03/2016
f	Change of Use - Planning Application Submission	20/12/2015
e	Hopper head from rear gutter indicated	14.01.15
d	scale & s/s tie rail added	17/12/13
c	roof line & parapets modified	11/12/13
b	box gutter repositioned and roof line adjusted	16/10/13
a	Final scheme	12/06/13

No	revisions	date
----	-----------	------

- project title

1 Regent's Park Terrace
London NW1 7EE

- drawing title
as Built
roof plan

- client
Dr K. A. Miszkiel

- scale
1 : 50 @ A3

- date
20May:13

drwg no : 1107 -S13 - 03

miltiadou design associates ltd
27 Wyatt Road, Highbnury, London N5 2JU
t: +44(0)20 7704 0299 & (0)7873 314 733
e: msmda@btinternet.com

notes :
* all dimensions must be checked on site
* inform miltiadou design of any discrepancies prior to construction.
* the drawing and any details therein remain the copyright of miltiadou design associates ltd

Paper Scale in 1:50

