


1 Regent's Pk Terrace
 main building

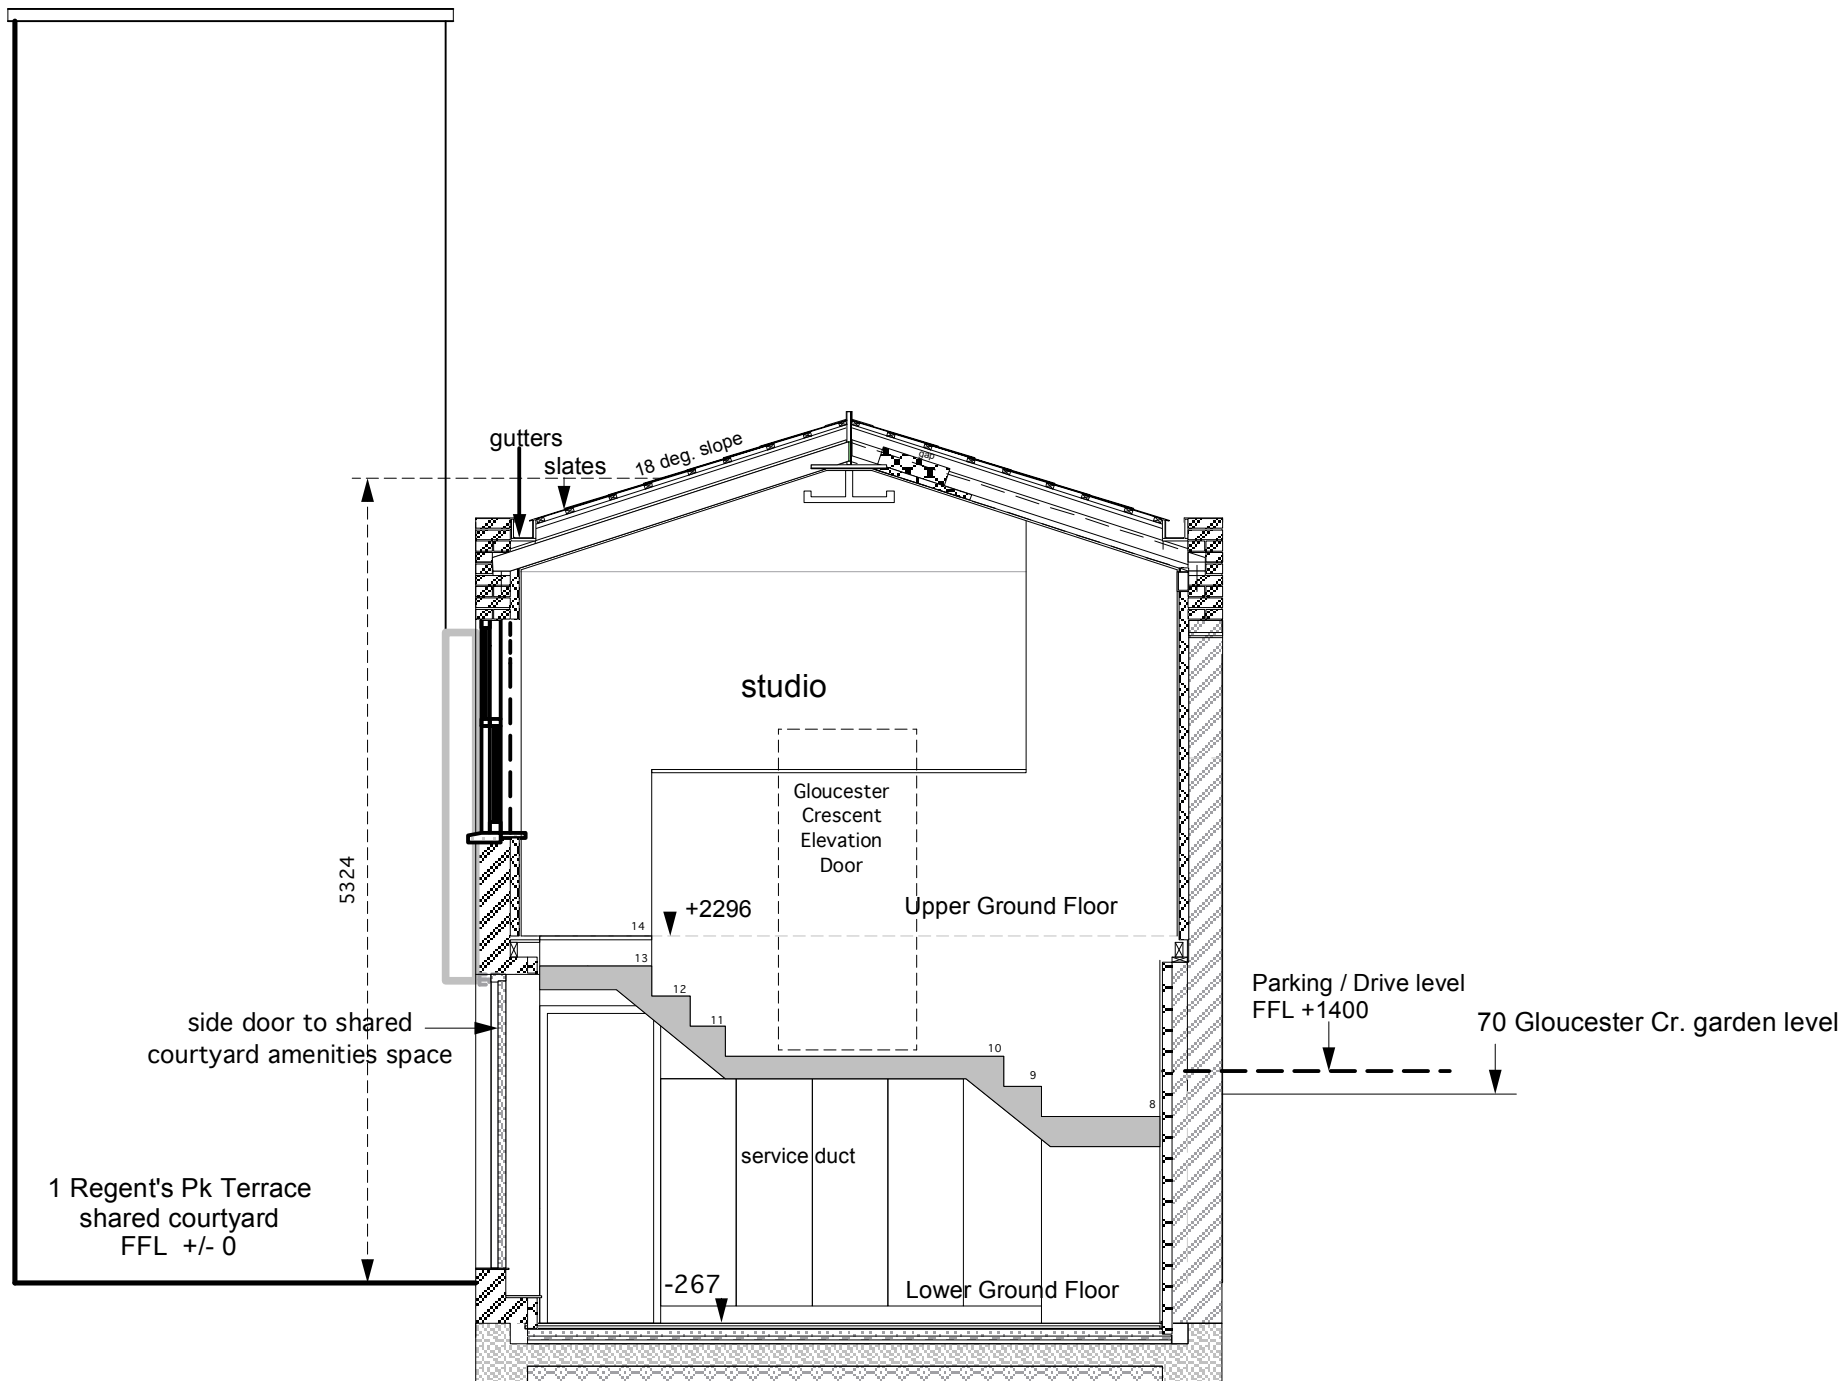

e	As-built submission for variation to condition 3 attached to Planning Application Ref 2013/7124/P	21/03/2016
d	Change of Use - Planning Application Submission	20/12/2015
c	Lobby, stairs, heights, courtyard entrance amended	21/07/14
b	excavation progress dims added	10/07/14
a	Scale added	17/12/13

No	revisions	date
----	-----------	------

- project title
 1 Regent's Park Terrace
 London NW1 7EE

- drawing title
as Built
section a - a

- client
 Dr K. A. Miszkial


- scale
 1 : 50 @ A3

date
 20May:13

drwg no : 1107 - S13- 11

miltiadou design associates ltd
 27 Wyatt Road, Highbnury, London N5 2JU
 t: +44(0)20 7704 0299 & (0)7873 314 733
 e: msmda@btinternet.com

notes :
 * all dimensions must be checked on site
 * inform miltiadou design of any discrepancies prior to construction.
 * the drawing and any details therein remain the copyright of miltiadou design associates ltd

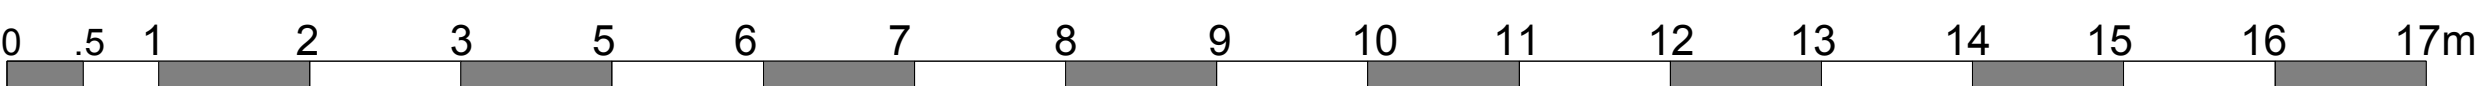

Graphic Scale