


1 Regent's Pk Terrace  
 main building

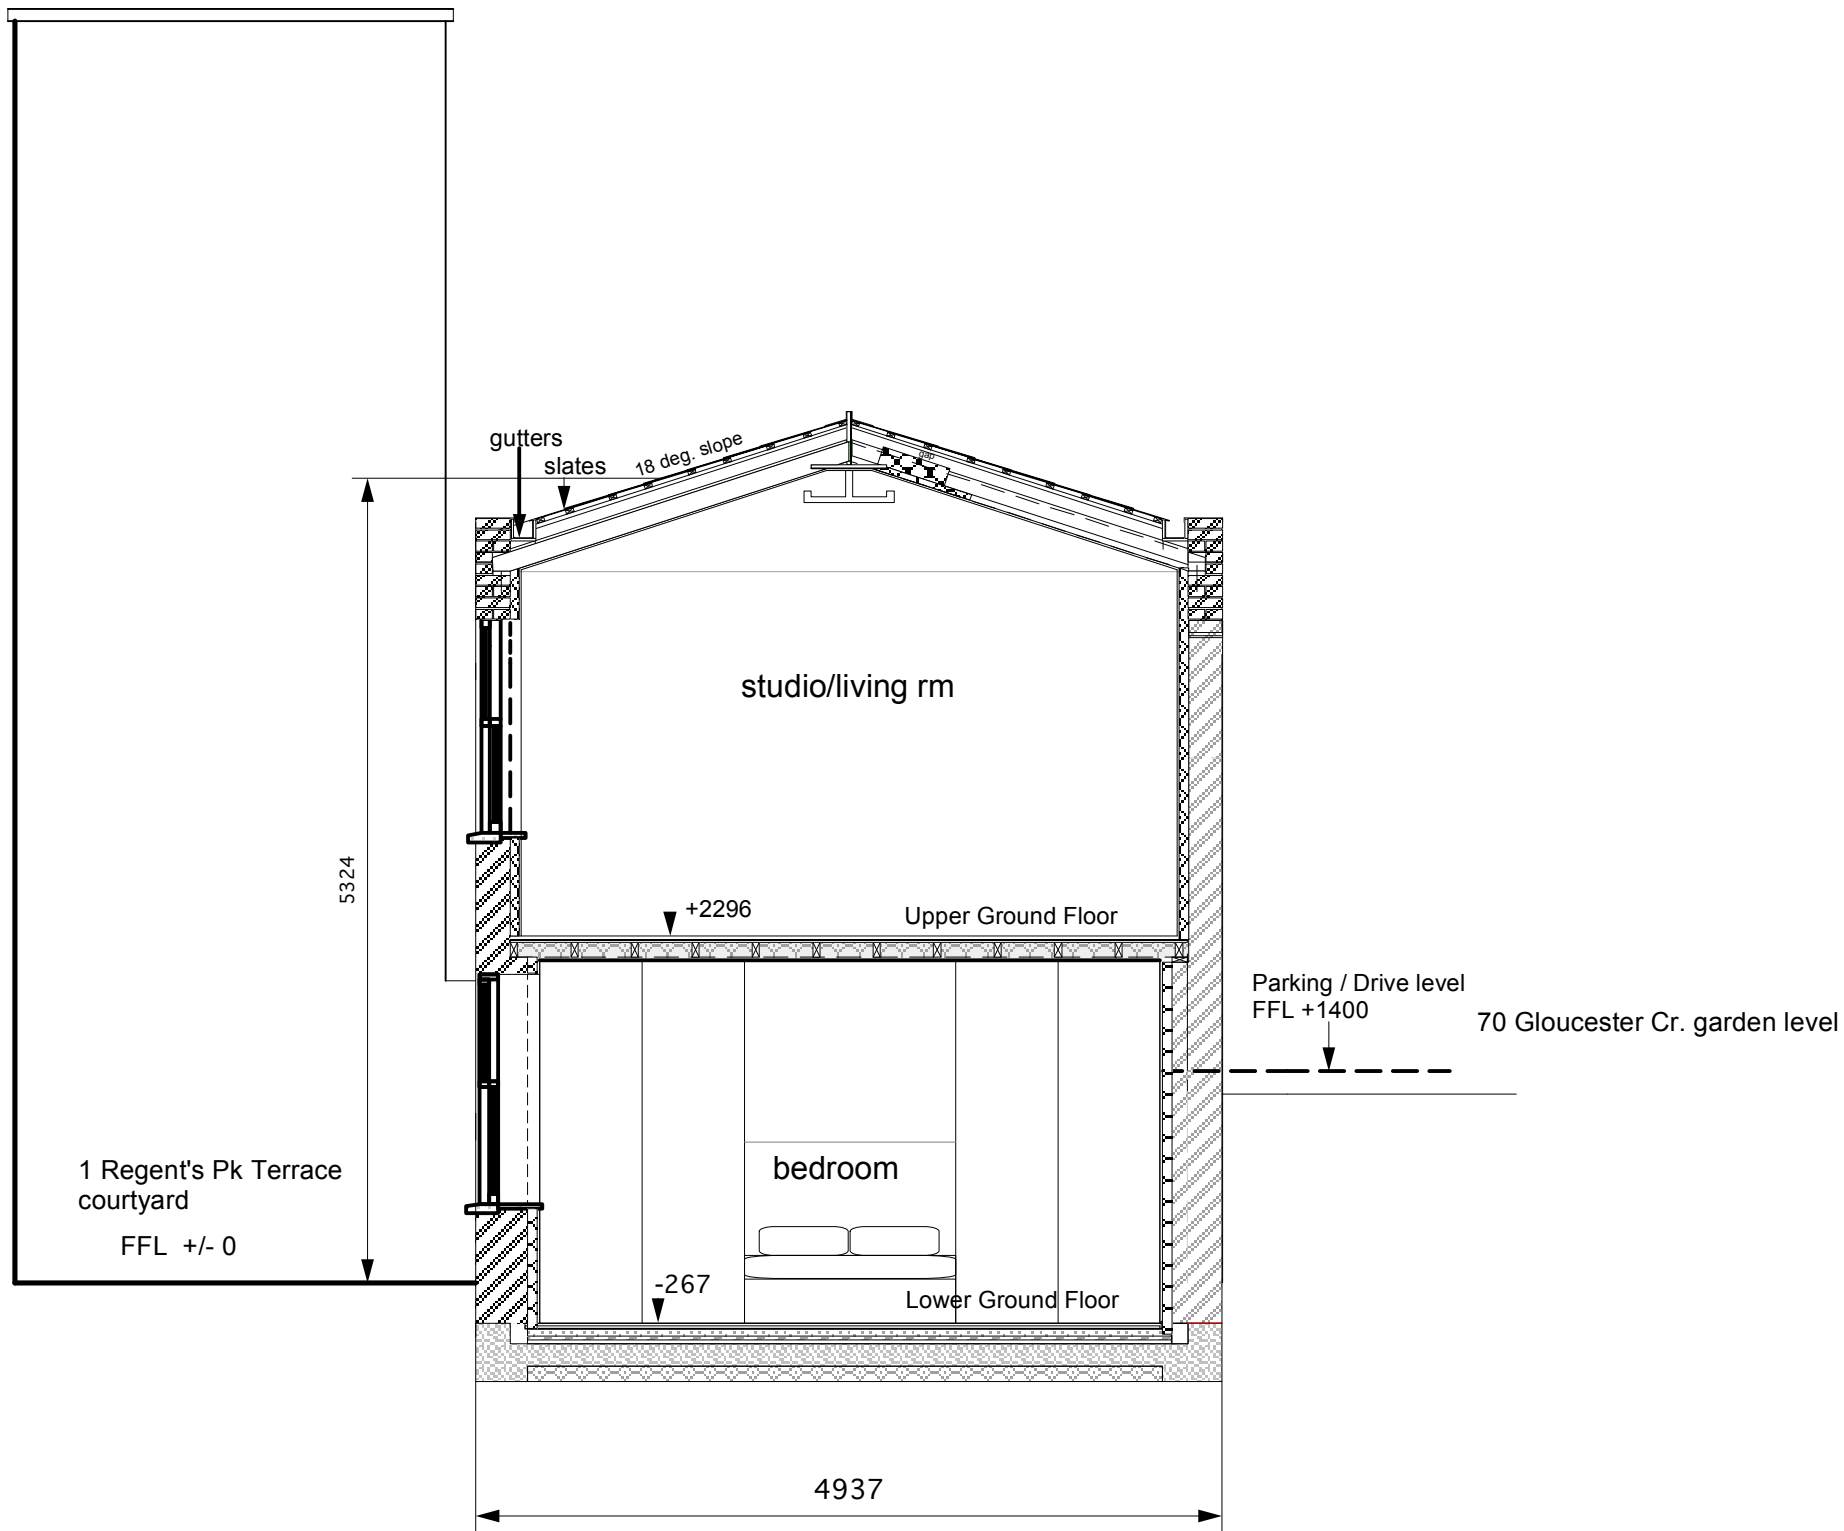

e	As-built submission for variation to condition 3 attached to Planning Application Ref 2013/7124/P	21/03/2016
d	Change of Use - Planning Application Submission	20/12/2015
c	Lobby, stairs, heights, courtyard entrance amended	21/07/14
b	excavation progress dims added	10/07/14
a	Scale added	17/12/13

No	revisions	date
----	-----------	------

- project title

1 Regent's Park Terrace  
 London NW1 7EE

- drawing title

section c - c

- client

Dr K. A. Miszkial

- scale

1 : 50 @ A3

date

20May:13

drwg no : 1107 - S13- 13

miltiadou design associates ltd  
 27 Wyatt Road, Highbnury, London N5 2JU  
 t: +44(0)20 7704 0299 & (0)7873 314 733  
 e: msmda@btinternet.com

notes :  
 \* all dimensions must be checked on site  
 \* inform miltiadou design of any discrepancies prior to construction.  
 \* the drawing and any details therein remain the copyright of miltiadou design associates ltd

