




1 REGENT'S PARK TERRACE

2 REGENT'S PARK TERRACE

North East Elevation

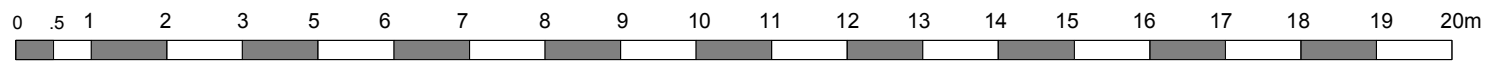

Scale 1: 100

f	As-built submission for variation to condition 3 attached to Planning Application Ref 2013/7124/P	21/03/2016
g	Change of Use - Planning Submission	19/12/15
f	roof slope to 2 RPT amended to retain existing angle of light	02/01/14
e	scale added	17/12/13
d	roofline and parapet amended	10/12/13
c	Gutters relocated & roof line adjusted	16/10/13
b	Final scheme	12/06/13
a	No 2 RPT details indicated	21/5/13

No	revisions	date
- project title		
1 Regent's Park Terrace London NW1 7EE		
- drawing title		
as Built north-east elevation		
- client		
Dr K. A. Miszkial		
- scale		
1 :100 @ A3		
date		
20May:13		

drwg no : 1107 - S13-21

miltiadou design associates ltd  
27 Wyatt Road, Highbnury, London N5 2JU  
t: +44(0)20 7704 0299 & (0)7873 314 733  
e: msmda@btinternet.com

notes :  
\* all dimensions must be checked on site  
\* inform miltiadou design of any discrepancies prior to construction.  
\* the drawing and any details therein remain the copyright of miltiadou design associates ltd